
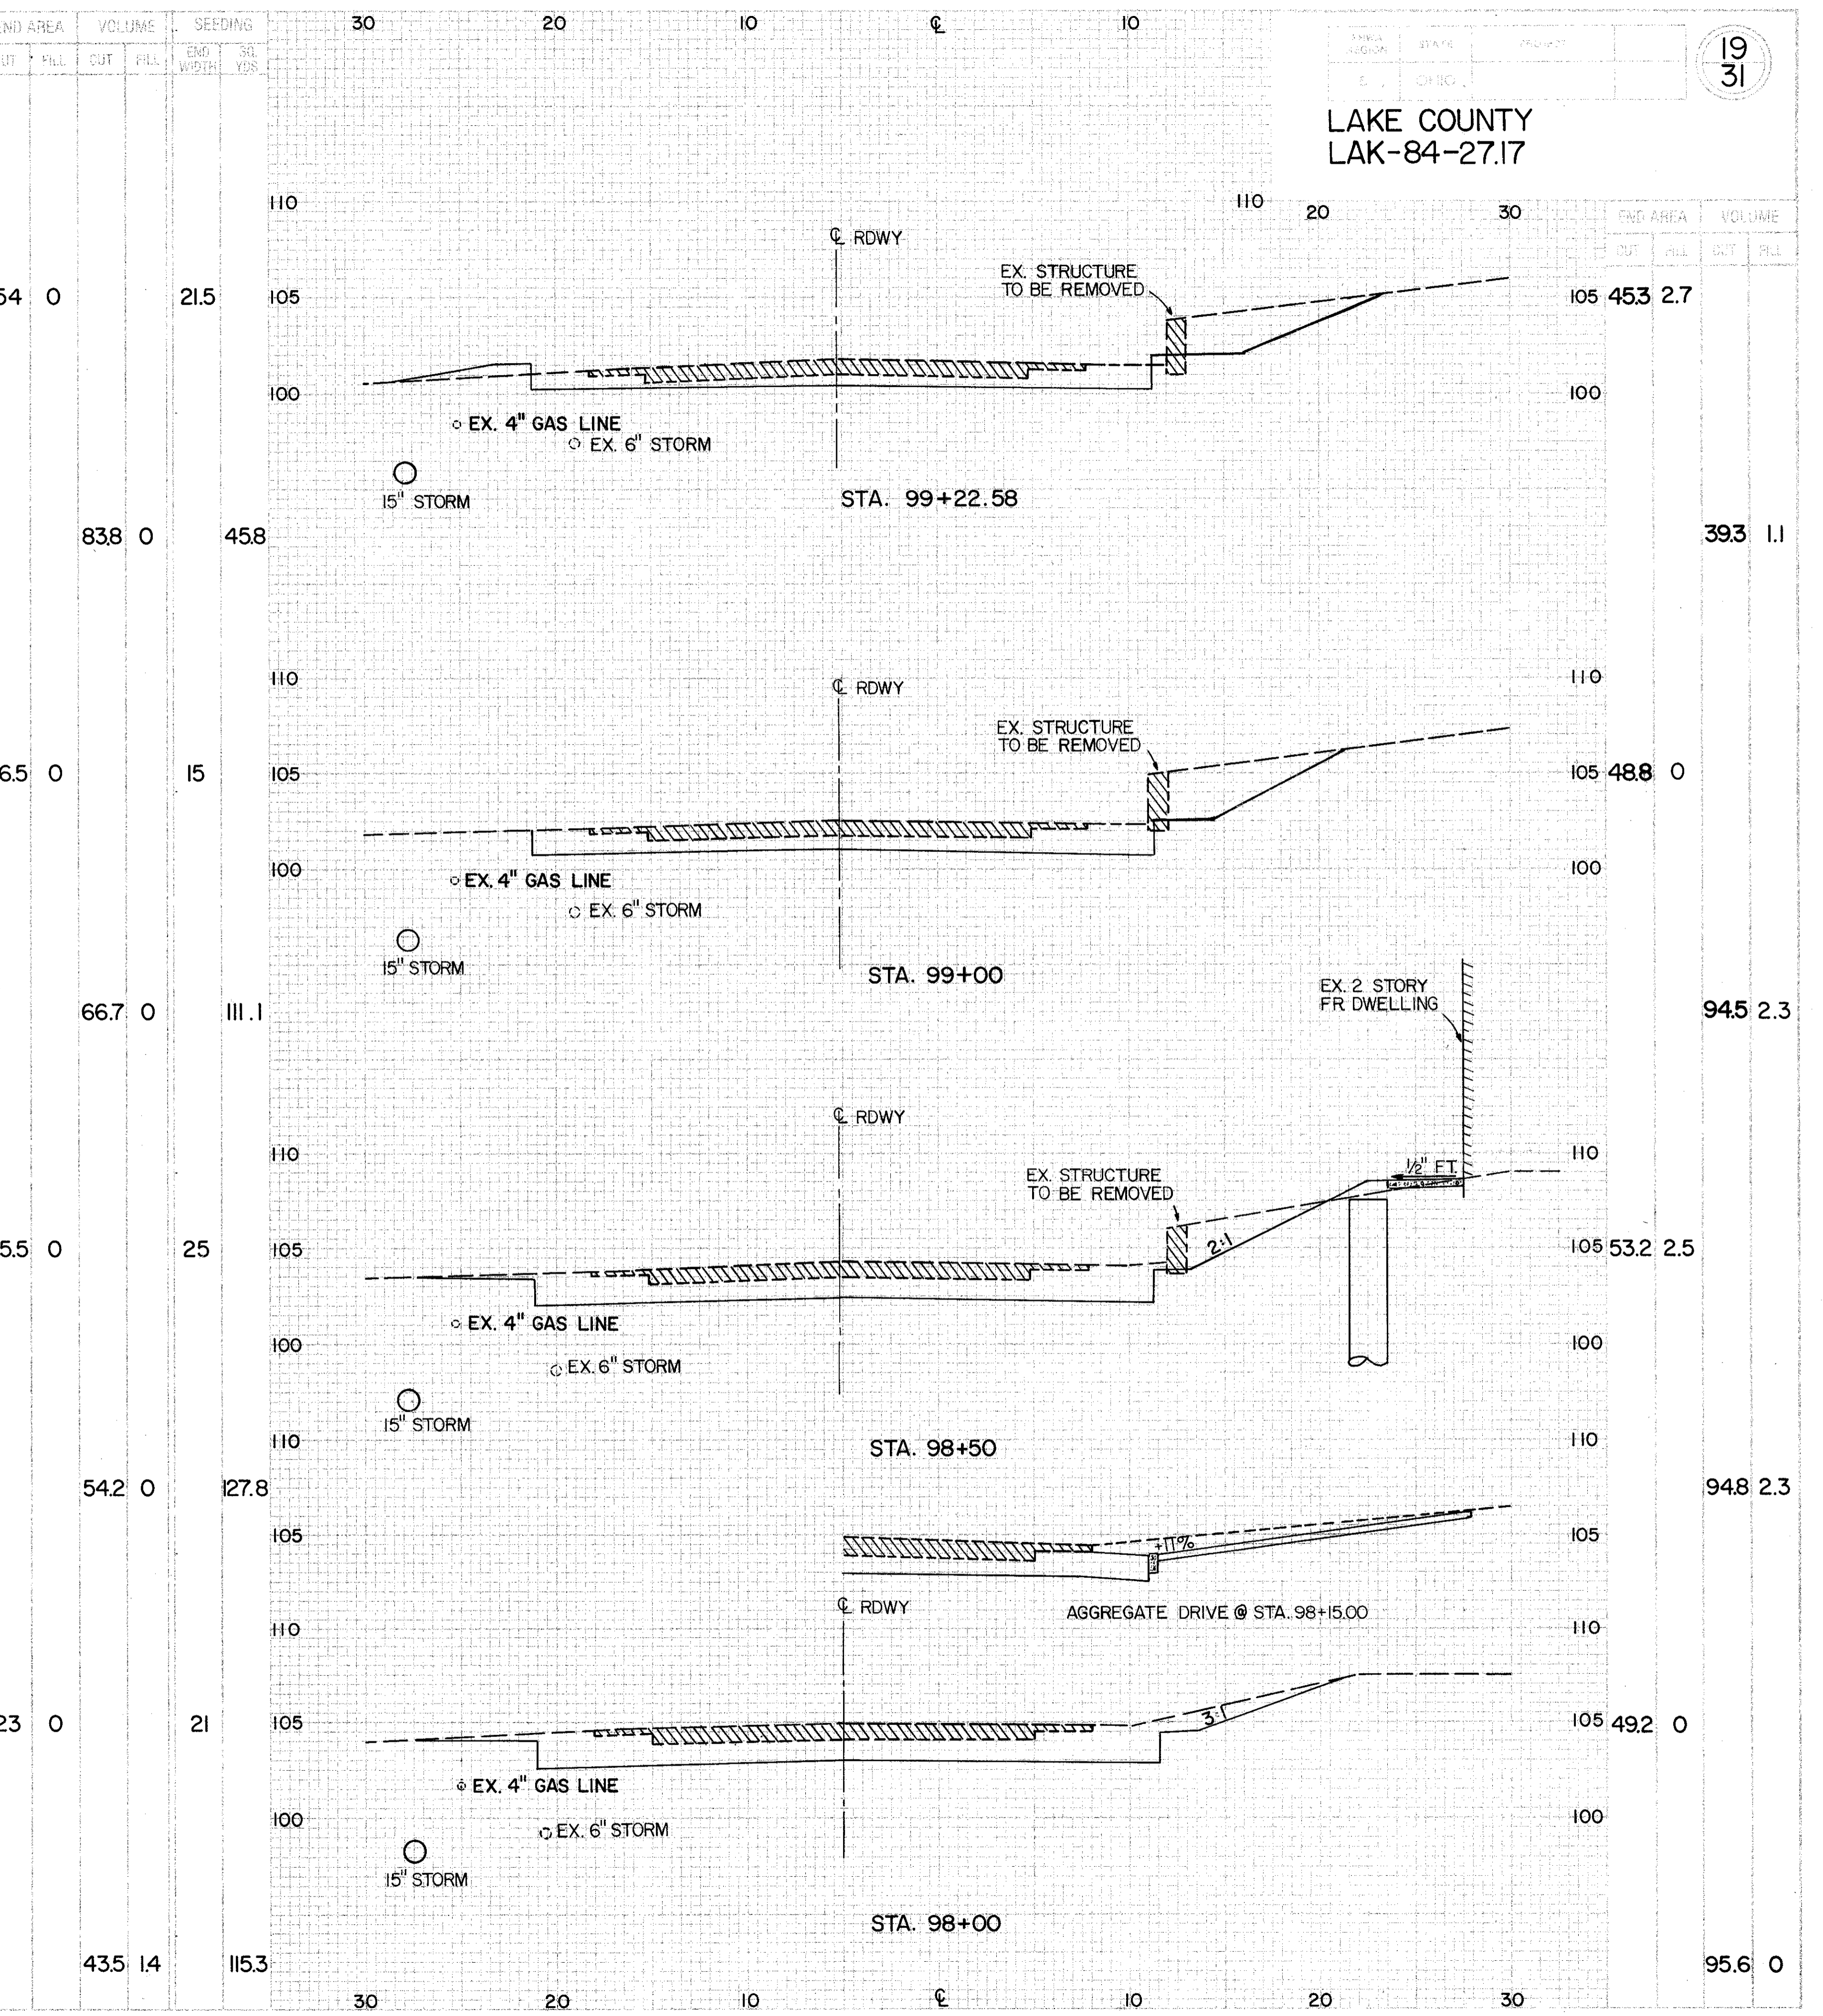


JUL 1 1988

LAKE COUNTY
LAK-84-27.17

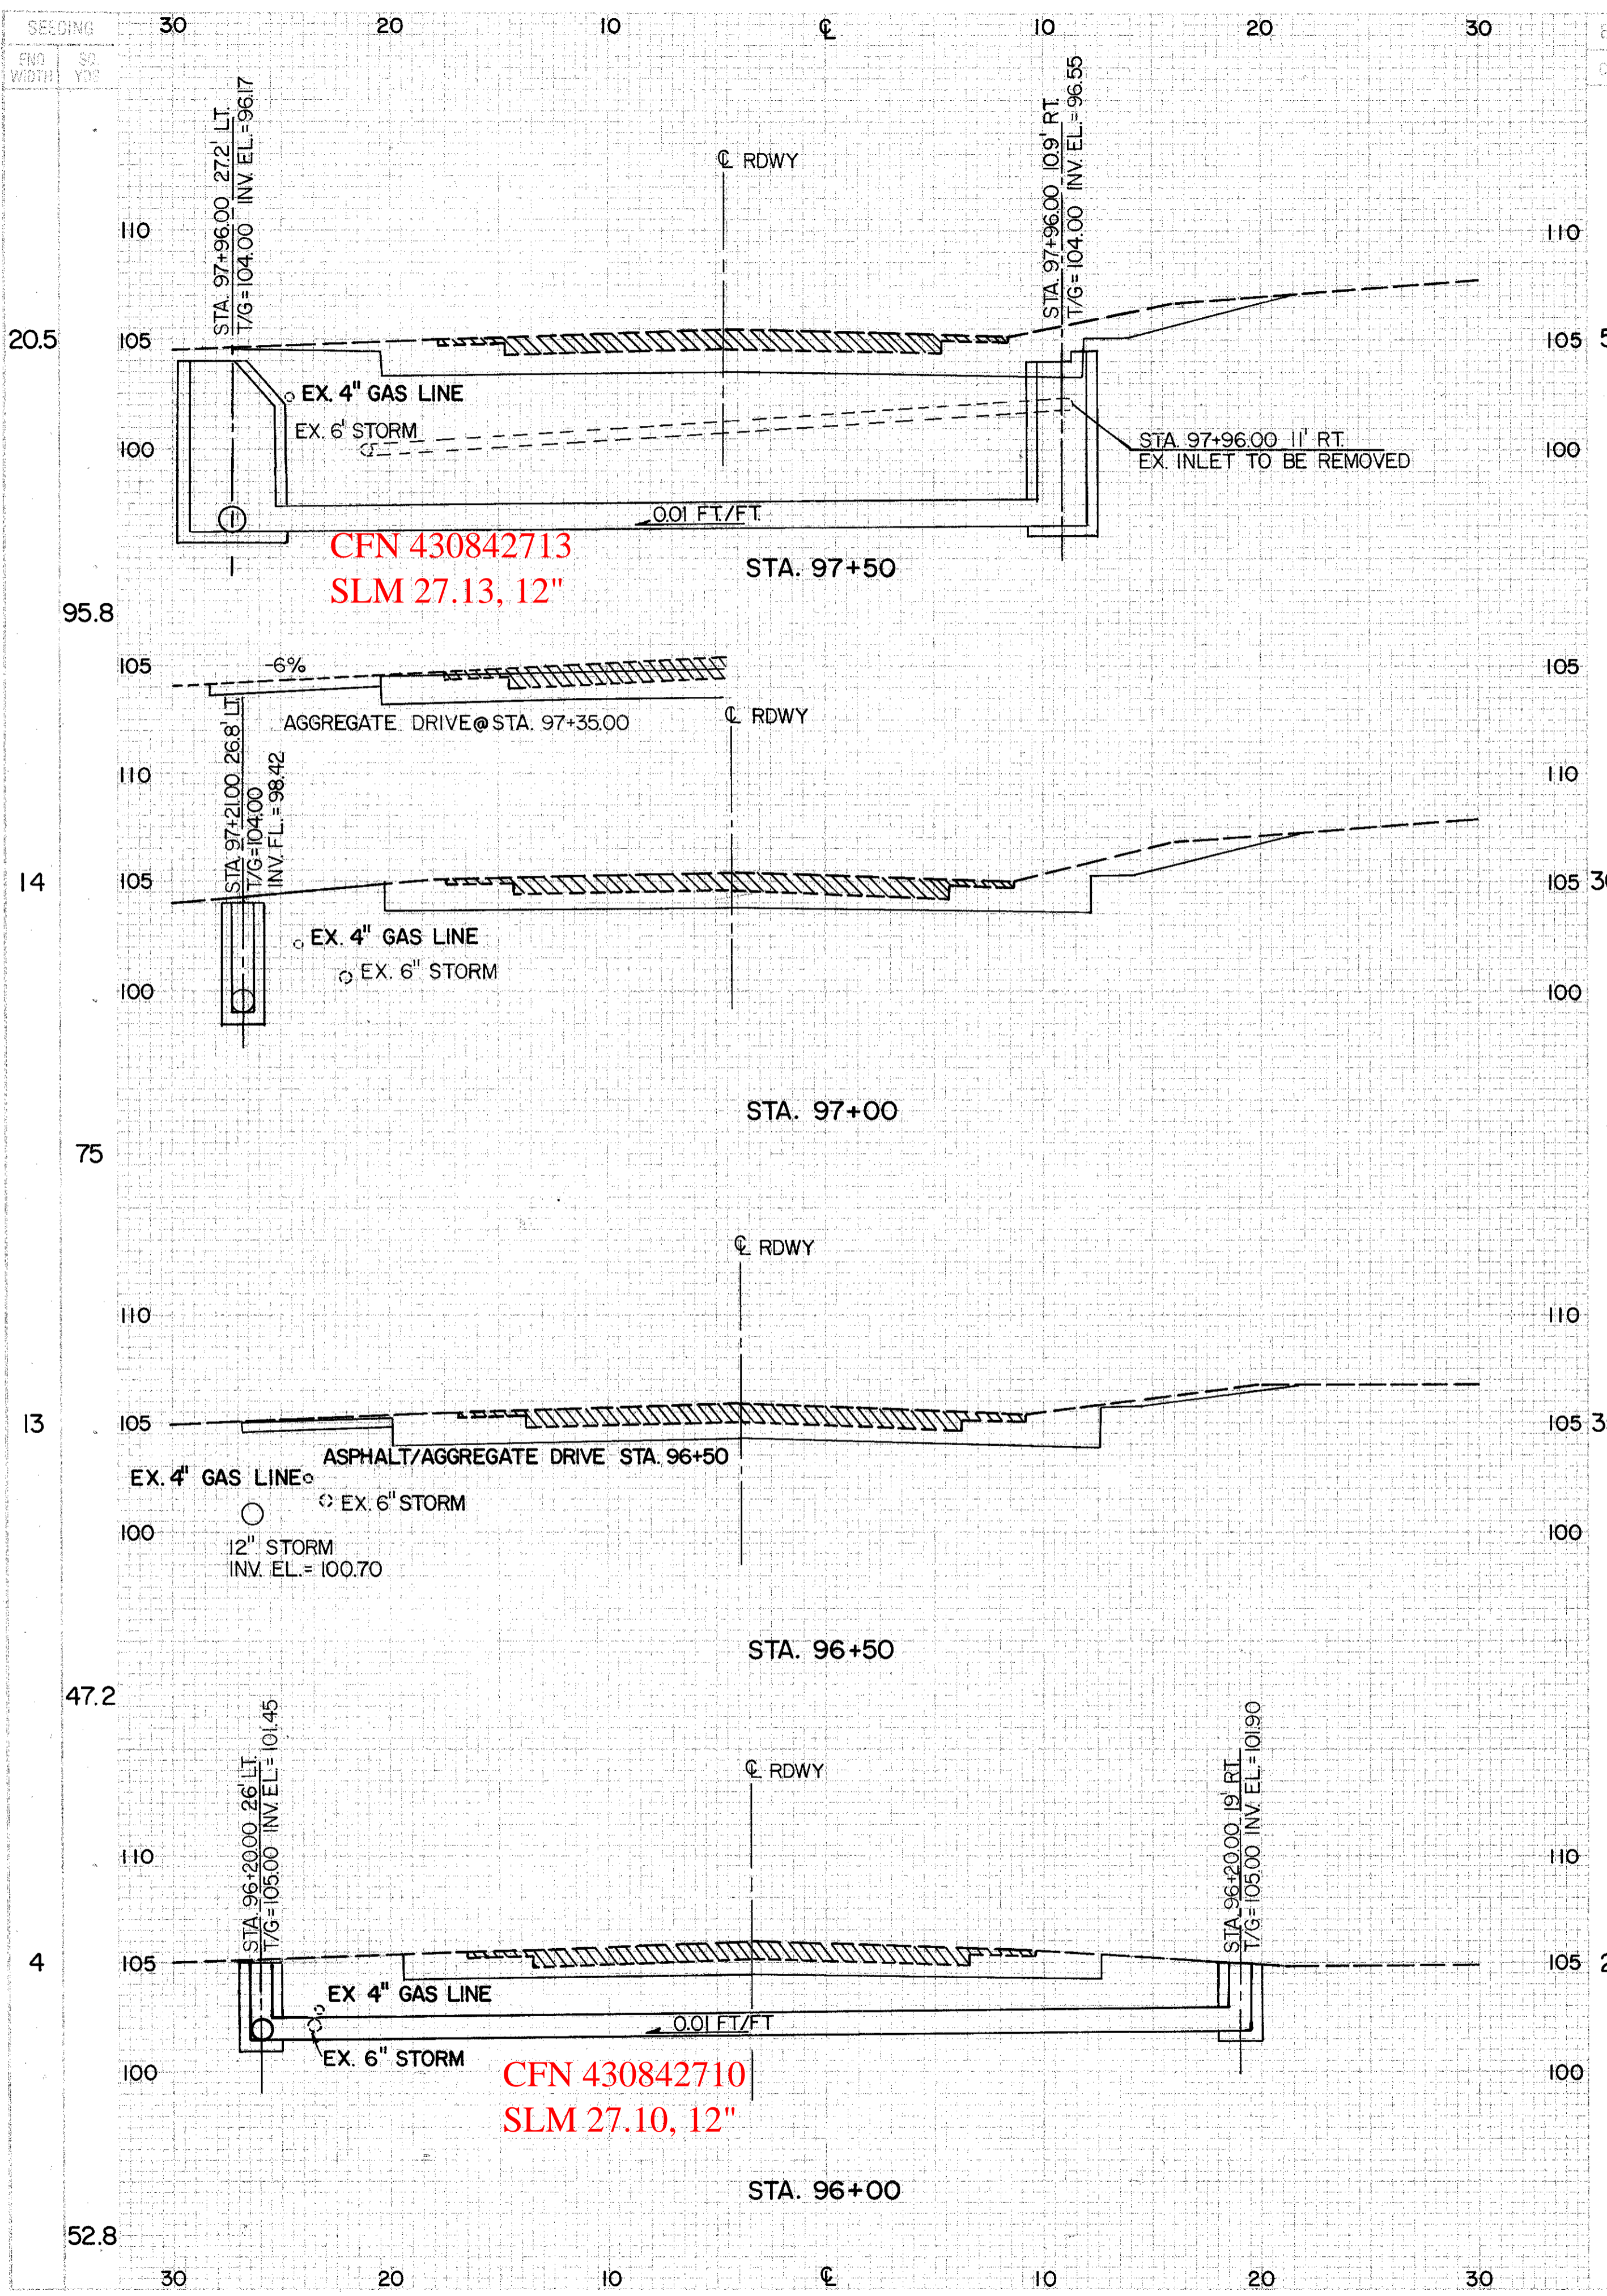

END AREA	VOLUME		SEEDING
	CUT	FILL	
54	0	21.5	
838	0	458	
36.5	0	15	
66.7	0	111.1	
35.5	0	25	
54.2	0	127.8	
23	0	21	
43.5	14	115.3	

PAVED AREA	VOLUME	
	CUT	FILL
453	2.7	
393	1.1	
488	0	
945	2.3	
532	2.5	
948	2.3	
492	0	
95.6	0	