
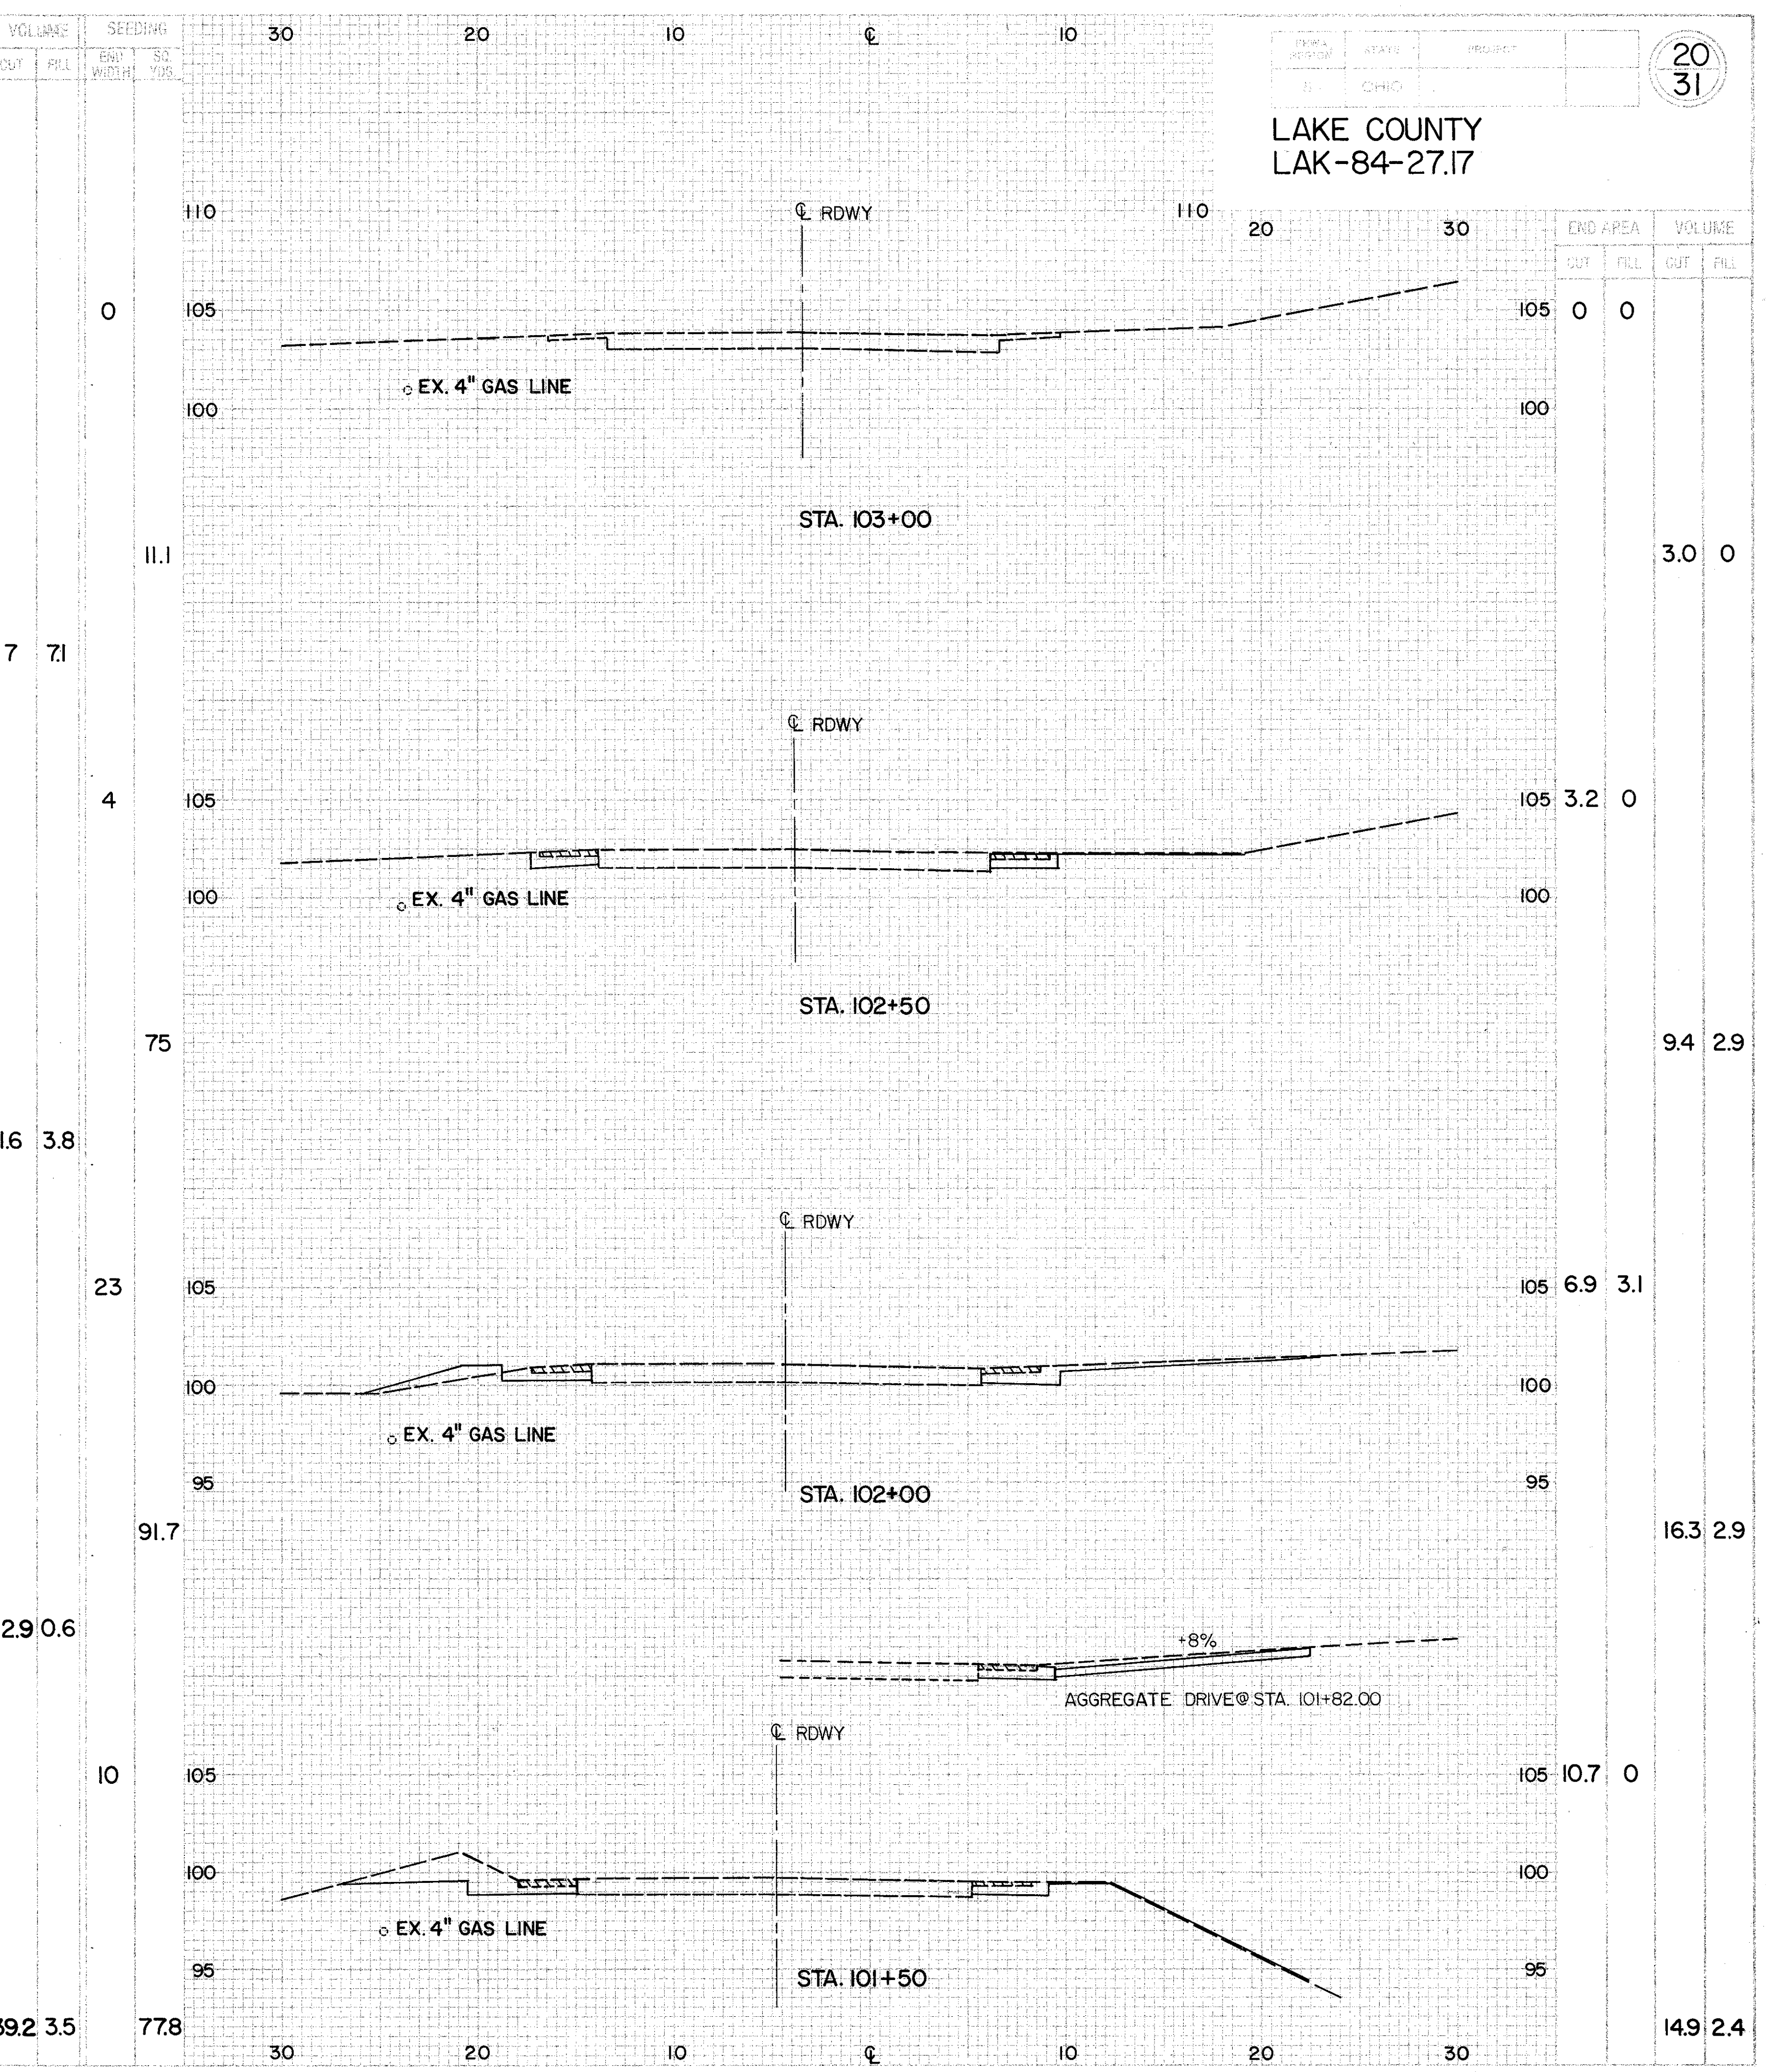


JUL 1 1988

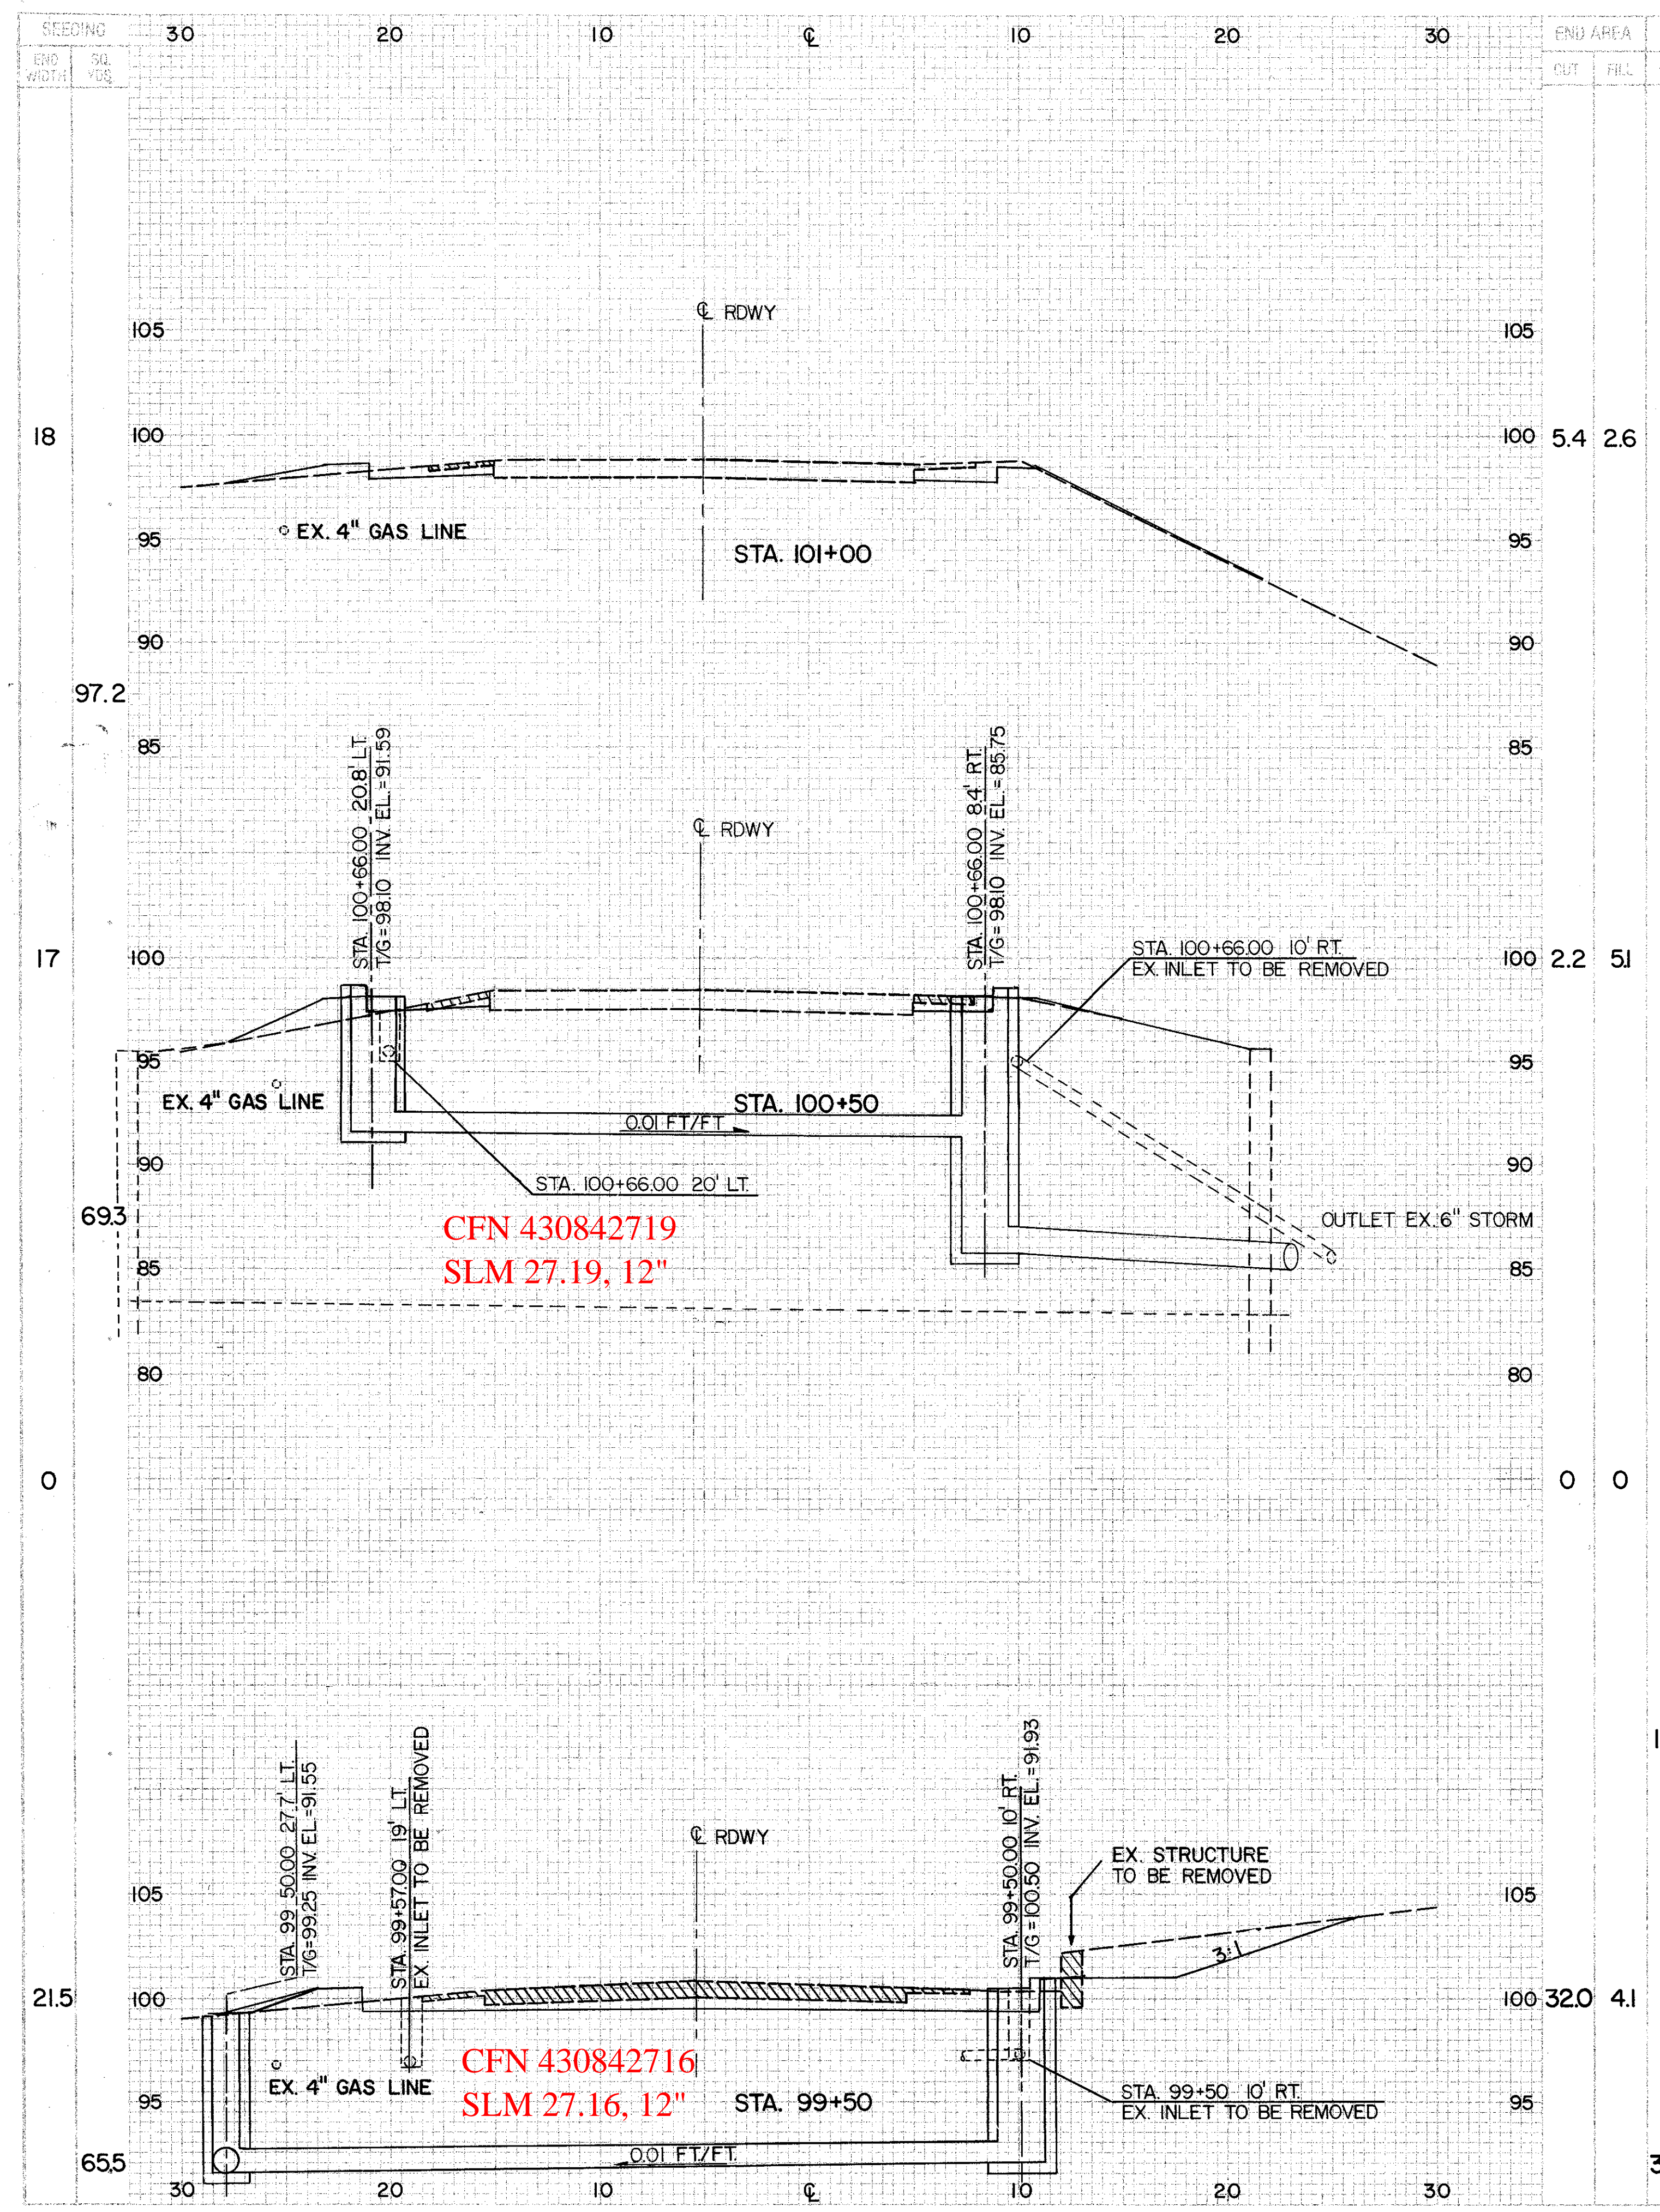

S.R. 84 X-SECTIONS STA. 99+50 TO STA. 103+00