


SEEDING
END SQ.
WIDTH YDS.

CUYAHOGA COUNTY
CUY- 42-3.38

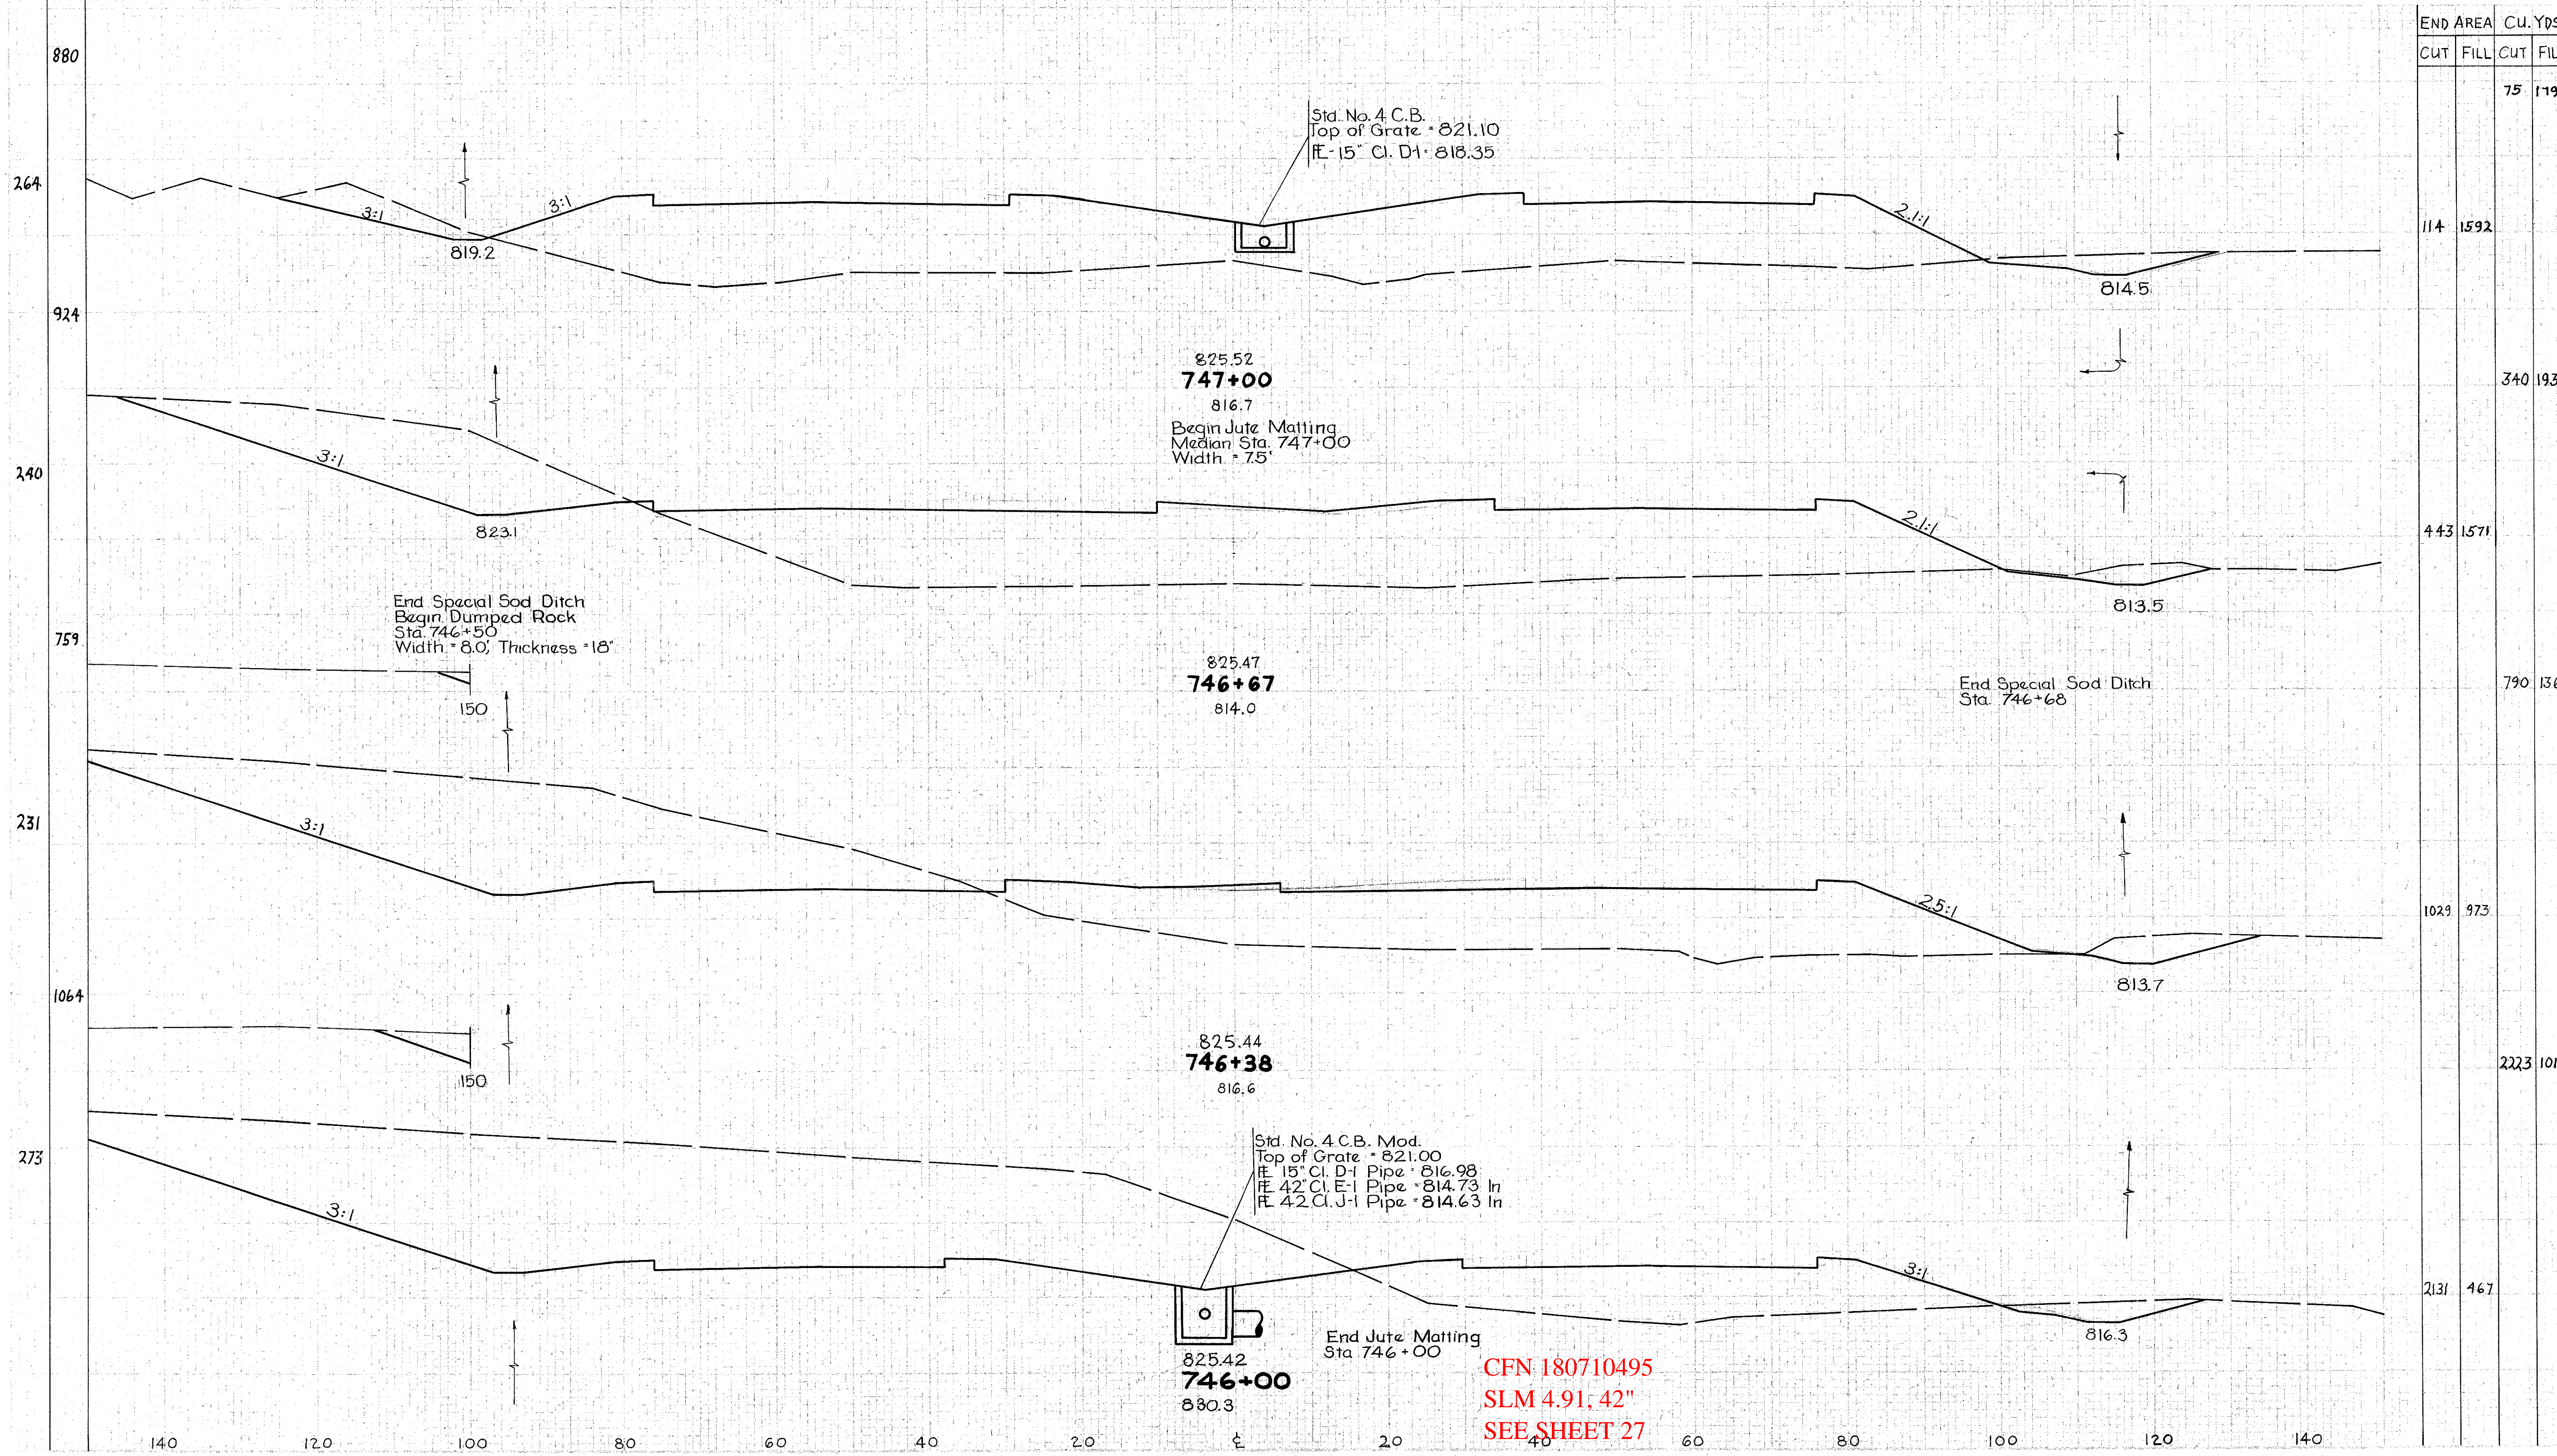

Std. No. 4 C.B.
Top of Grate = 821.10
15" Cl. D1 = 818.35

825.52
747+00
816.7
Begin Jute Matting
Median Sta. 747+00
Width = 75'

End Special Sod Ditch
Begin Dumped Rock
Sta. 746+50
Width = 8.0', Thickness = 18"

825.47
746+67
814.0

End Special Sod Ditch
Sta. 746+68

825.44
746+38
816.6

Std. No. 4 C.B. Mod.
Top of Grate = 821.00
15" Cl. D1 Pipe = 816.98
42" Cl. E-1 Pipe = 814.73 In
42" Cl. J-1 Pipe = 814.63 In

825.42
746+00
830.3

End Jute Matting
Sta 746+00

CFN 180710495
SLM 4.91, 42"
SEE SHEET 27