SEE 2001 CUY-71-0.00 PLANS FOR MODIFICATIONS TO STORM SEWERS

CUYAHOGA COUNTY
CUY - 42 - 3.38

FED. RD. DIVISION	STATE	PROJECT	
2	OHIO	I-71-5(11)236	

21
263

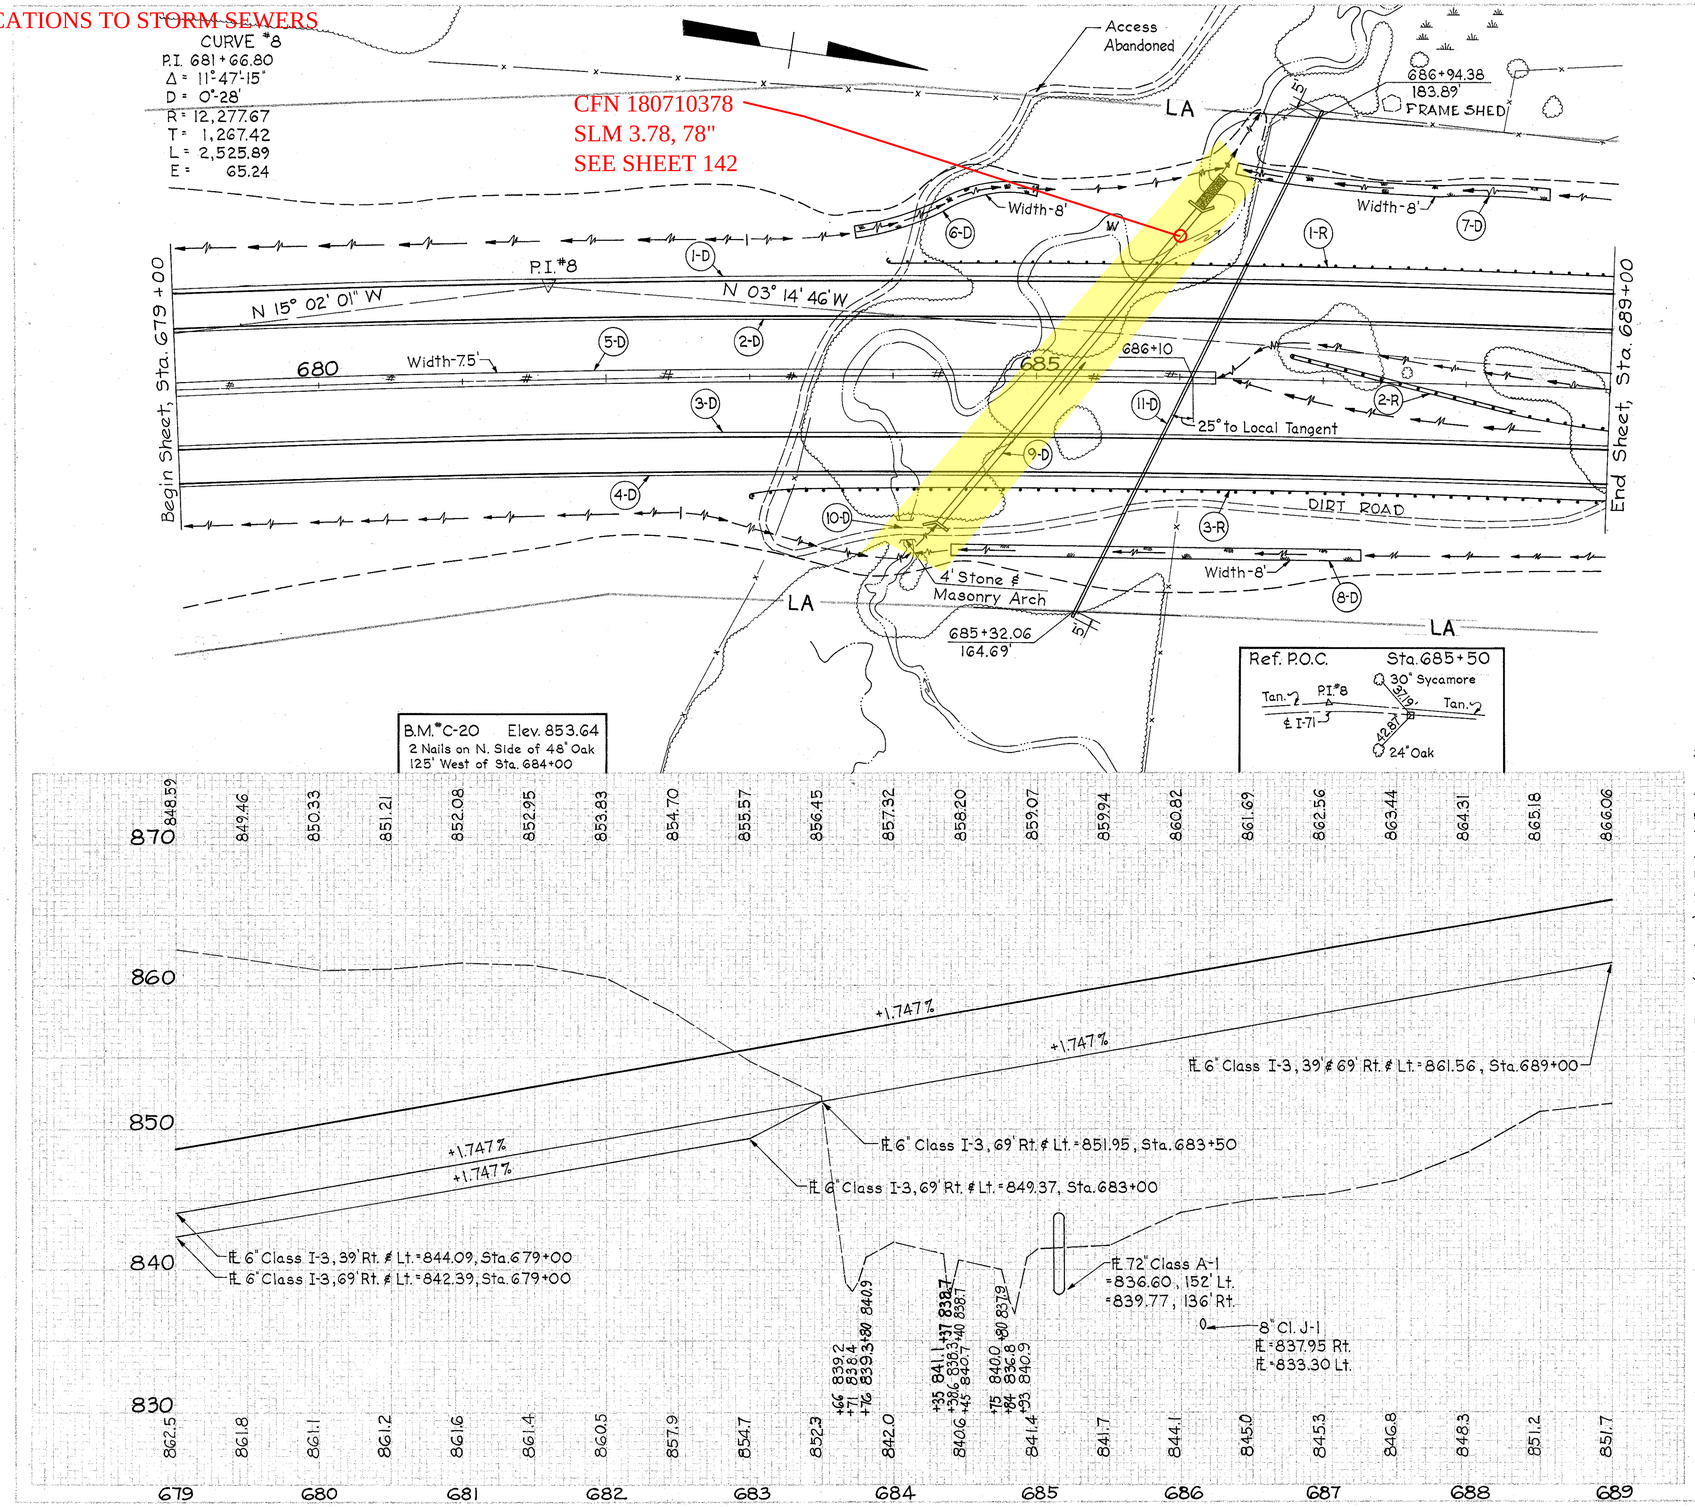

⊛ With Compression Joints, Sec. I-1.06 (Sanitary). No Federal Participation.

ESTIMATED QUANTITIES

REF. NO.	STATION TO STATION	SIDE	I-1 Class J-1 ⊛ Sec. M-68(b) 8" Lin. Ft.	I-1 Class J-1 ⊛ Sec. H-68(b) Encased 8" Lin. Ft.	I-1 Class A-1 Sec. M-66(c) 78" Lin. Ft.	I-1 Class I-3 Pipe 6" Shallow Lin. Ft.	I-1 Class I-3 Pipe 6" Deep Lin. Ft.	I-2 Masonry Headwall No. 3 Cu. Yd.	I-10 Dumped Rock Channel Protection Cu. Yd.	I-15 Guard Rail Lin. Ft.	I-15 Barrier Rail Lin. Ft.	E-3 Channel Excav. Cu. Yd.	L-10 Sodding Sq. Yd.	L-120 Jute Matting Sq. Yd.	S-24 Removal of Exist. Struct. Lump	SEE SHEET NO.
1-D	679+00 to 689+00	Lt.				600	400									
2-D	679+00 to 689+00	Lt.				1000										
3-D	679+00 to 689+00	Rt.				1000										
4-D	679+00 to 689+00	Rt.				600	400									
5-D	679+00 to 686+25	Med.												645		
6-D	683+75 to 685+00	Lt.											111			
7-D	686+30 to 688+50	Lt.											195			
8-D	684+20 to 687+25	Rt.											271			
9-D	685+15	—			290			46.6	23			74	13			142
10-D	684+10	Rt.													Lump	
11-D	686+10	—	173	223												
1-R	684+00 to 689+00	Lt.								500						
2-R	686+79 to 689+00	Med.								71	150					
3-R	683+00 to 689+00	Rt.								600						
TOTALS			⊛173	⊛223	290	3,200	800	46.6	23	1,171	150	74	590	645	Lump	

Sta. 679+00 to Sta. 689+00