SEE 2001 CUY-71-0.00 PLANS FOR MODIFICATIONS TO STORM SEWERS

ALBION ROAD
SLM 3.84 = MM 232.55

SLM 3.88, 15"
SEE SHEET 153
SLM 3.94, 15"
SEE SHEET 45

SLM 3.95, 42"
SEE SHEET 143

OHIO TURNPIKE
SLM 3.95 = MM 232.66

SLM 3.96, 42"
SEE SHEET 143

SLM 3.95, 42"
SEE SHEET 143

CUYAHOGA COUNTY
CUY - 42 - 3.38

FED. RD. DIST. NUMBER	STATE	PROJECT
2	OHIO	I-71-5(11)236

22
263

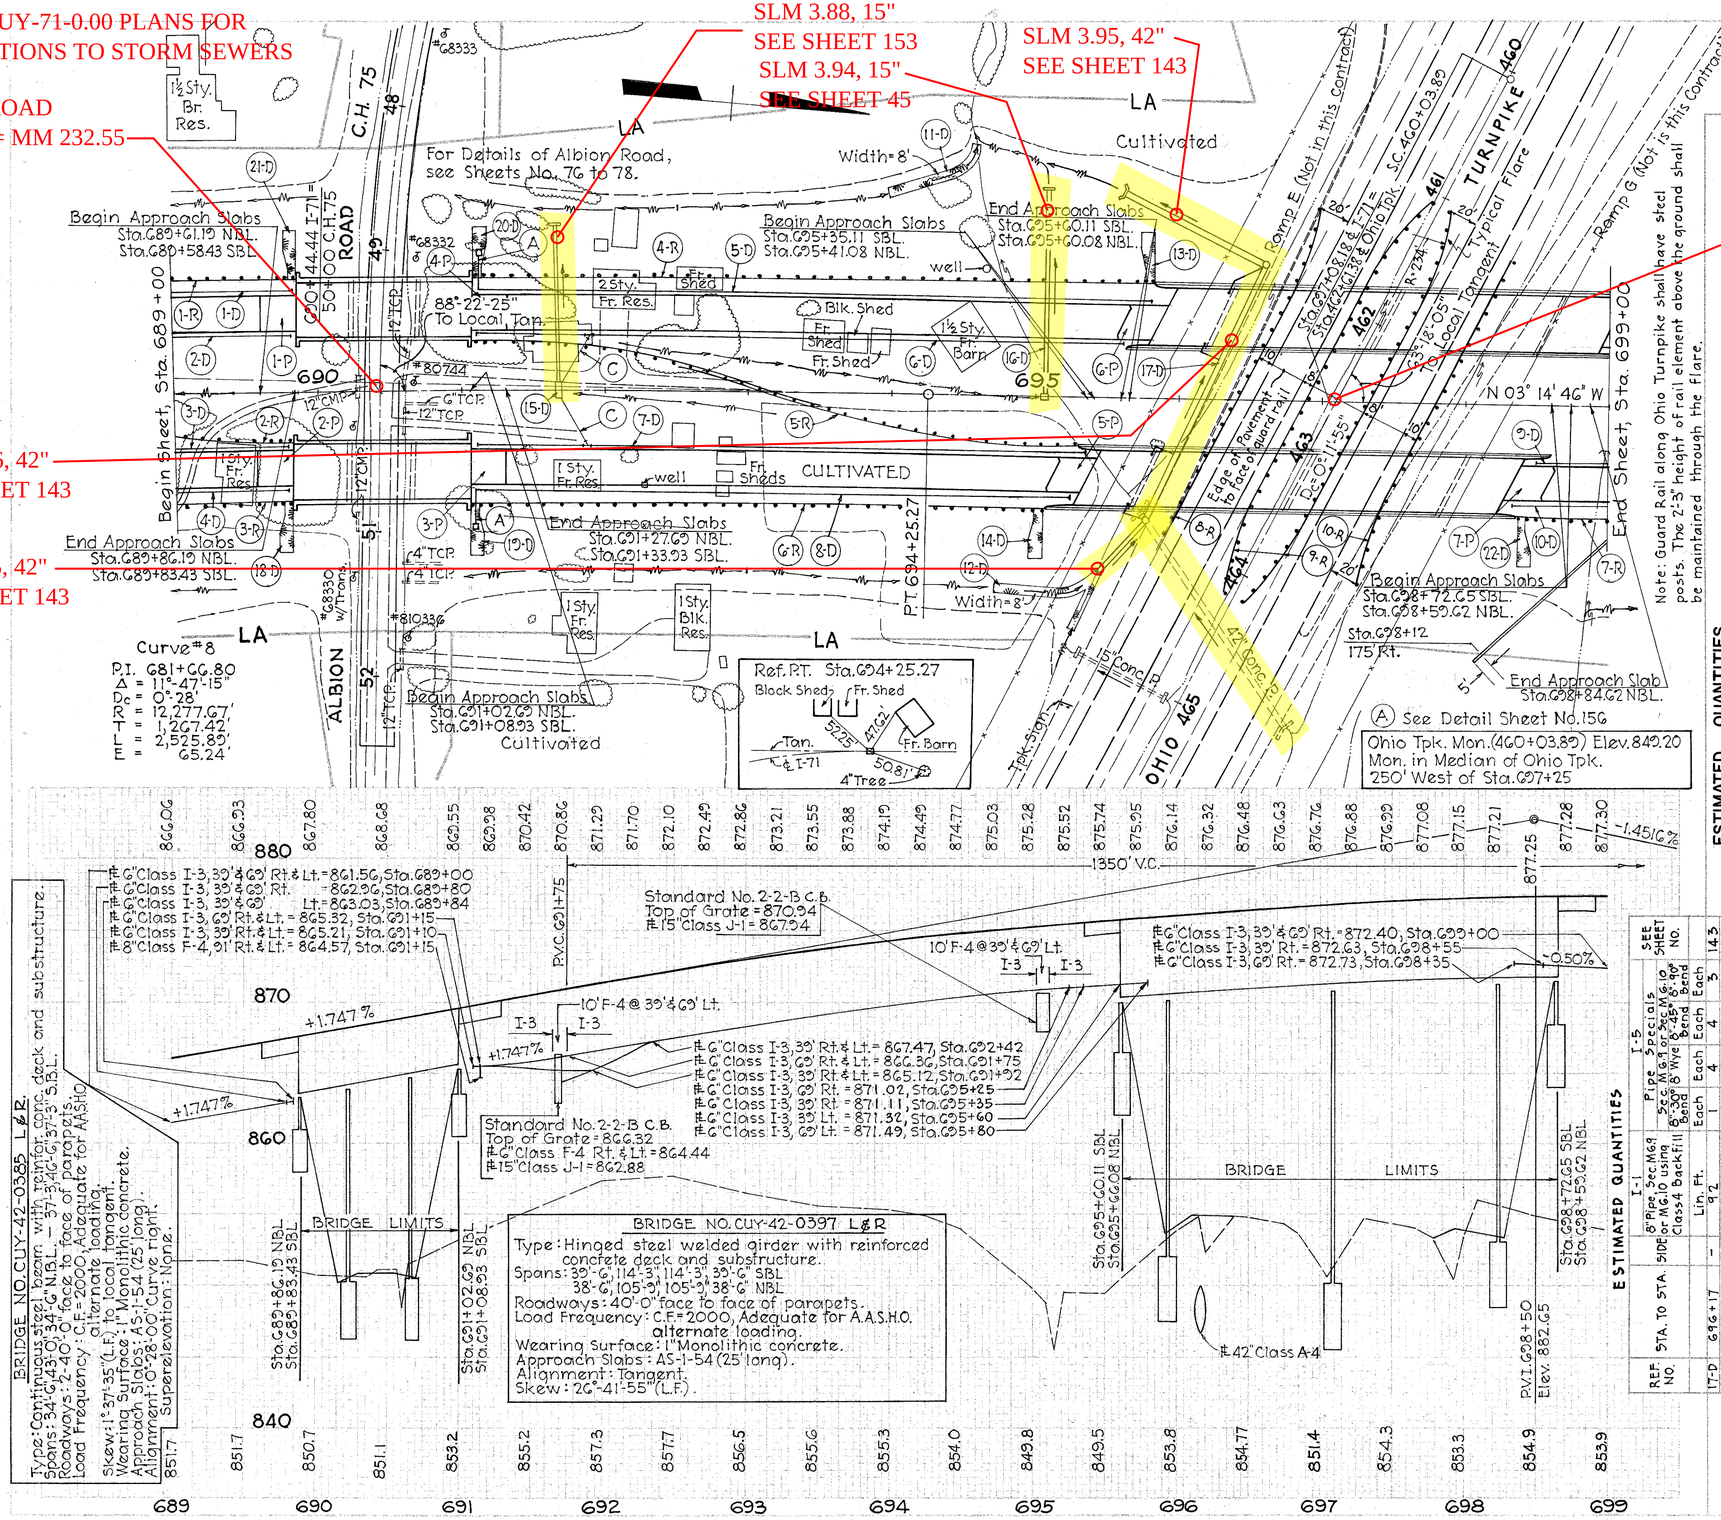

ESTIMATED QUANTITIES





Sta. 689+00 to Sta. 699+00