SEE 2001 CUY-71-0.00 PLANS FOR MODIFICATIONS TO STORM SEWERS

CUYAHOGA COUNTY

FED. RD. DIV.	STATE	PROJECT	
2	OHIO	I-71-5(11)236	

28
263

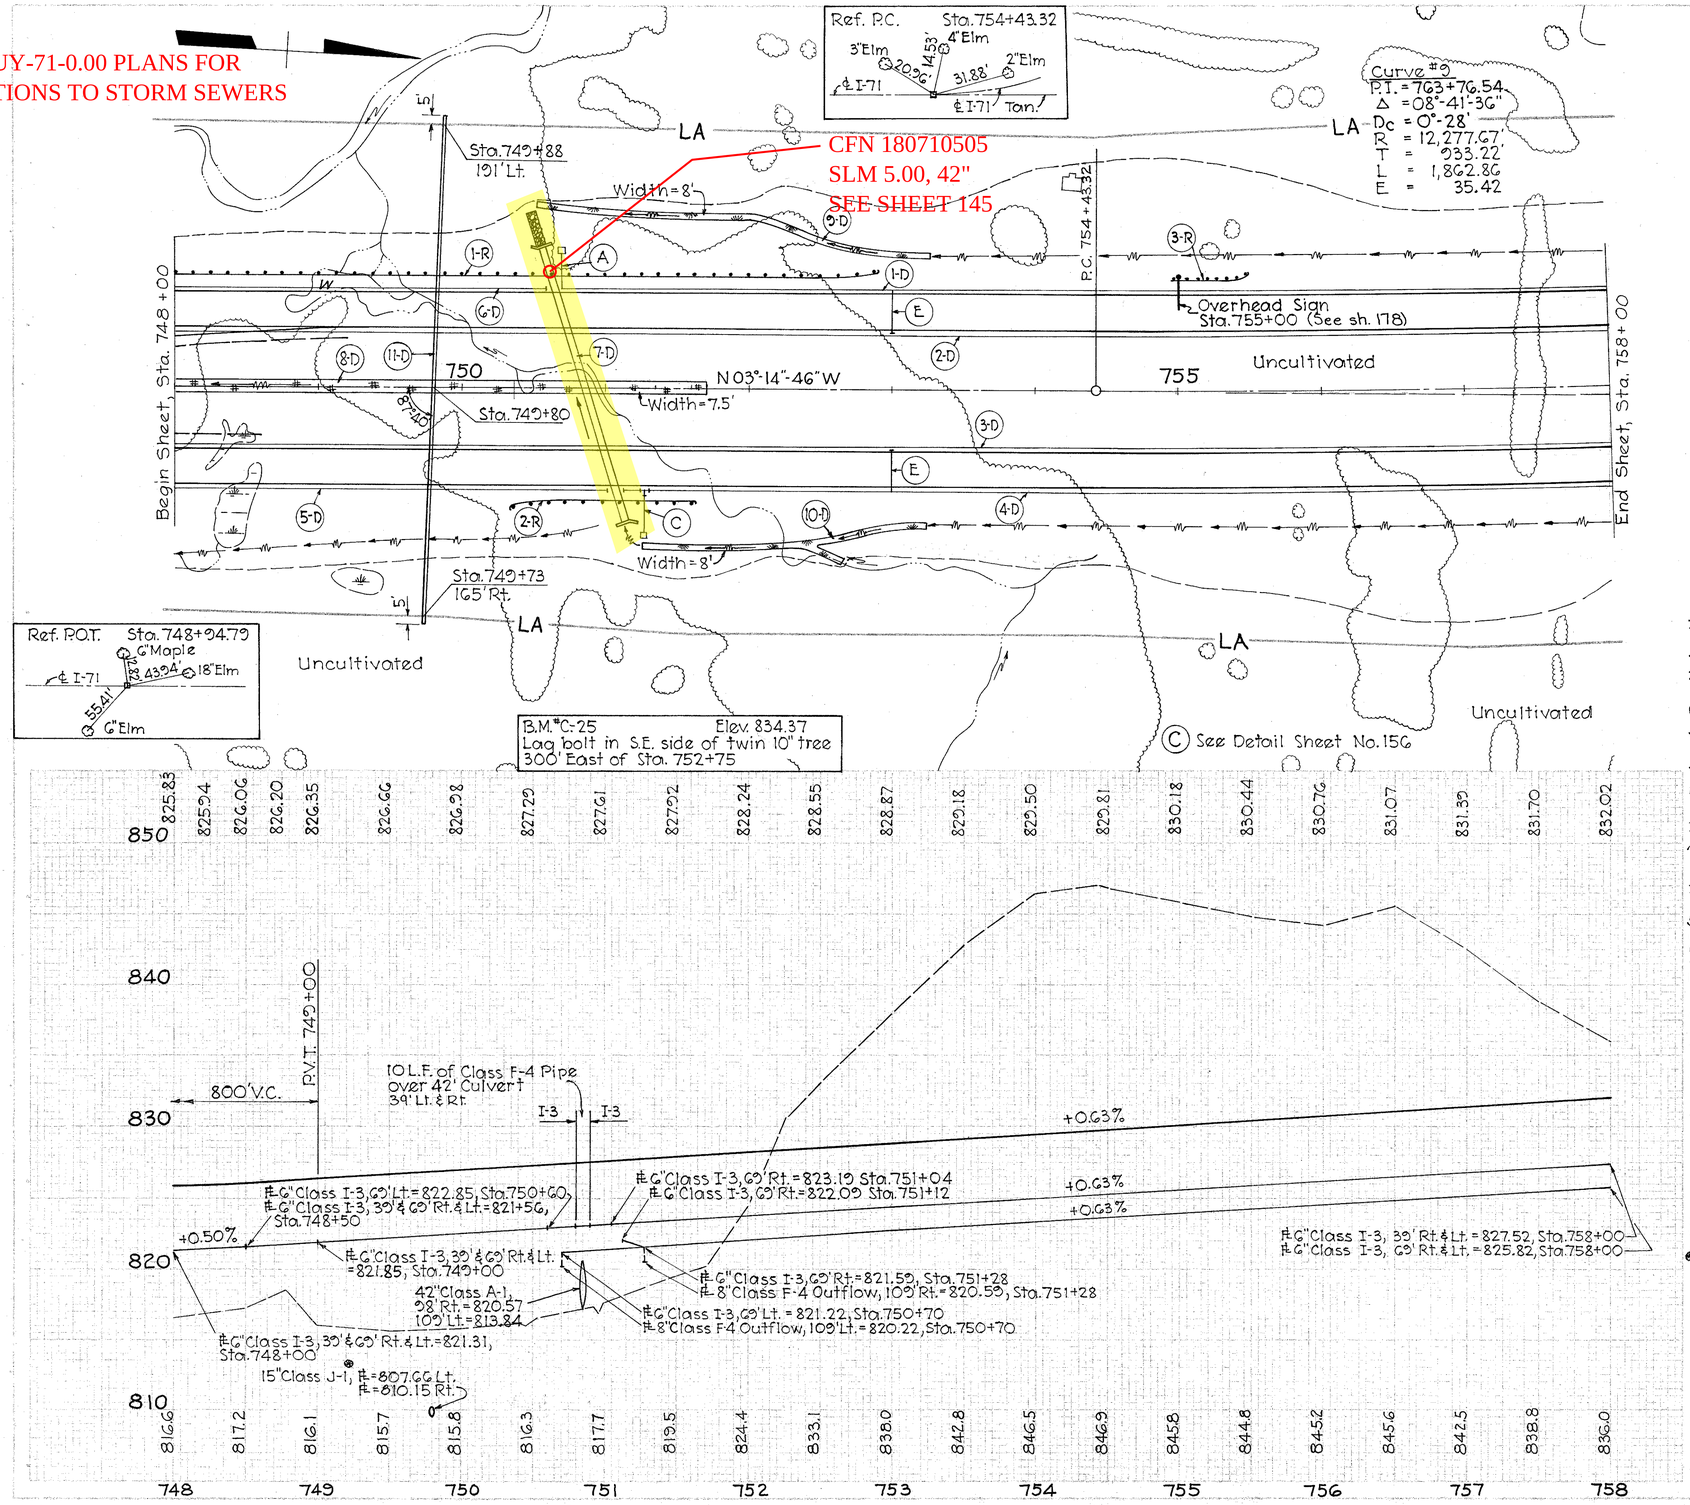

Participation.

With compression joints, Sec. T-1.06 (Sanitary), No Federal

ESTIMATED QUANTITIES

REF NO.	STATION TO STATION	SIDE	I-1 Class J-1 15" Pipe Encased 42" Lin.Ft.	I-1 Cl. A-1 Pipe Mc&(6) Lin.Ft.	I-1 Class I-3 Pipe Deep 6" Lin.Ft.	I-1 Class I-3 Pipe Shallow 6" Lin.Ft.	I-1 Cl. F-4 Pipe 8" Lin.Ft.	I-2 Masonry Headwall No. 3 Cu.Yd.	I-5 Pipe Special Class I-3 Band Tee 6"-90° Each	I-5 Pipe Special Class I-3 Band Tee 6" Each	I-10 Dumped Rock Channel Protect. Cu.Yd.	I-15 Guard Rail Lin.Ft.	I-15 Special Guard Rail Lin.Ft.	L-10 Sodding Sq.Yd.	L-120 Jute Matting Sq.Yd.	I-1 Cl. F-4 Pipe 6" Lin.Ft.	SEE SHEET NO.
1-D	750+70 to 758+00	Lt.			788	990	10		1	1						10	
2-D	748+00 to 758+00	Lt.				990										10	
3-D	748+00 to 758+00	Rt.				990											
4-D	751+12 to 758+00	Rt.			746		10		2								
5-D	748+00 to 751+02	Rt.				302											
6-D	748+00 to 750+60	Lt.				260											
7-D	750+85	—						14.2			17			8	329		145
8-D	748+00 to 751+70	Med.												244			
9-D	750+50 to 753+25	Lt.												182			
10-D	751+25 to 753+25	Rt.															
11-D	749+80	—		193	173												
1-R	748+00 to 752+875	Lt.										487.5					
2-R	750+35 to 751+60	Rt.										125					
3-R	754+97 to 755+47	Lt.											50				
TOTALS			193	173	206	1534	20	14.2	1	3	17	612.5	50	434	329	20	

Sta 748+00 to Sta. 758+00