


SEEDING  
END SQ.  
WIDTH YDS

3 CMO I-71-5(1) 236

45  
263

CUYAHOGA COUNTY  
CUY- 42-3.38

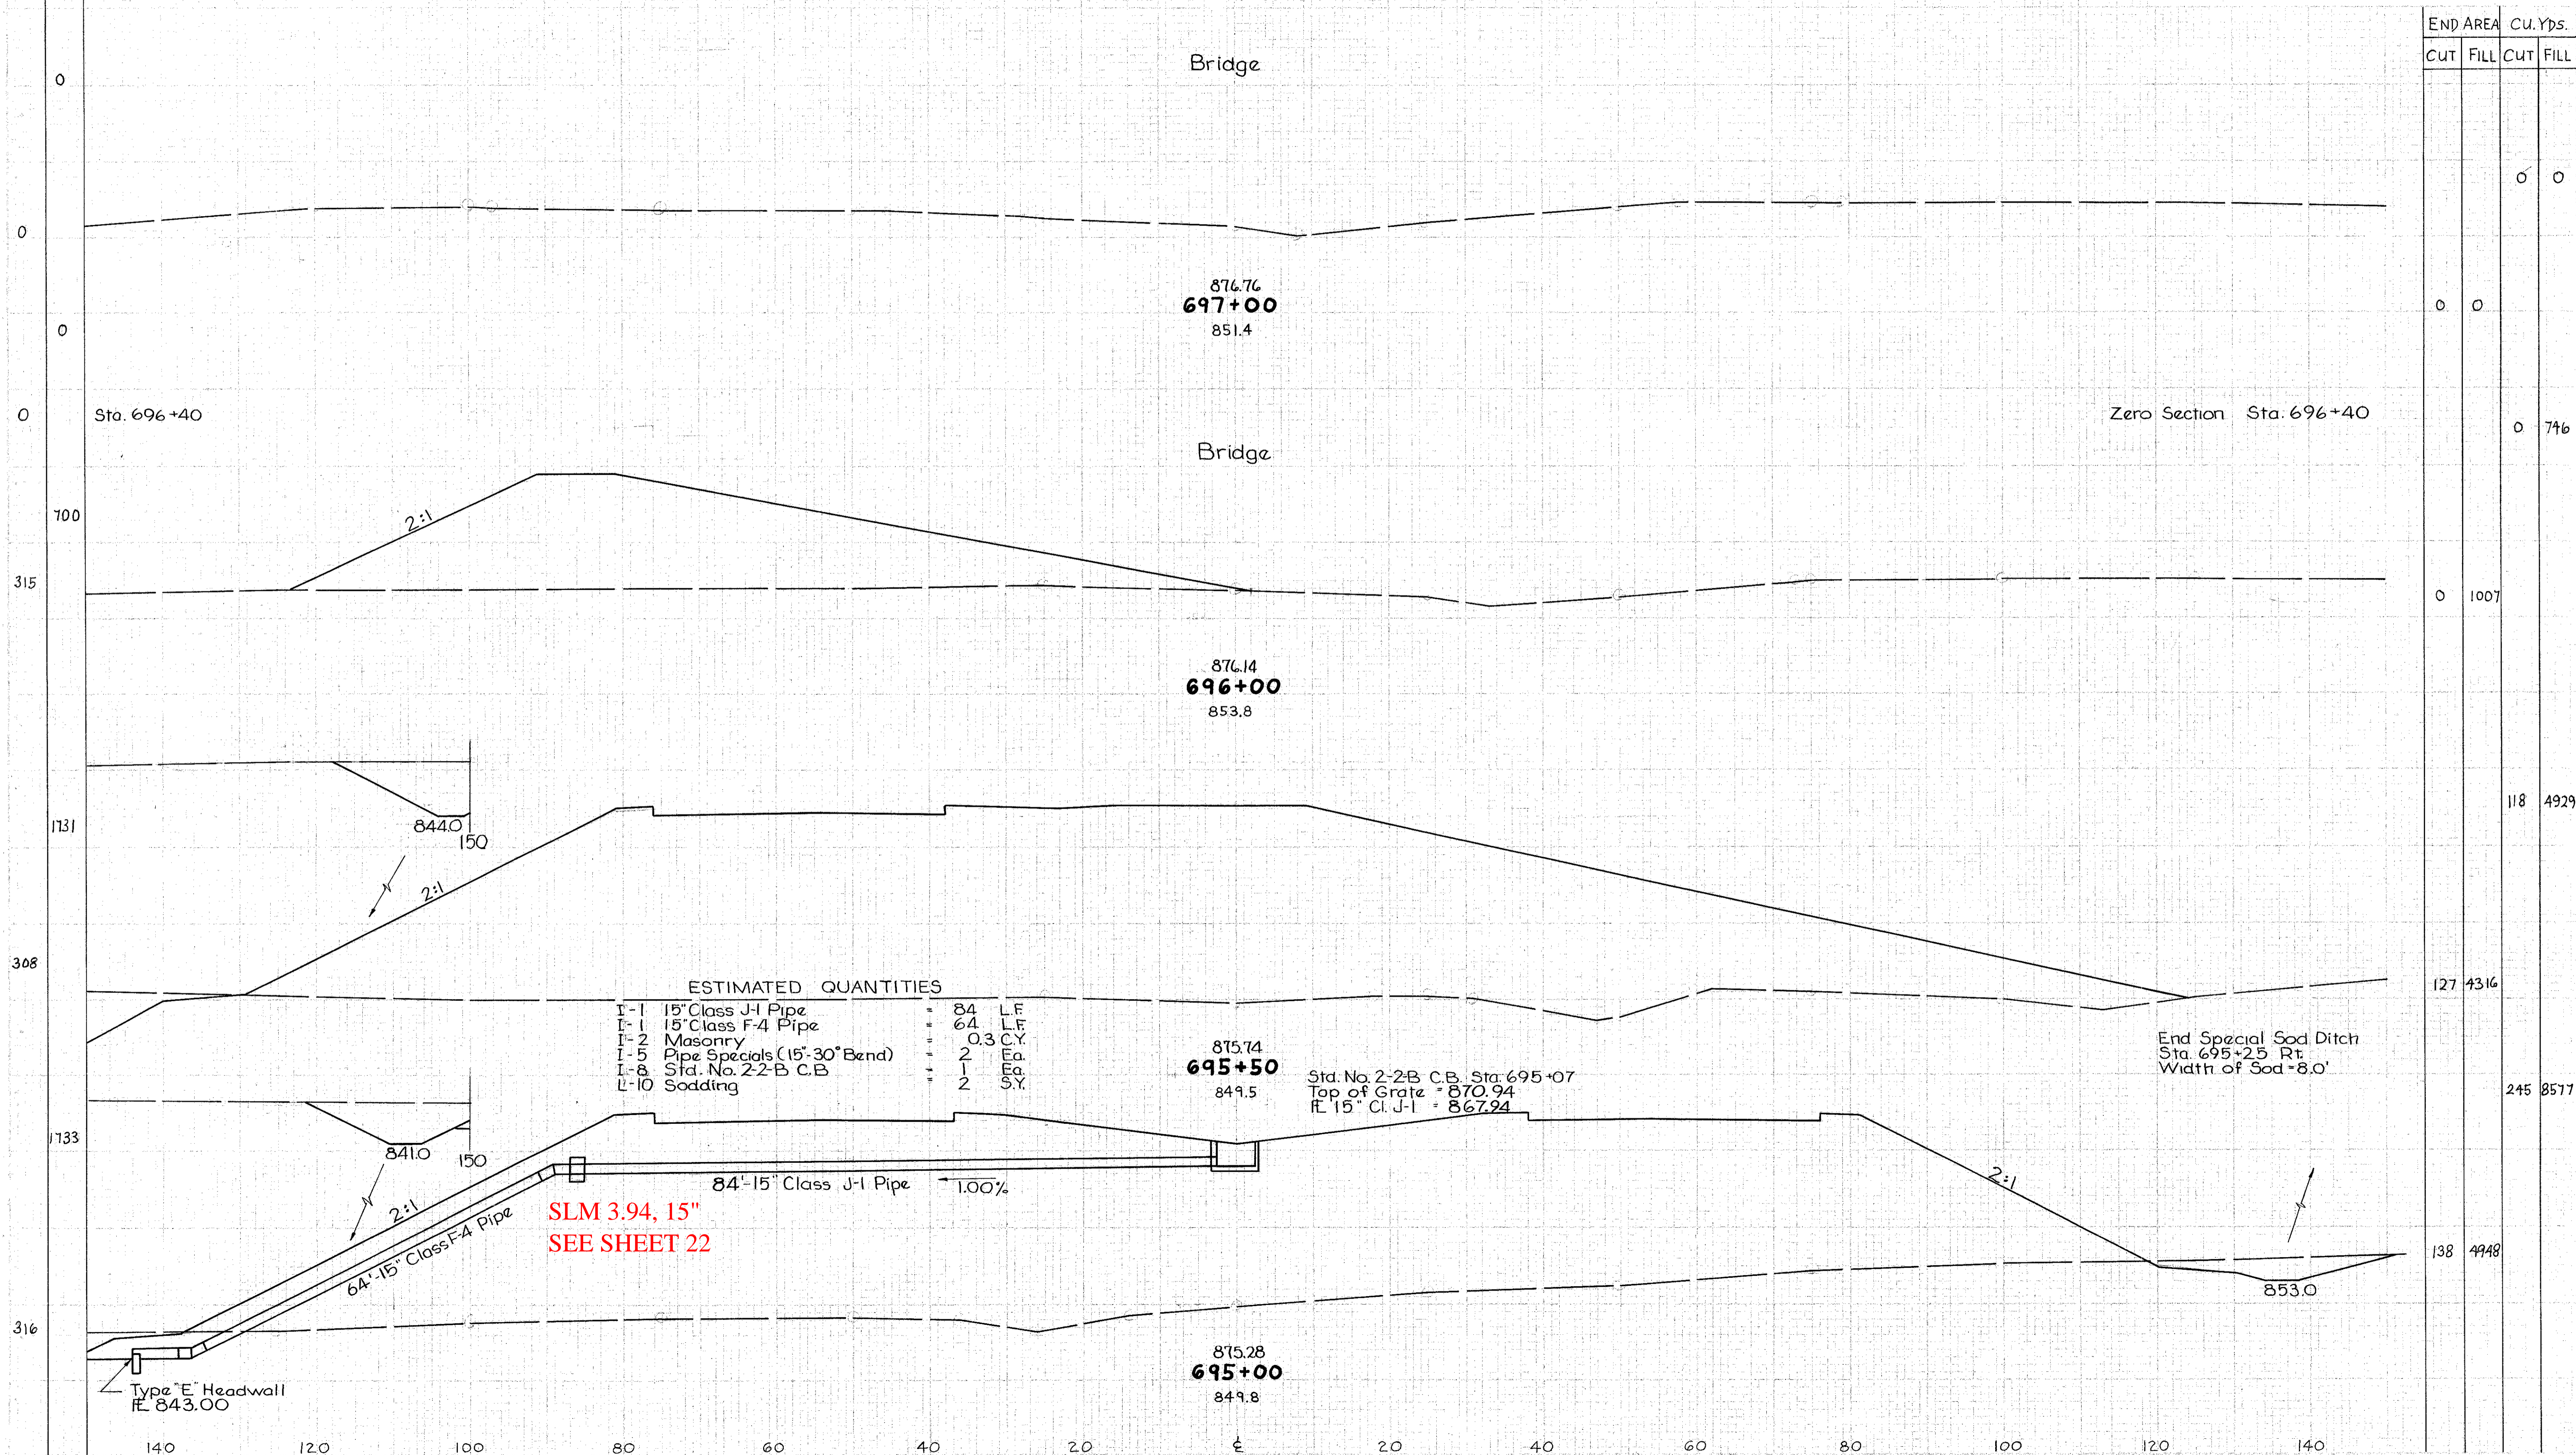

END AREA		CU. YDS.	
CUT	FILL	CUT	FILL
		0	0
		0	0
		0	746
		0	1007
		118	4929
		127	4316
		245	8517
		138	4948

Sta. 695+00 to 697+00