


SEEDING
END SQ.
WIDTH Yds.

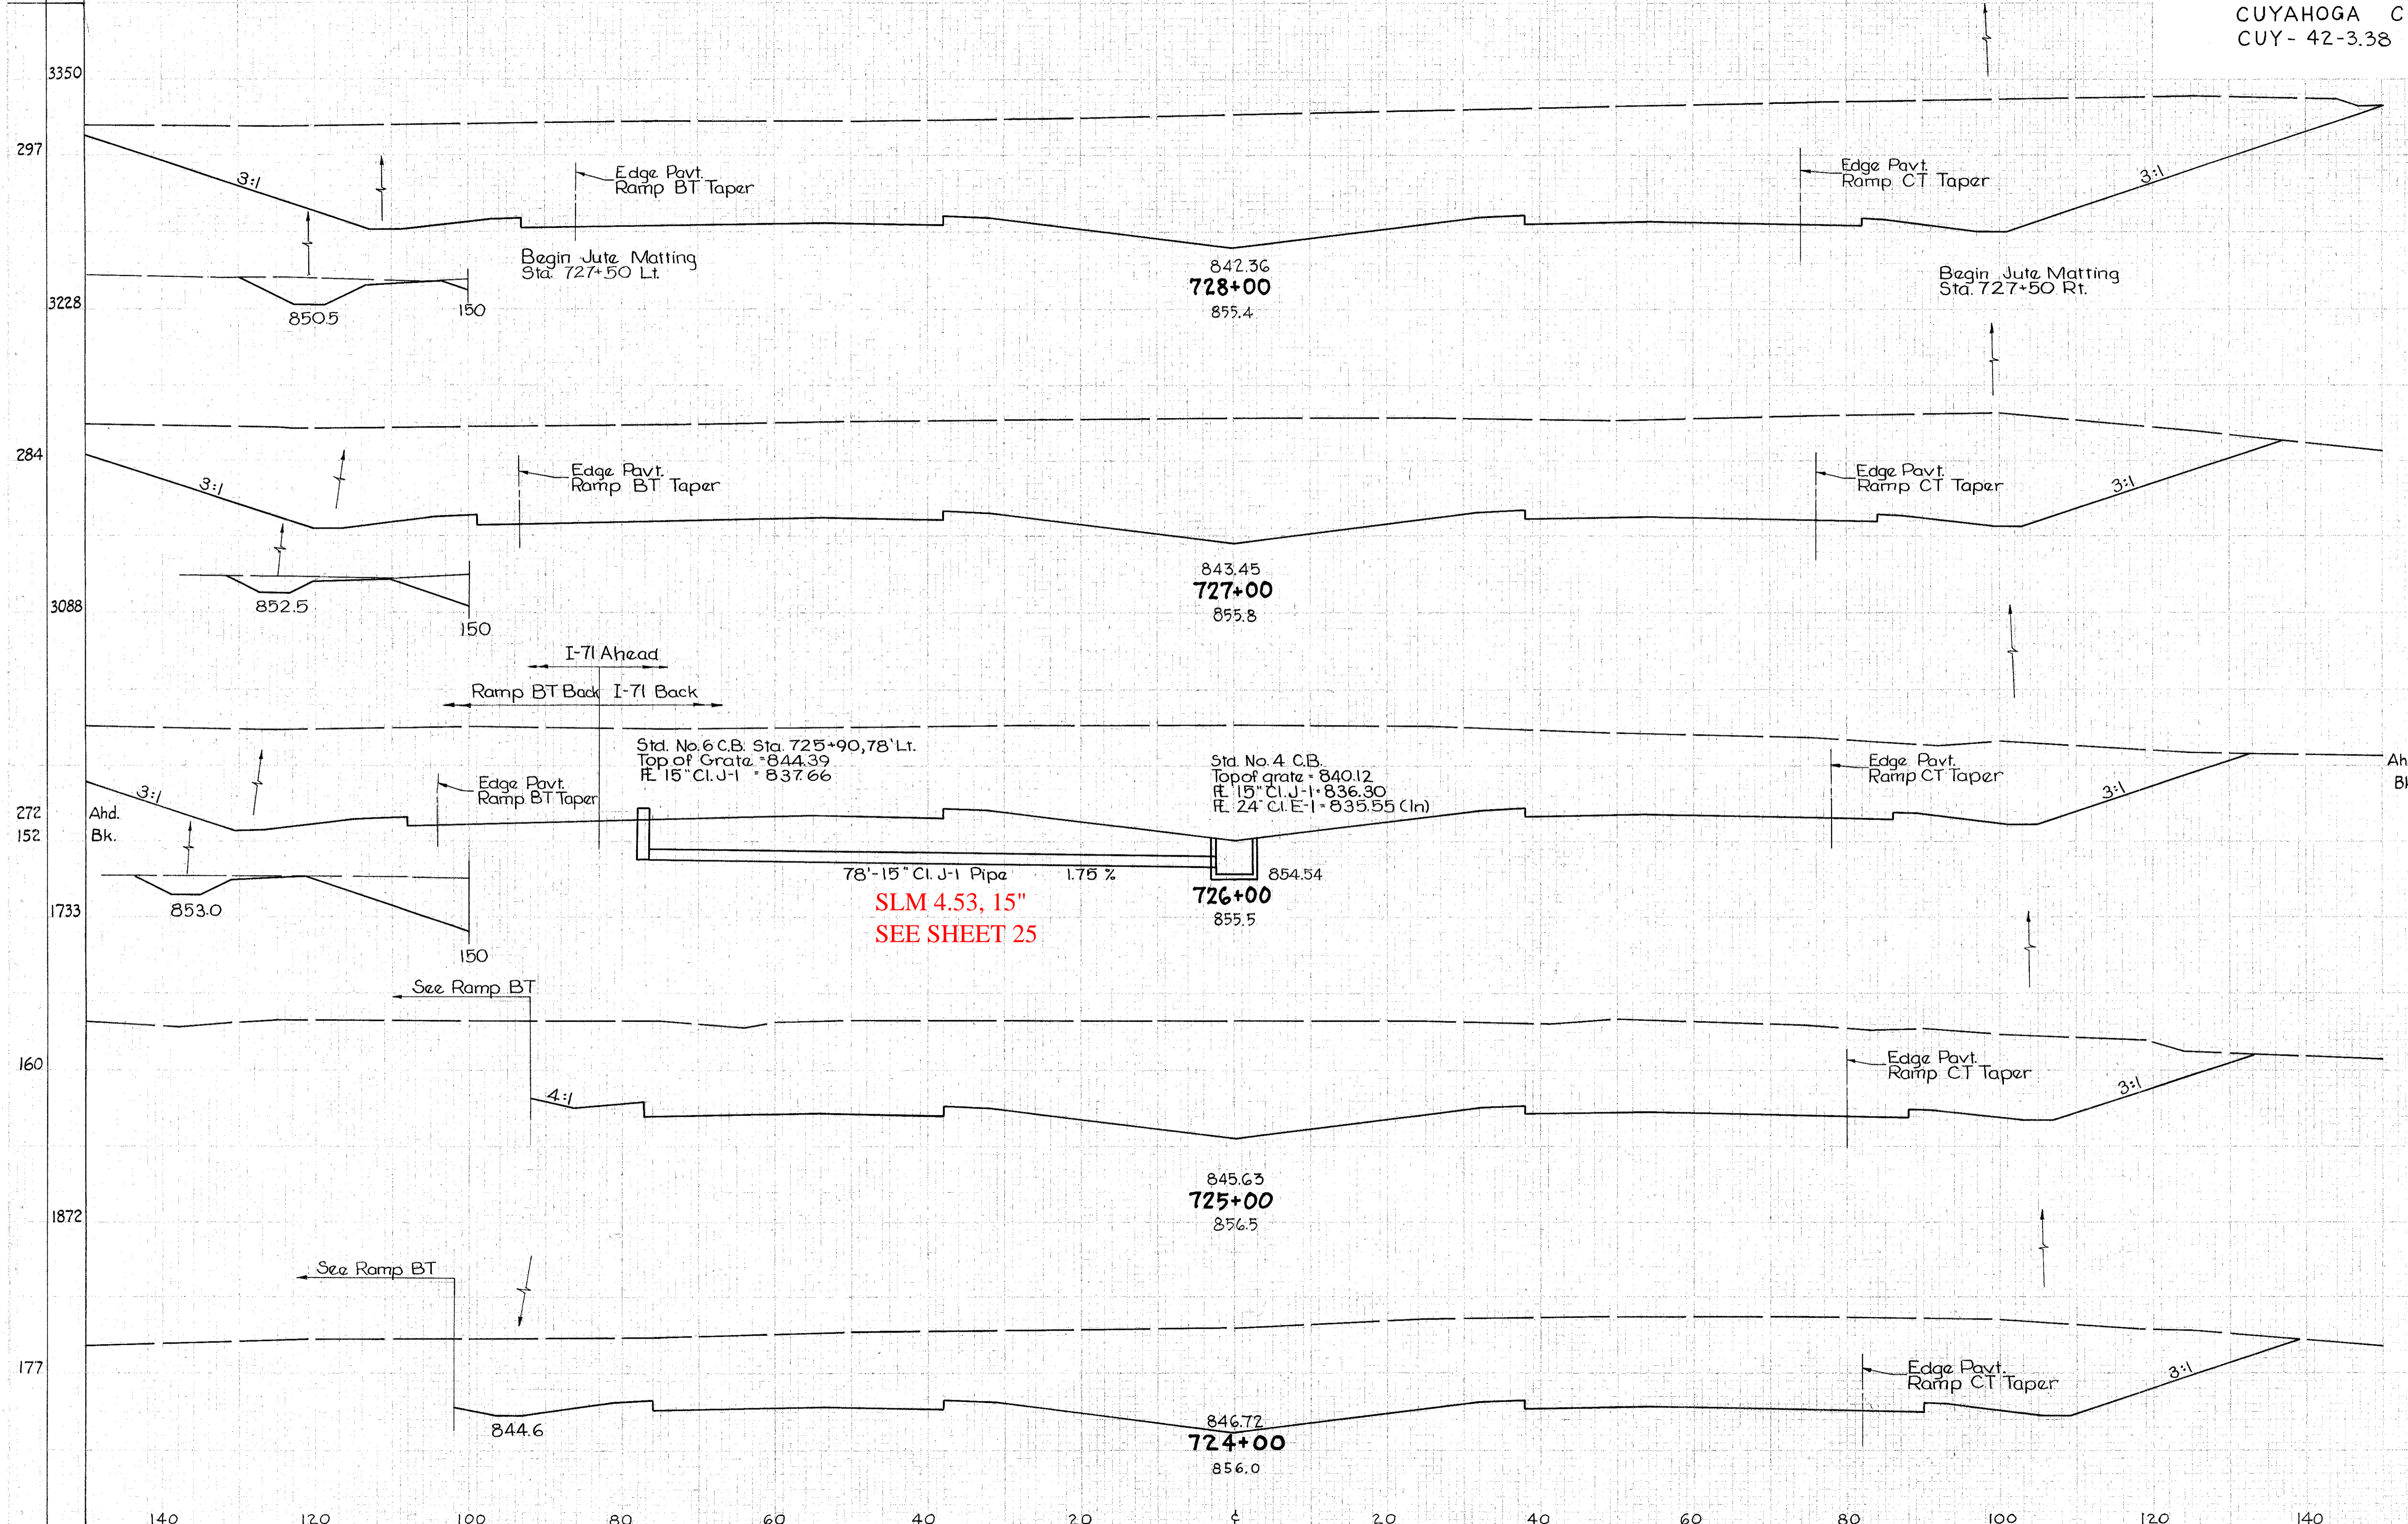

END AREA		CU. YDS.	
CUT	FILL	CUT	FILL
		14640	0
		3930	0
		13902	0
		3577	0
		12649	0
Ahd.	Bk.	3254	0
		2364	0
		9104	0
		2552	0
		9412	0
		2531	0

Sta. 724+00 to 728+00