


SEEDING
END Sta.
WIDTH YDS.

CUYAHOGA COUNTY
CUY- 42-3.38

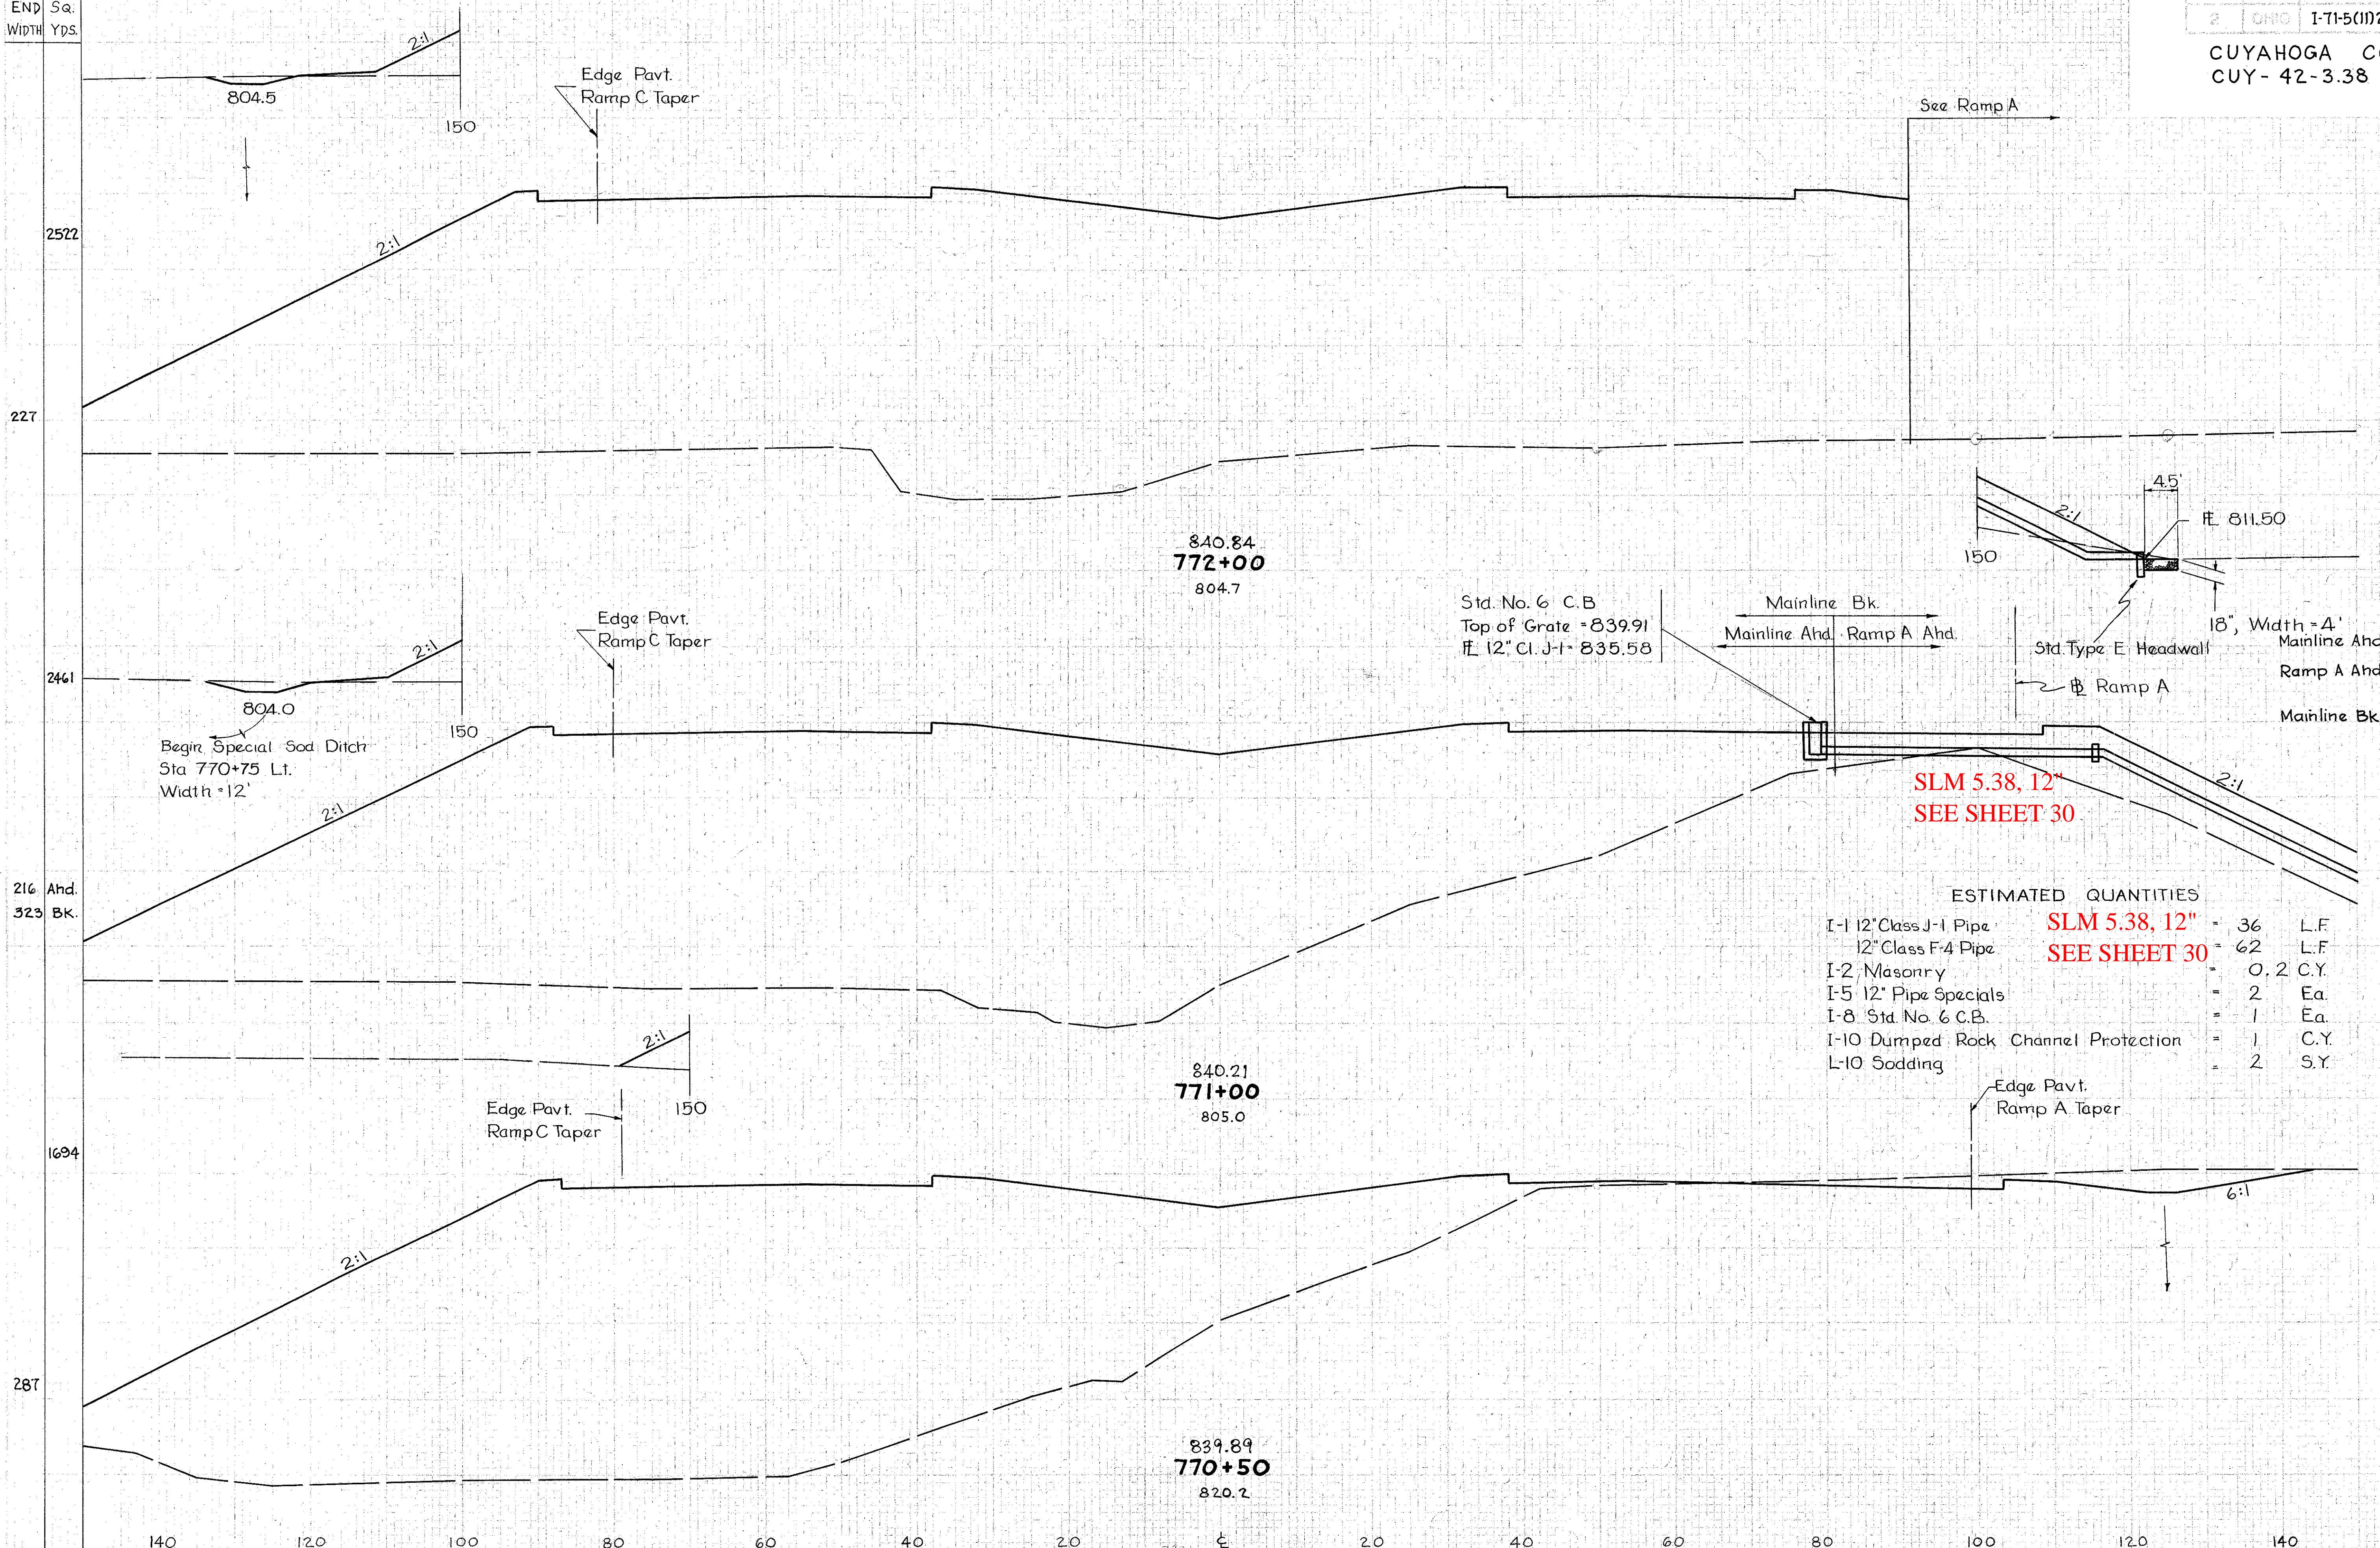

END AREA		CU. YDS.	
CUT	FILL	CUT	FILL
		39	28817
6	7499		
		33	24730
12	5868		
0	400		
		12	6382
		115	10369
		112	4817

ESTIMATED QUANTITIES

I-1 12" Class J-1 Pipe	SLM 5.38, 12"	= 36	L.F.
12" Class F-4 Pipe	SEE SHEET 30	= 62	L.F.
I-2 Masonry		= 0.2	C.Y.
I-5 12" Pipe Specials		= 2	Ea.
I-8 Std. No. 6 C.B.		= 1	Ea.
I-10 Dumped Rock Channel Protection		= 1	C.Y.
L-10 Sodding		= 2	S.Y.