


FED. RD. DIVISION	STATE	PROJECT
2	OHIO	

285
646

34
54

CUYAHOGA COUNTY
CUY-71-17.83
CUY-176-12.76

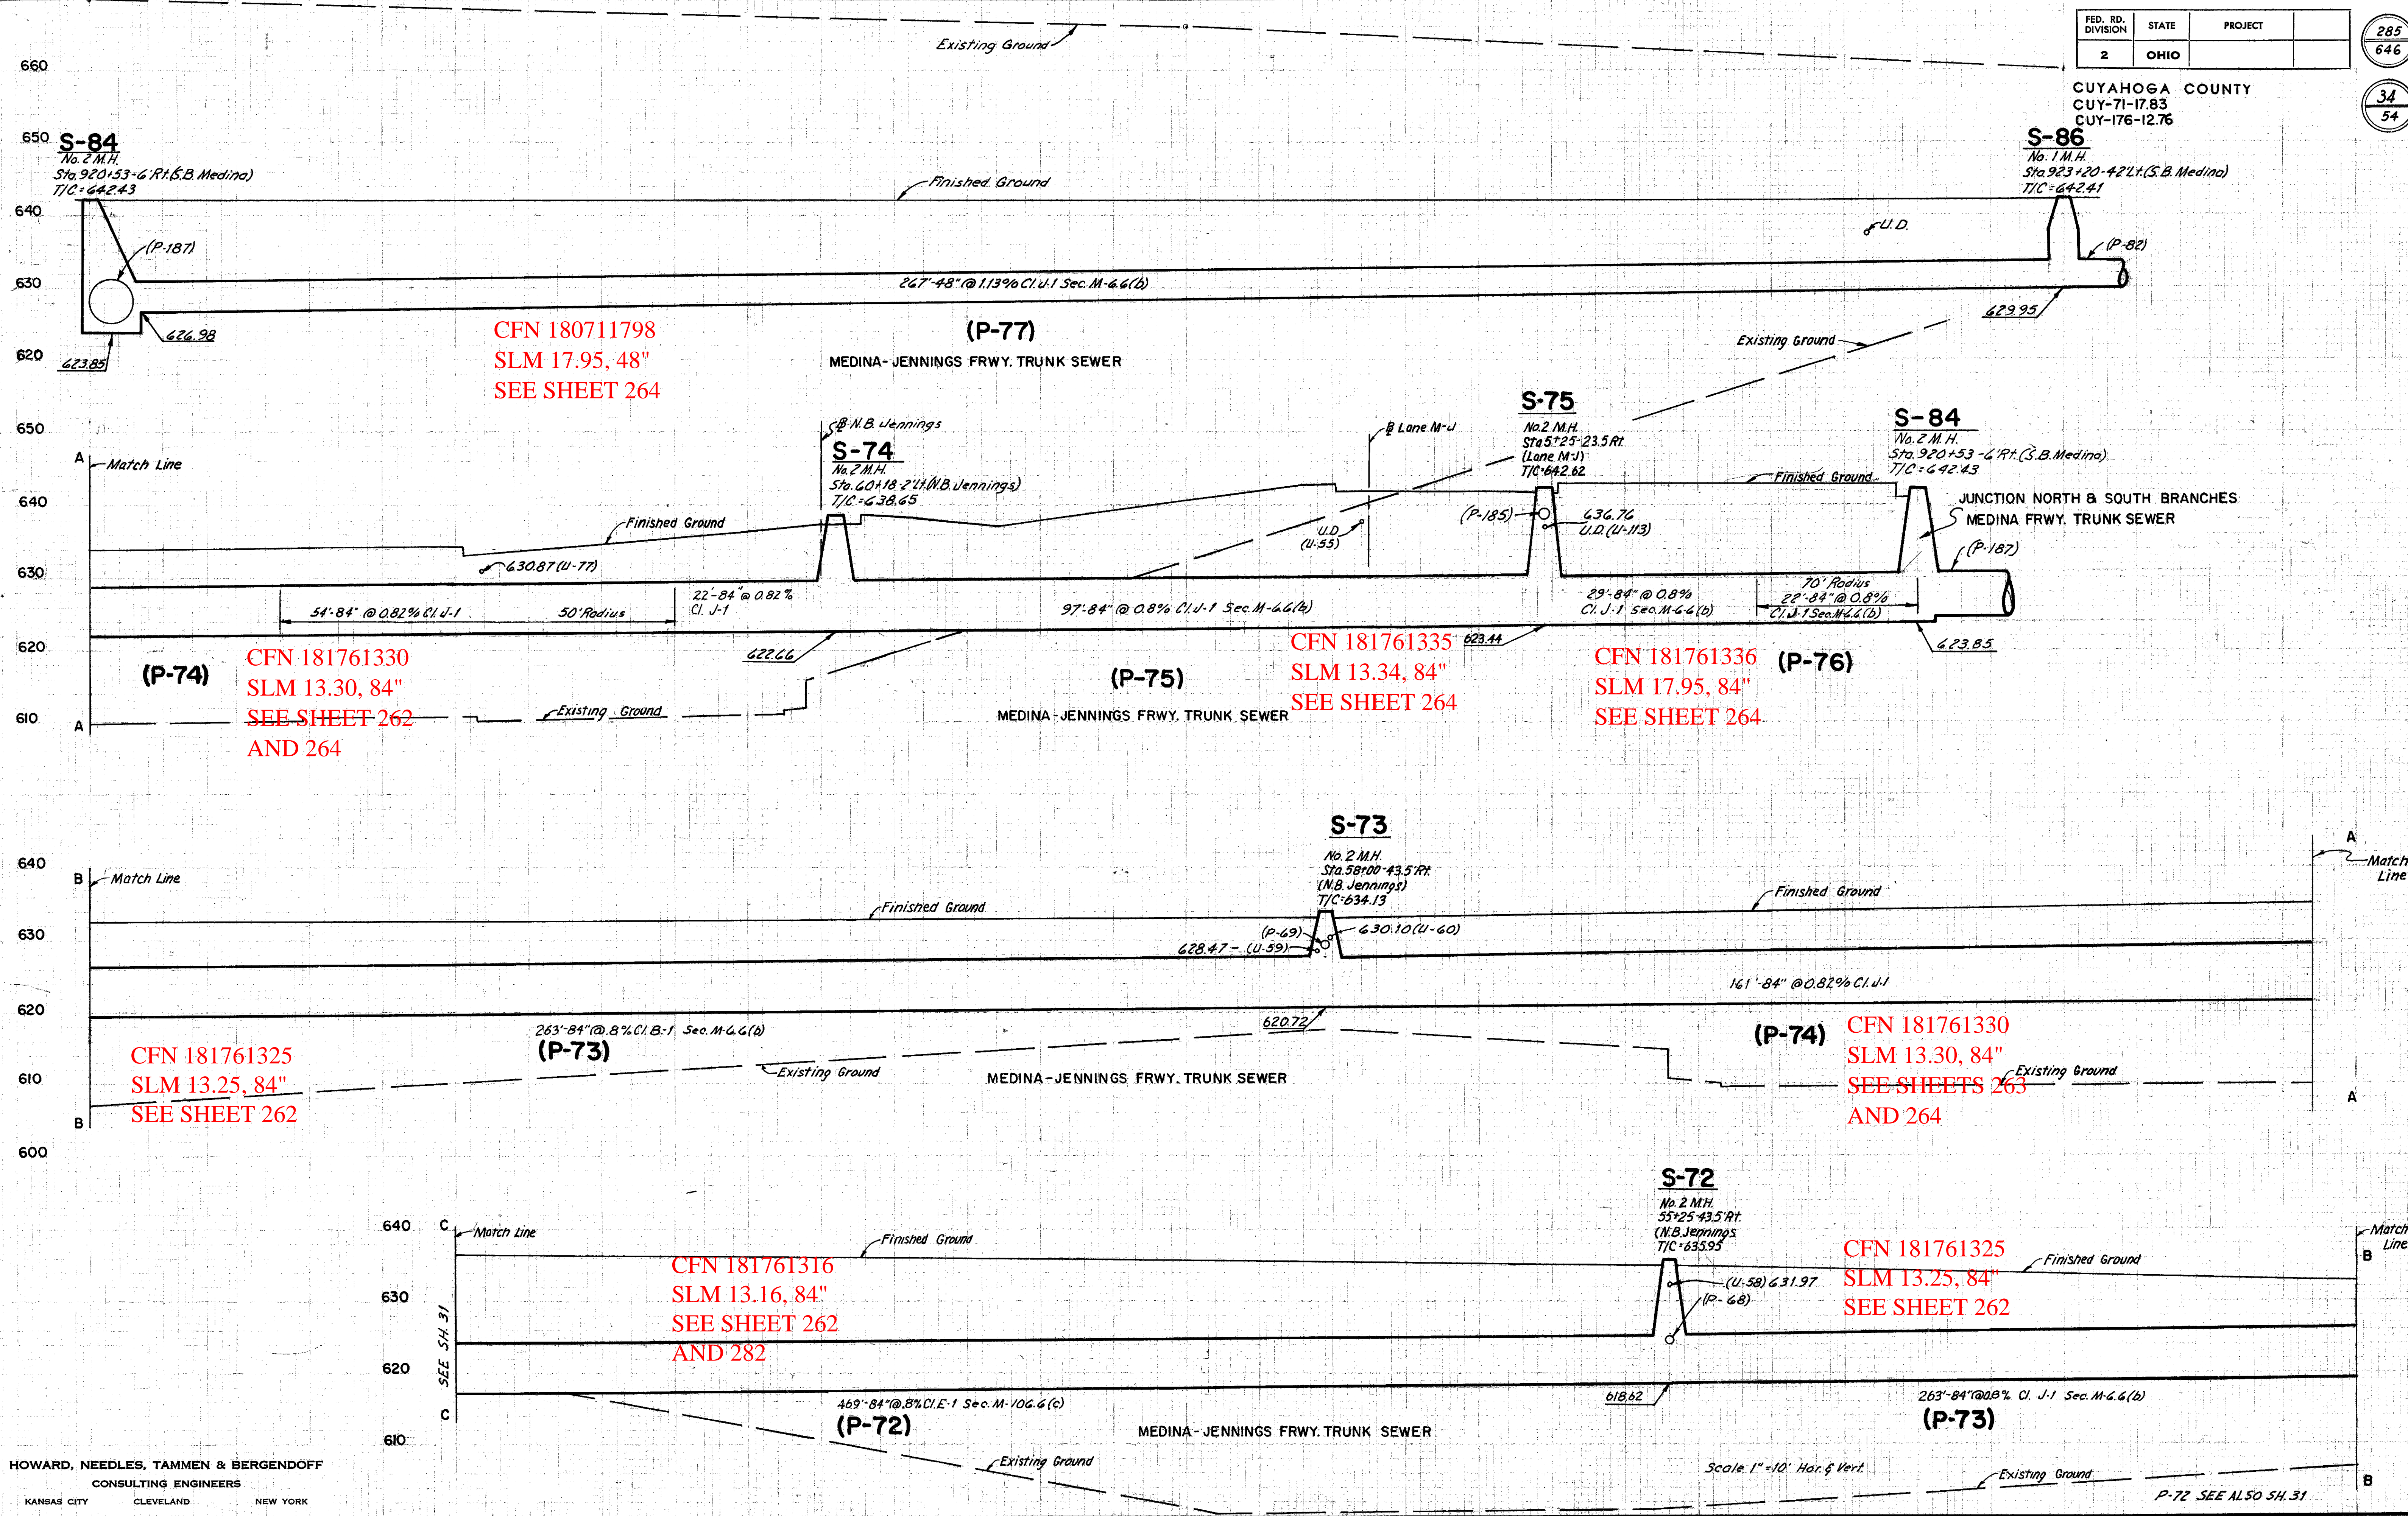

R.O.J. 10-9-68
L.M.O. 10-14-68

HOWARD, NEEDLES, TAMMEN & BERGENDOFF
CONSULTING ENGINEERS
KANSAS CITY CLEVELAND NEW YORK

Scale: 1" = 10' Hor. & Vert.

P-72 SEE ALSO SH. 31