


FED. RD. DIVISION	STATE	PROJECT
2	OHIO	

288
646

CUYAHOGA COUNTY
CUY-71-1783
CUY-176-12.76

37
54

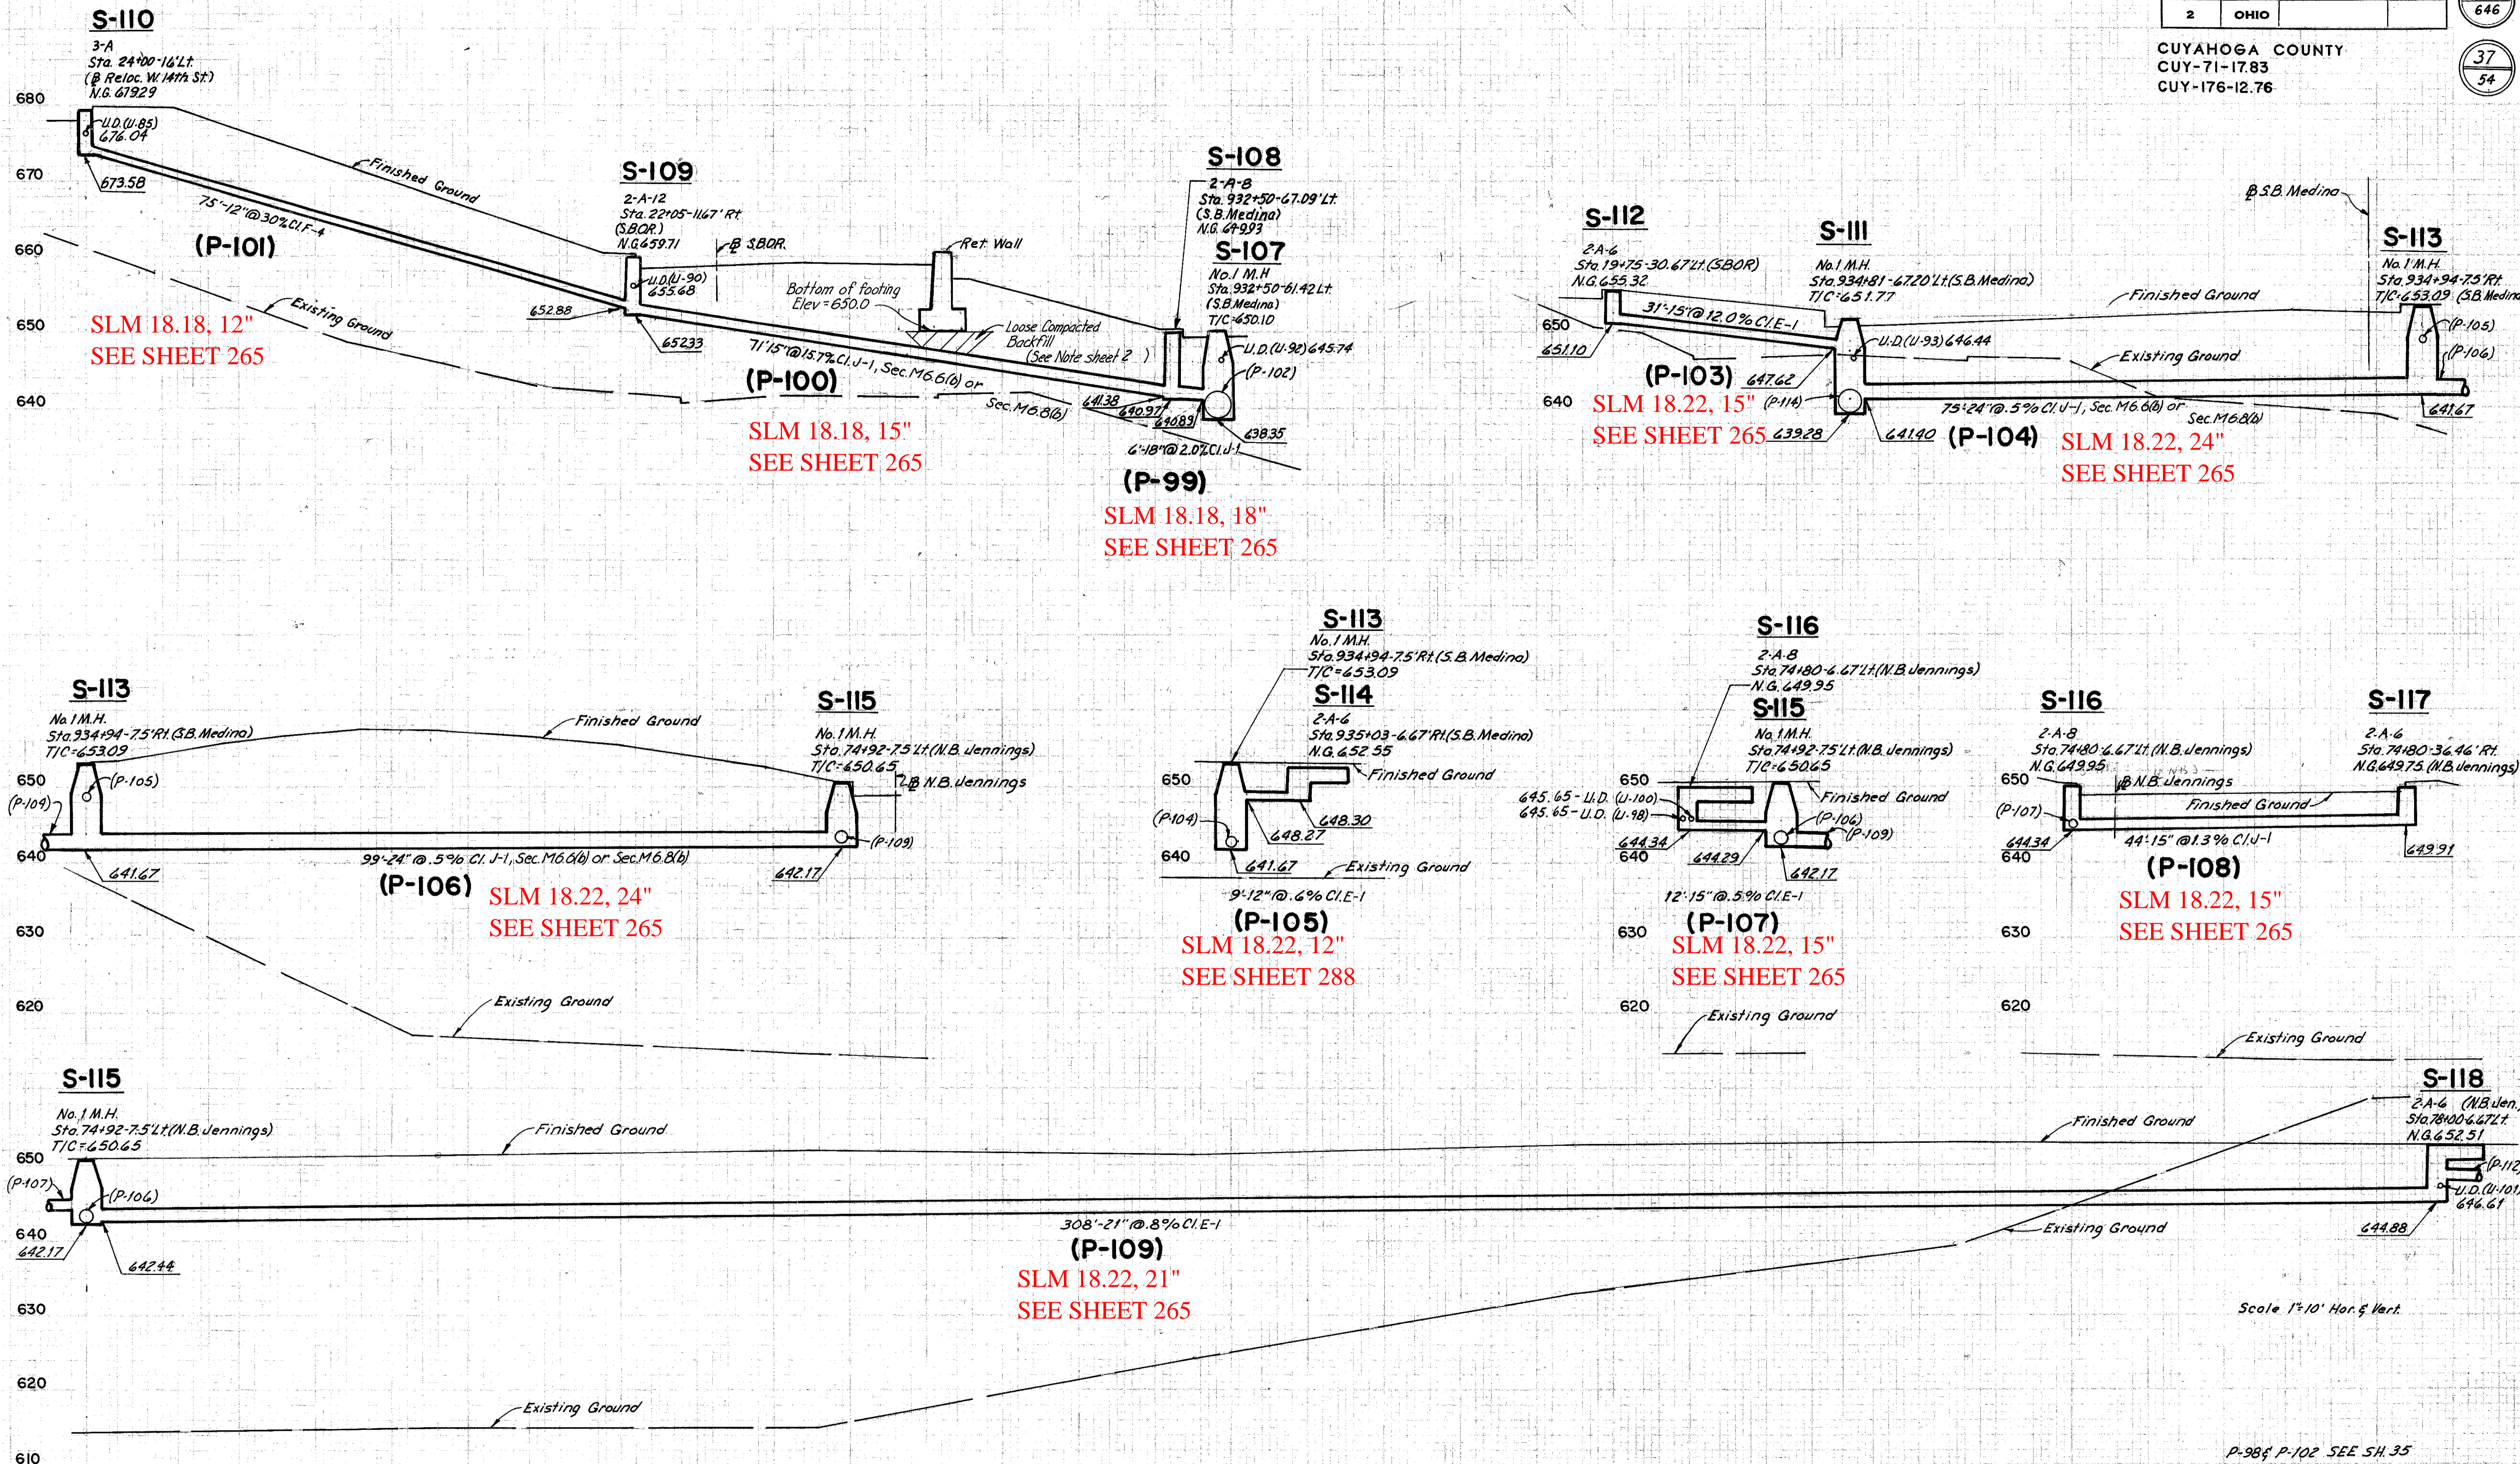

SLM 18.18, 12"
SEE SHEET 265

SLM 18.18, 15"
SEE SHEET 265

SLM 18.18, 18"
SEE SHEET 265

SLM 18.22, 15"
SEE SHEET 265

SLM 18.22, 24"
SEE SHEET 265

SLM 18.22, 24"
SEE SHEET 265

SLM 18.22, 12"
SEE SHEET 288

SLM 18.22, 15"
SEE SHEET 265

SLM 18.22, 15"
SEE SHEET 265

SLM 18.22, 21"
SEE SHEET 265

Scale 1"=10' Hor. & Vert.

P-98 & P-102 SEE SH. 35

R.D.J. 9-14-64
L.M.D. 10-23-64