


FED. RD. DIVISION	STATE	PROJECT	
2	OHIO		

299  
646

48  
54

CUYAHOGA COUNTY  
CUY-71-17.83  
CUY-176-12.76

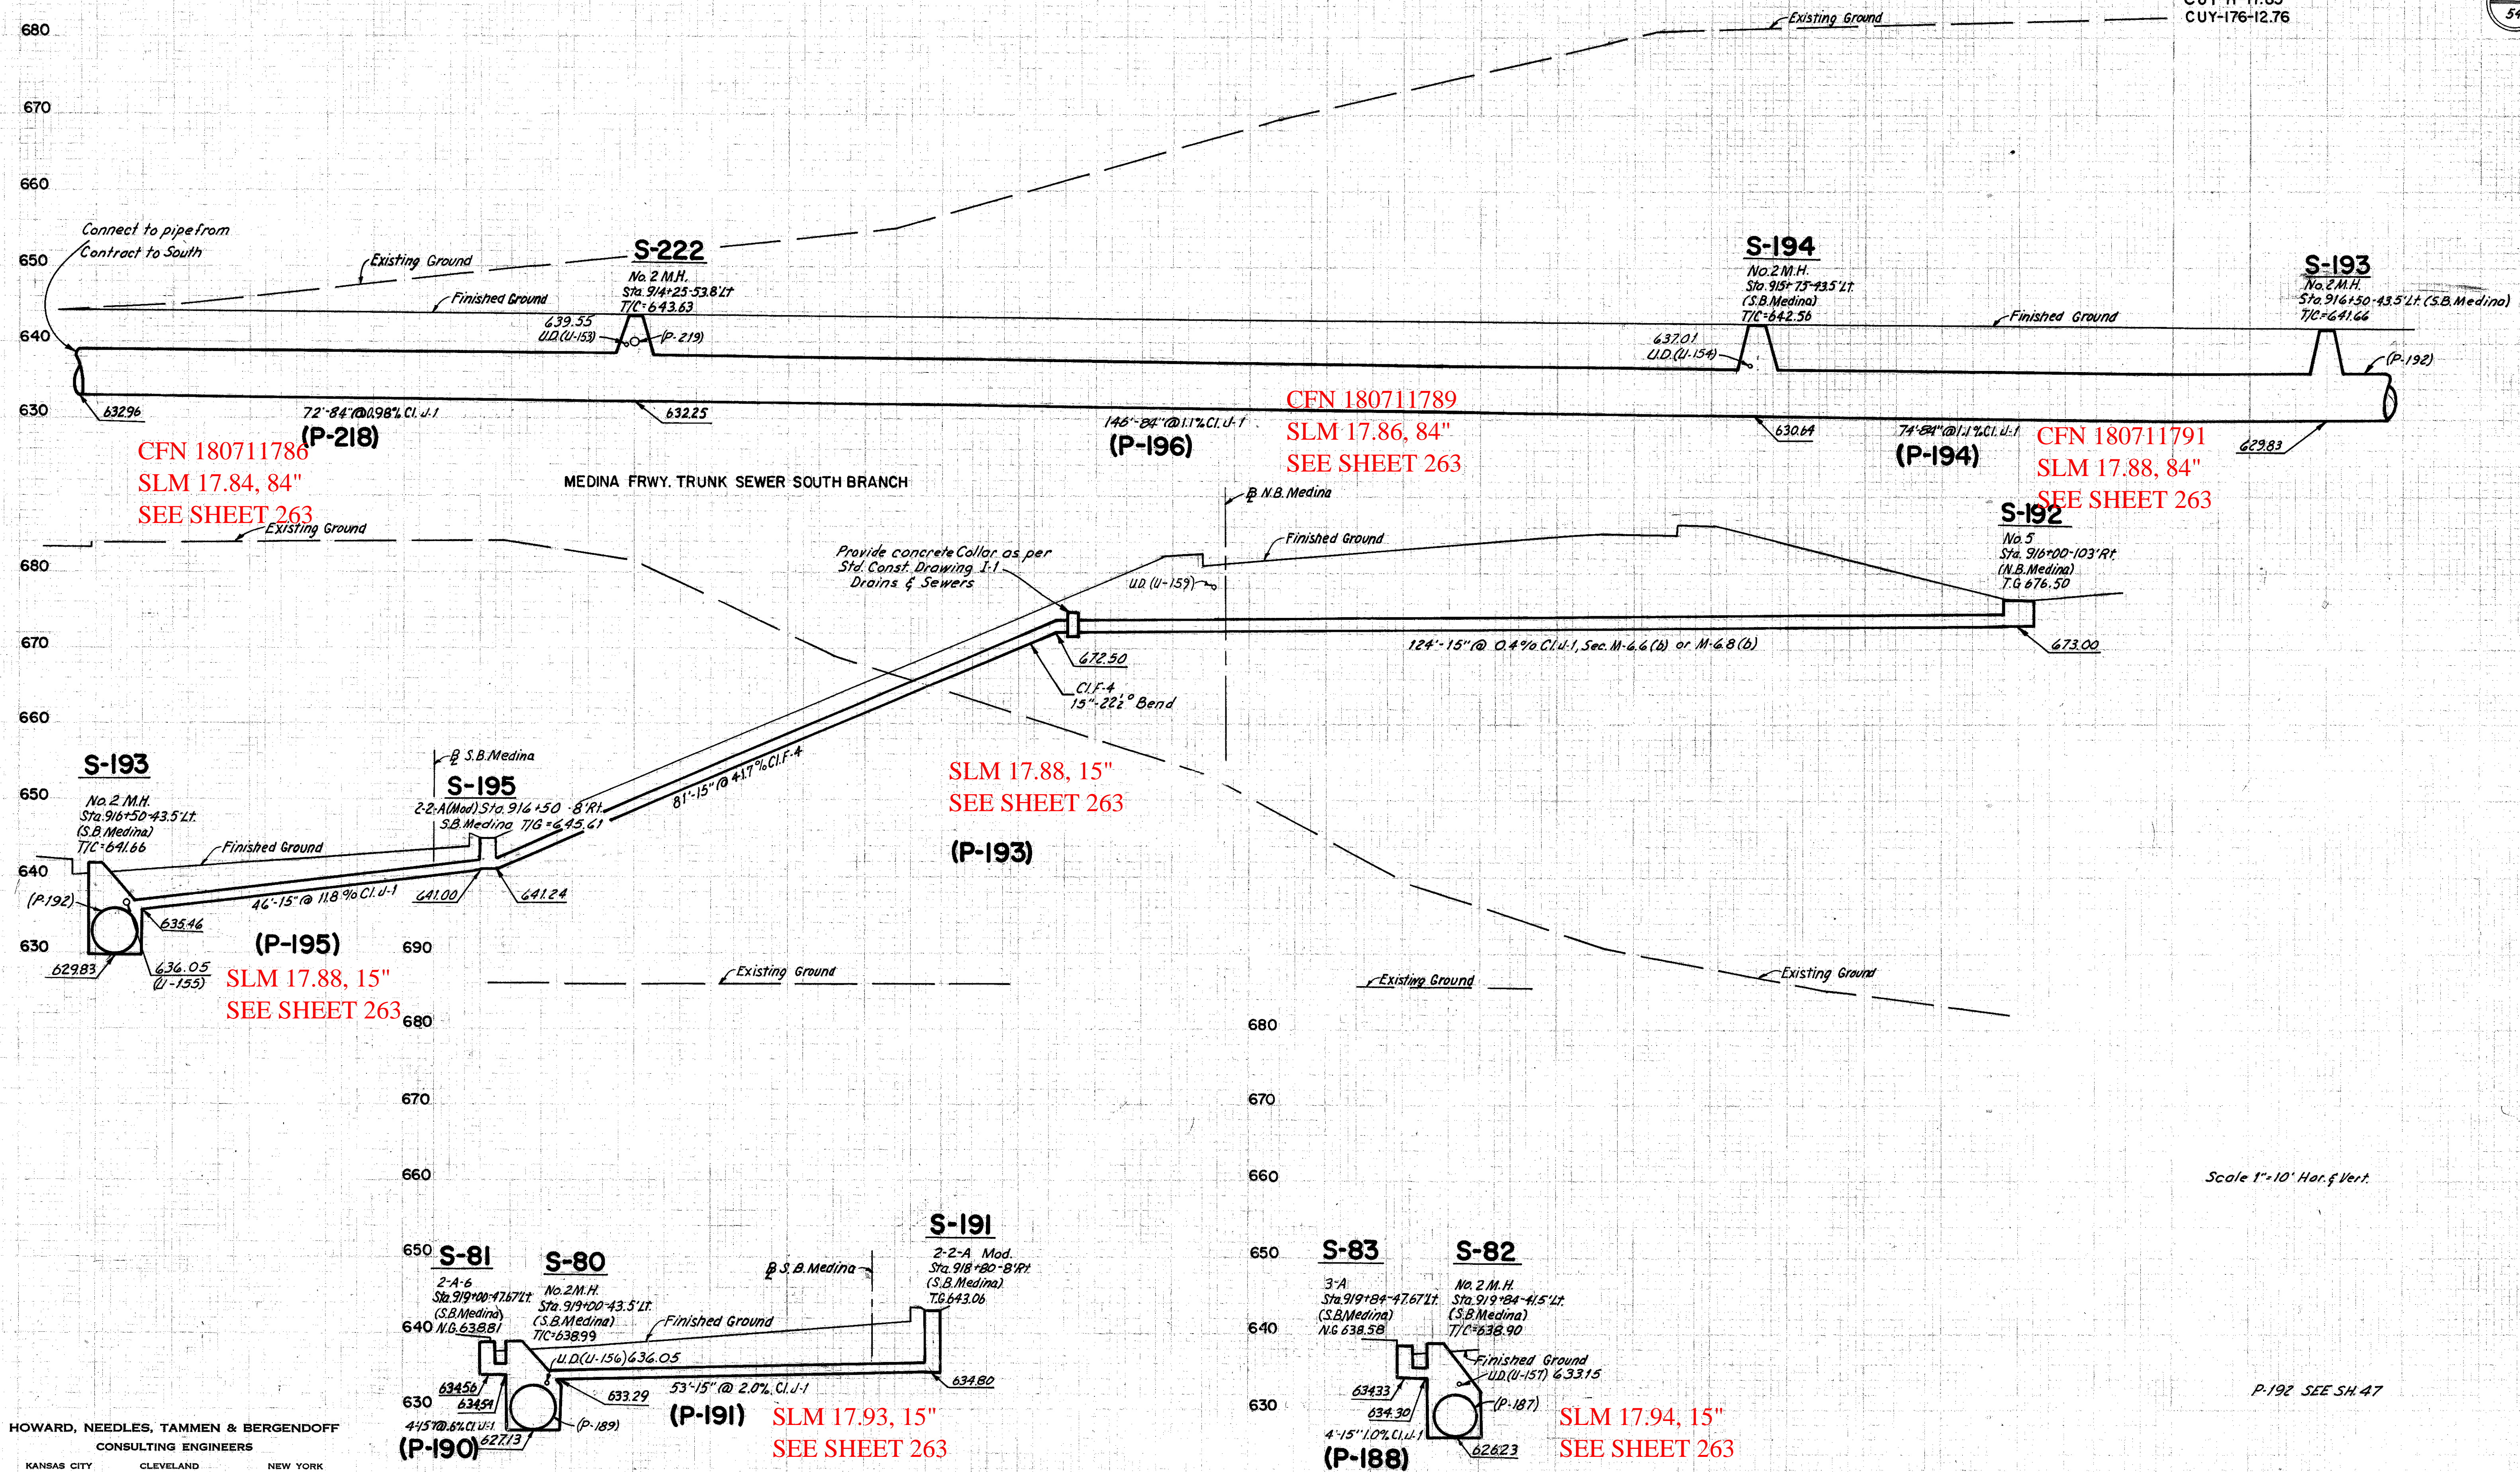

Scale 1"=10' Hor. & Vert.

P-192 SEE SH. 47

HOWARD, NEEDLES, TAMMEN & BERGENDOFF  
CONSULTING ENGINEERS  
KANSAS CITY CLEVELAND NEW YORK