


FED. RD. DIVISION	STATE	PROJECT
2	OHIO	

283
646

CUYAHOGA COUNTY
CUY-71-17.83
CUY-176-12.76

32
54

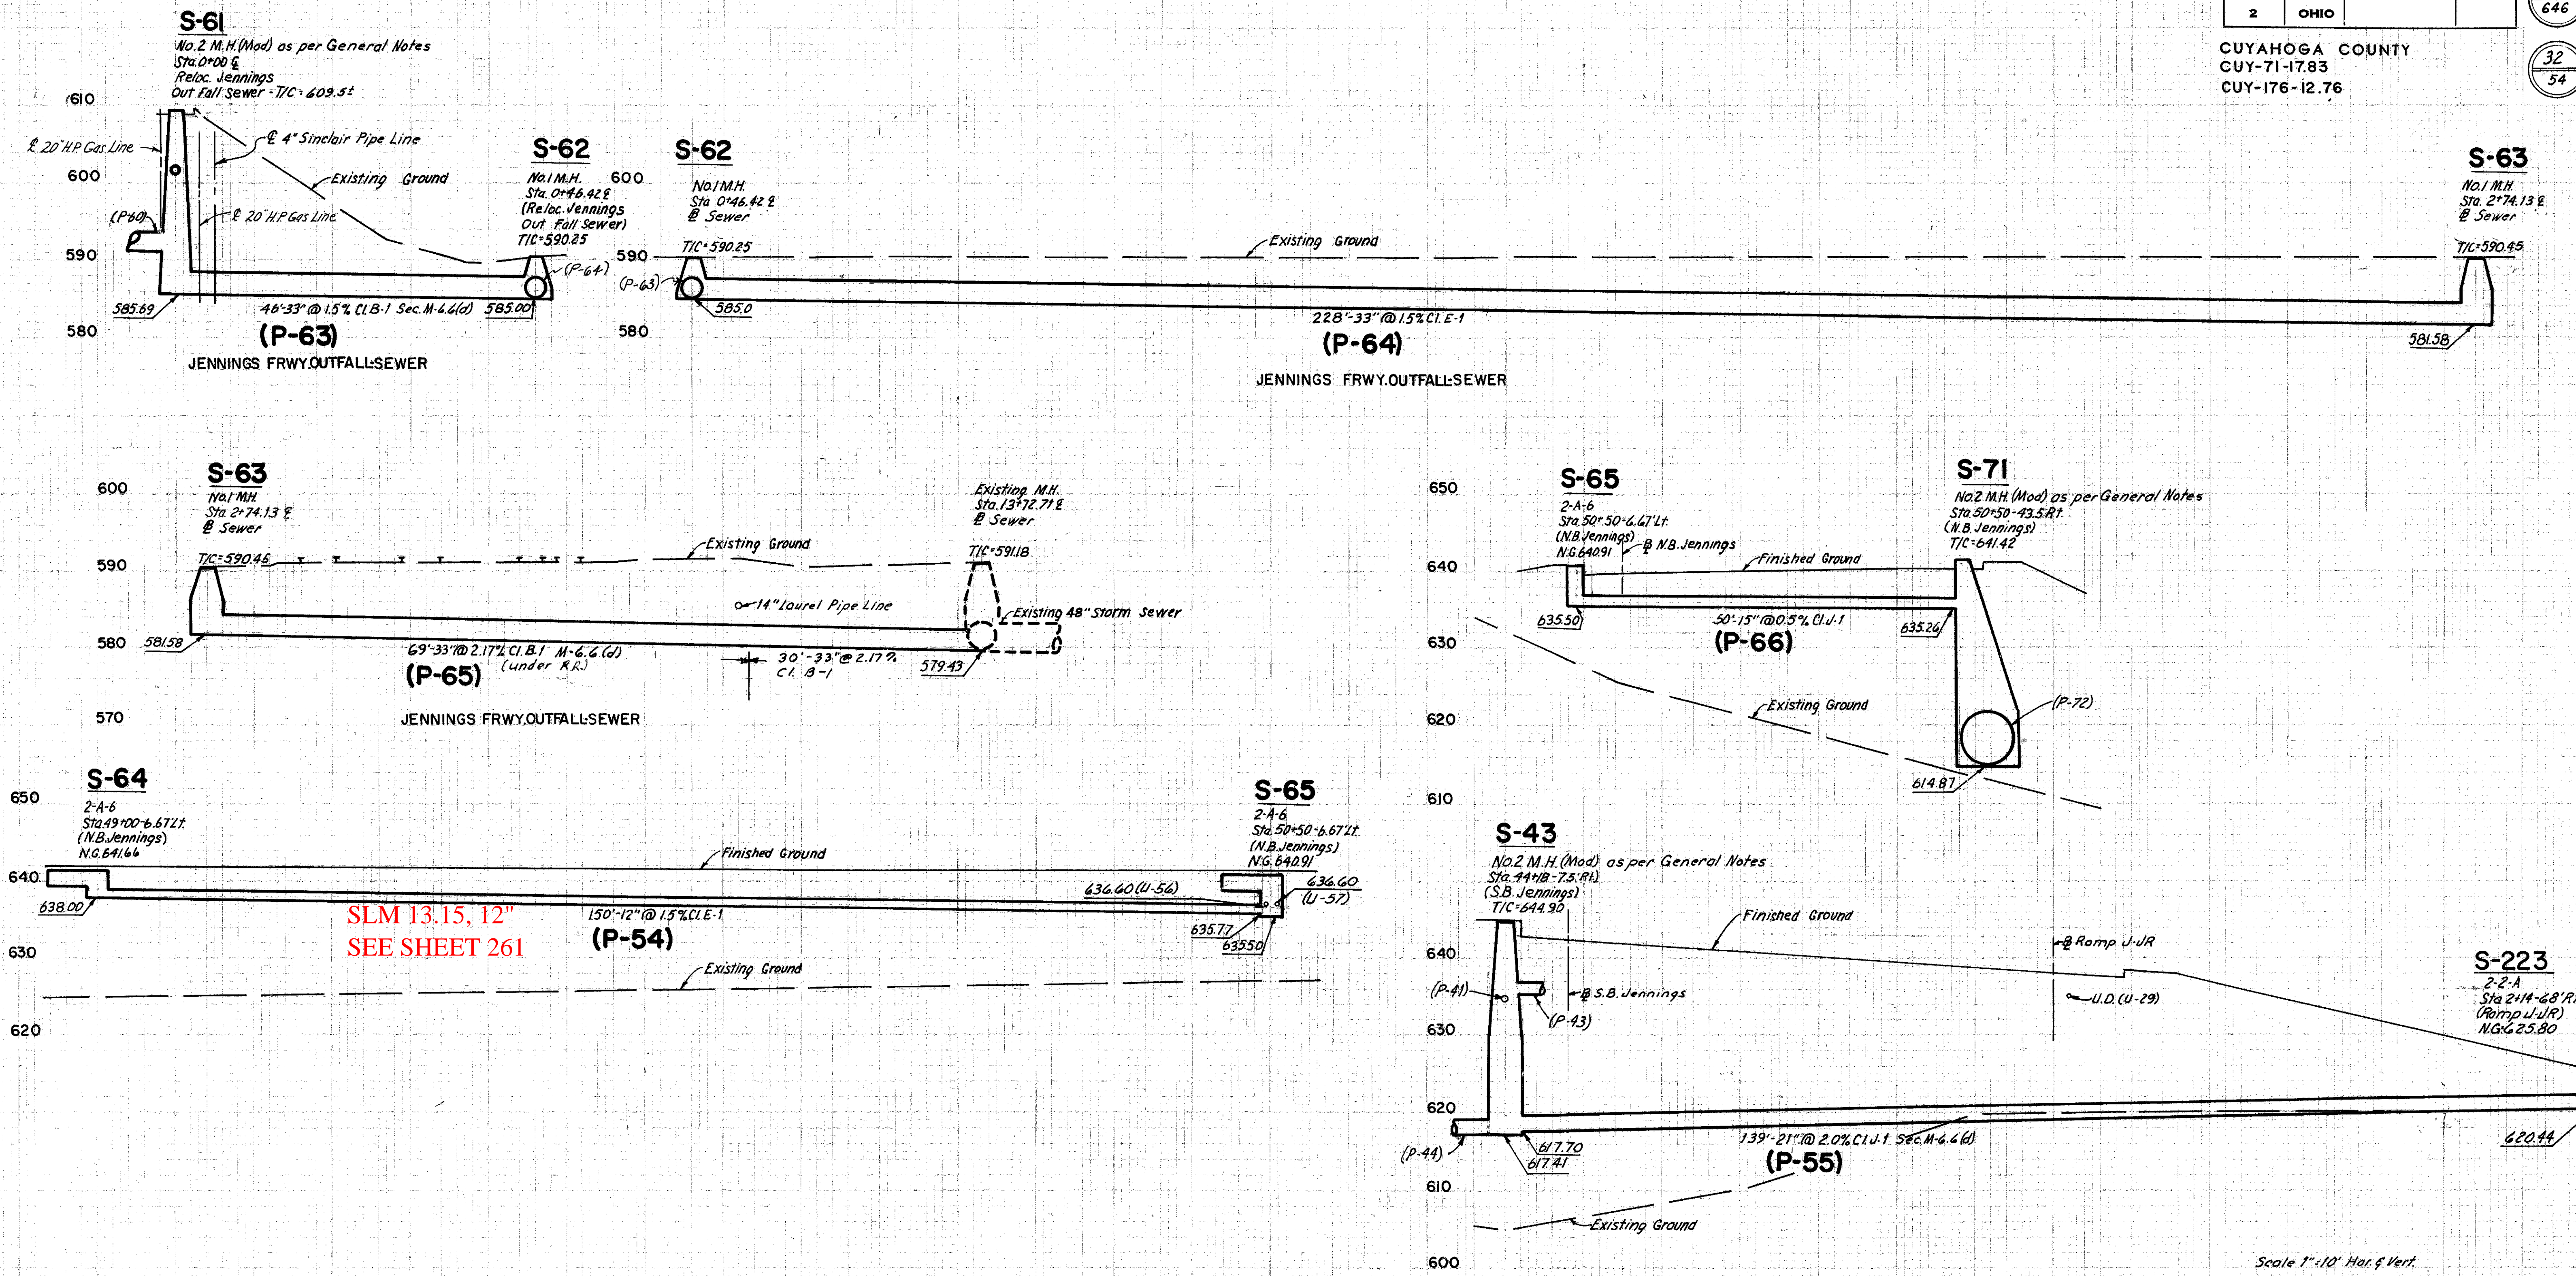

RDJ 8-21-64
JMO 10-22-64