


FED. RD. DIVISION	STATE	PROJECT
2	OHIO	

285  
646

34  
54

CUYAHOGA COUNTY  
CUY-71-17.83  
CUY-176-12.76

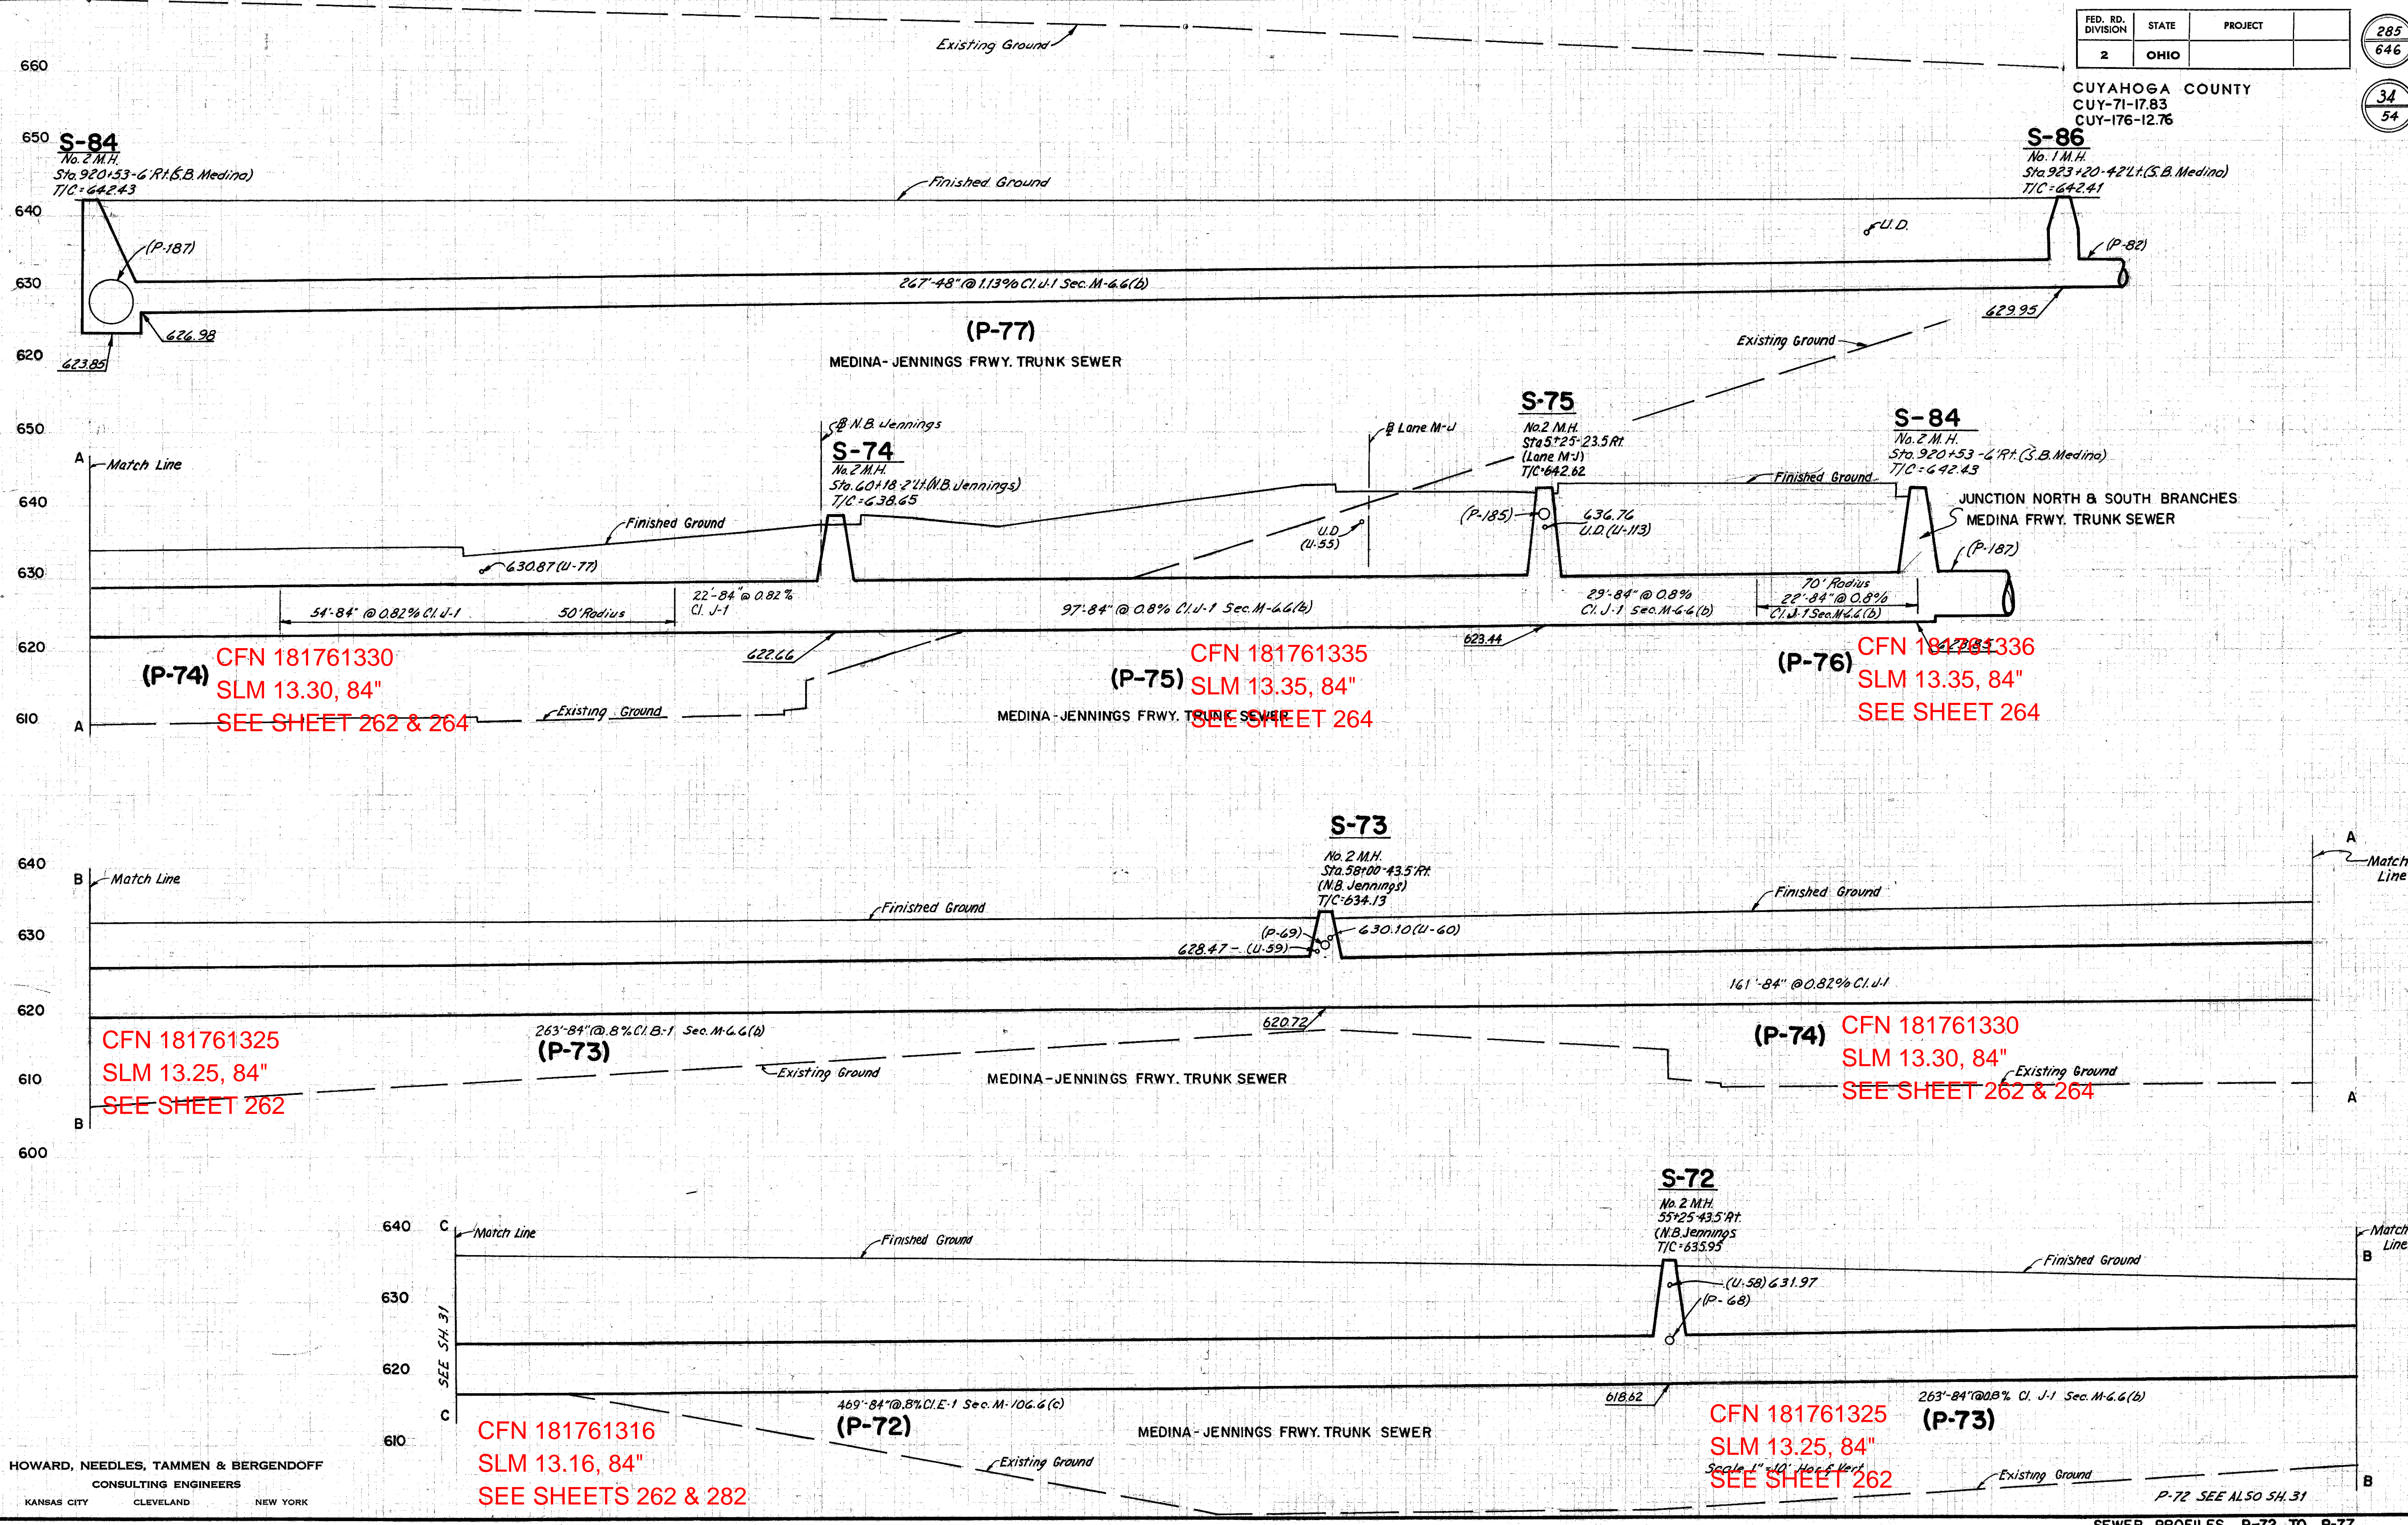

R.O.J. 10-9-68  
L.M.O. 10-14-68

HOWARD, NEEDLES, TAMMEN & BERGENDOFF  
CONSULTING ENGINEERS  
KANSAS CITY CLEVELAND NEW YORK