


CUYAHOGA COUNTY
CUY - 90 - 8.34

GA=4

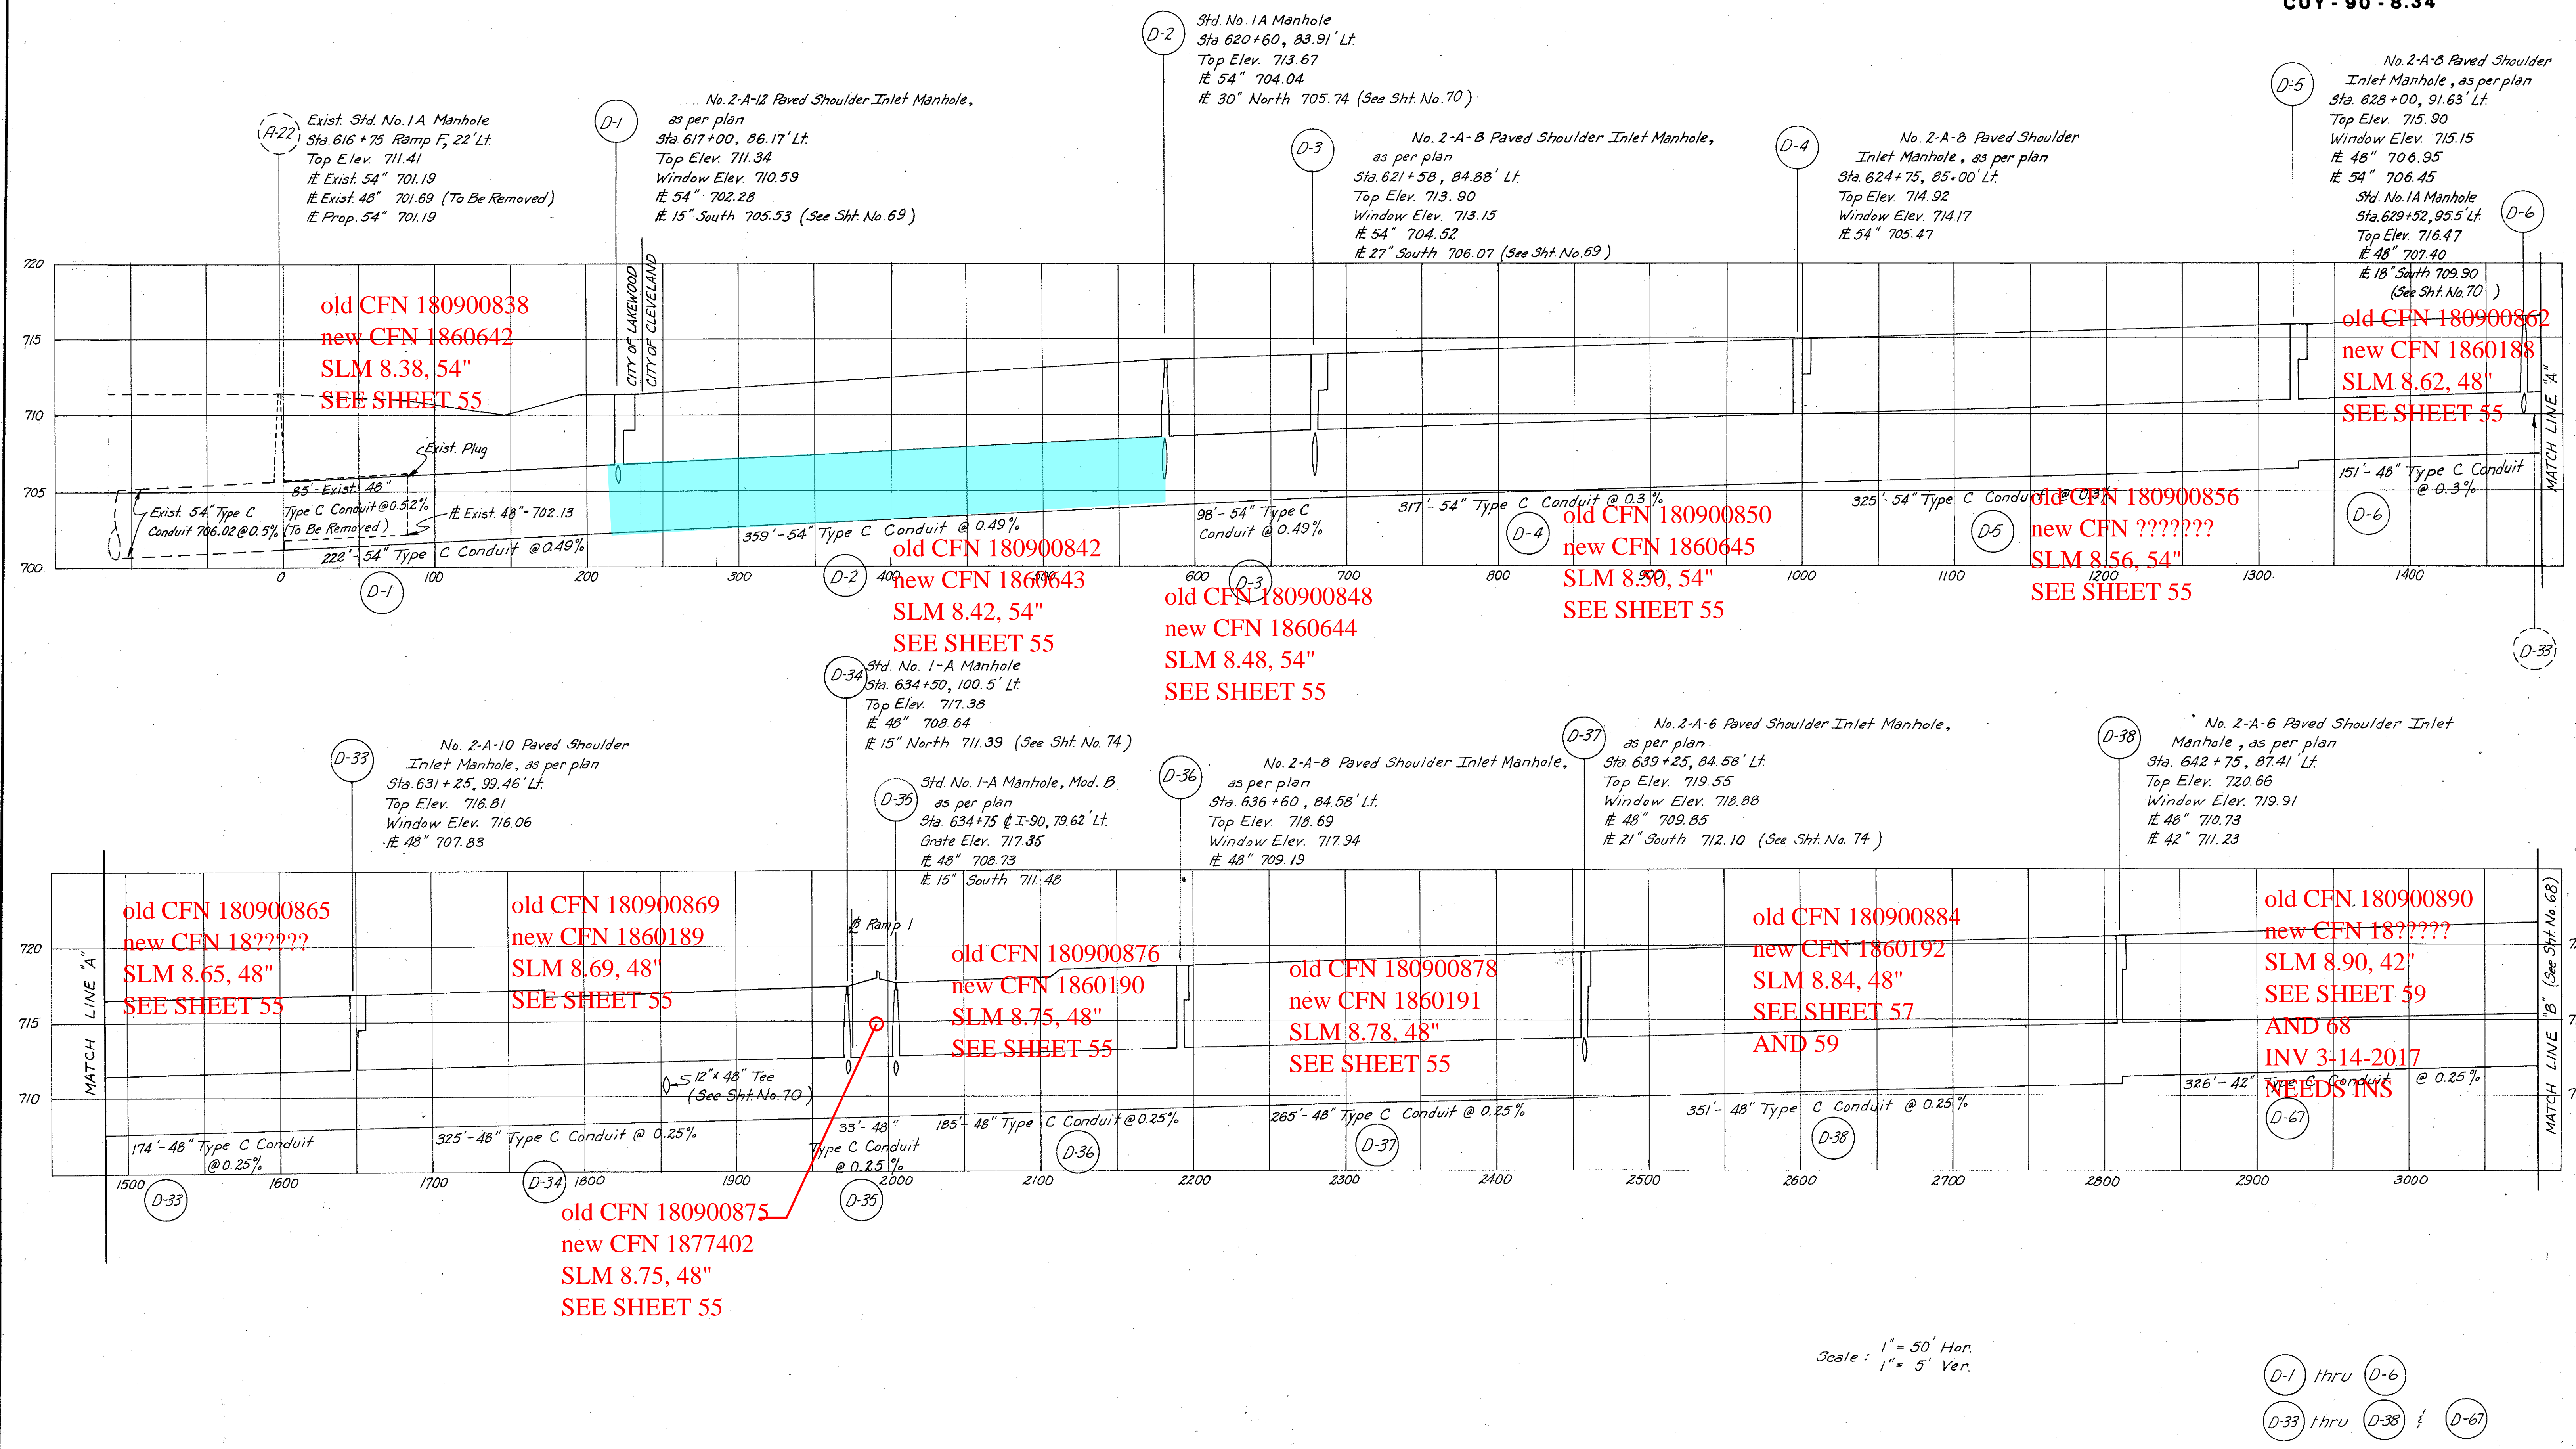

Scale: 1" = 50' Hor.
1" = 5' Ver.

D-1 thru D-6
D-33 thru D-38 & D-67