


SLM 7.75, 54"  
SEE BELOW

SLM 7.86, 54"  
SEE BELOW

SLM 7.83, 15"  
SEE SHEET 473

SLM 7.86, 15"  
SEE BELOW

SEE 1977 CUY-77-6.35 PLANS  
FOR THE ORIGINAL CONSTRUCTION  
OF CULVERTS AND STORM SEWERS

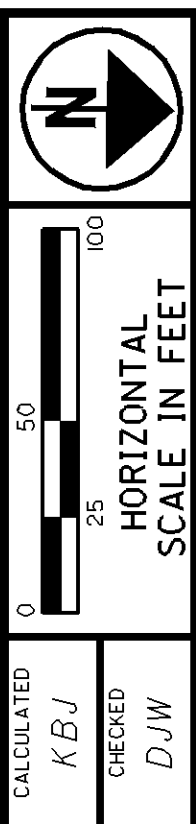

SLM 7.75, 24"  
SEE SHEET 471

SLM 7.91, 54"  
SEE R/W SHEET 342  
FROM CUY-77-6.35  
FOR EASEMENT

SLM 7.86, 33"  
SEE SHEET 474

SLM 7.95, 15"  
SEE SHEET 474

SLM 7.89, 15"  
SEE SHEET 474

SLM 7.86, 33"  
SEE SHEET 474


SLM 7.86, 27"  
SEE SHEET 474

SLM 7.75, 21"  
SEE BELOW

SLM 7.75, 24"  
SEE SHEET 471

SLM 7.75, 15"  
SEE BELOW

SEE SHEET 472

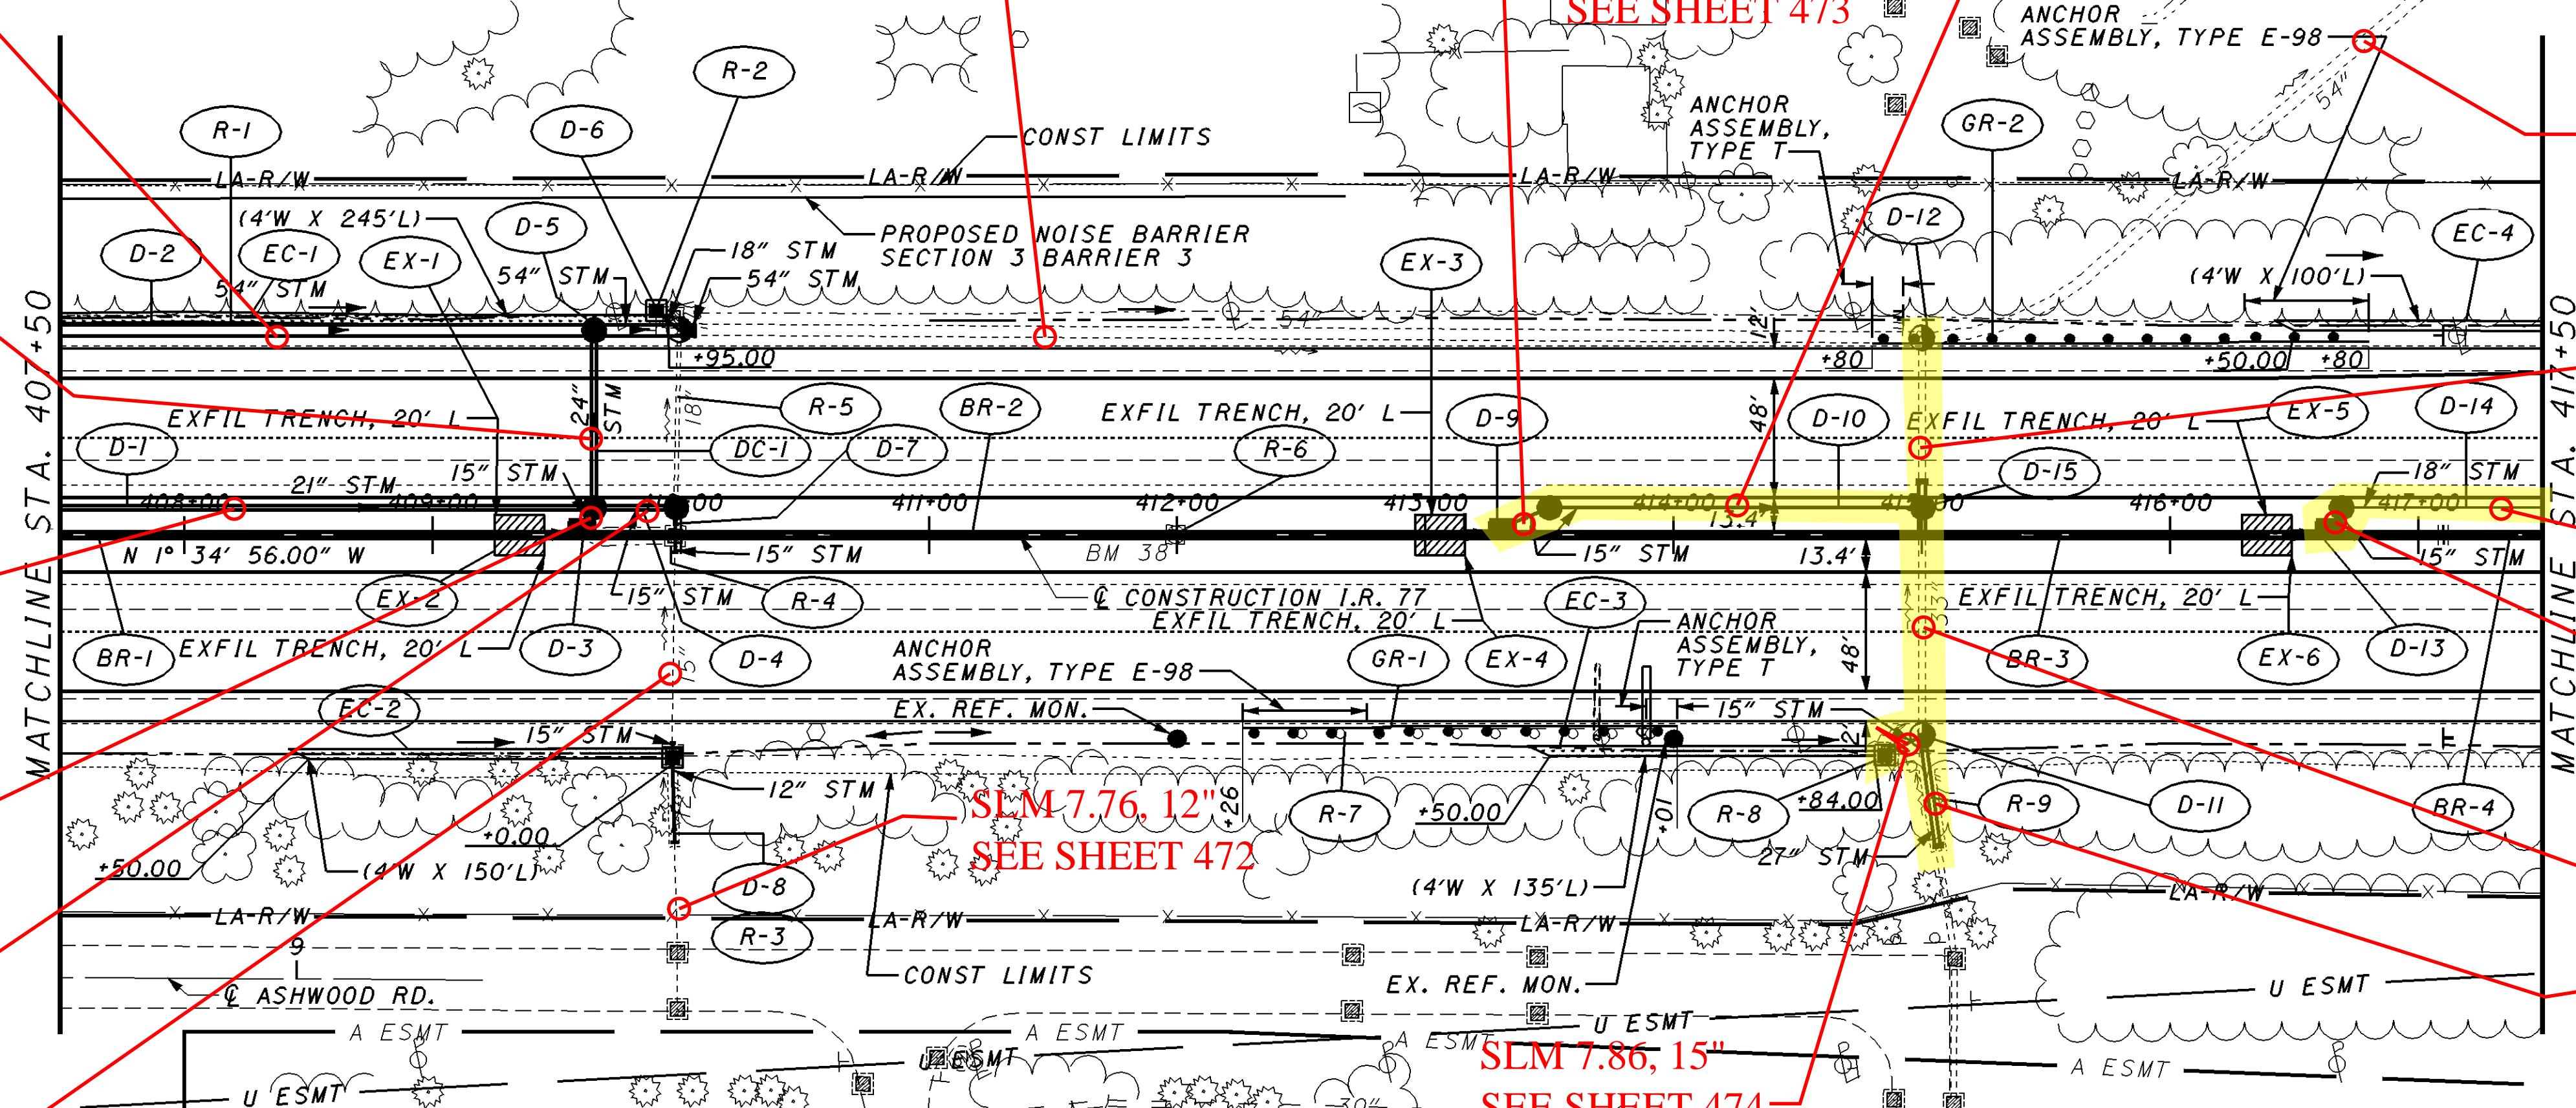

SOUTH BOUND PROFILE




FOR REFERENCE TIES SEE SHEET 7  
FOR GEOMETRIC LAYOUT SEE SHEETS 8 TO 13  
FOR TYPICAL SECTIONS SEE SHEETS 14 TO 30  
FOR CROSS SECTIONS SEE SHEETS 349 TO 489  
FOR UNDERDRAIN PLAN SEE SHEETS 643 TO 658  
FOR CALCULATIONS AND QUANTITIES SEE SHEETS 223 TO 285  
FOR MAINTENANCE OF TRAFFIC PLANS SEE SHEETS 43 TO 217  
FOR SIGNING AND PAVEMENT MARKING PLANS SEE SHEETS 735 TO 768  
FOR NOISE BARRIER PLANS SEE SHEETS 985 TO 1010

**LEGEND**

- [Cross-hatched pattern] ROCK CHANNEL PROTECTION
- [Stippled pattern] DITCH EROSION PROTECTION

**PLAN AND PROFILE**  
**STA. 407+50.00 TO STA. 417+50.00**

**CUY-77-1.89**

I:\PROJECTS\PI\22222\dgn\TSC\_2008-03-10\22222-034.dgn 11-MAR-2008 8:52AM ekenzig