






FED. RD. DIVISION	STATE	PROJECT
2	OHIO	

275  
646

CUYAHOGA COUNTY  
CUY-71-1783  
CUY-176-12.76

24  
54

R.D.L. 8-11-64  
U.M.C. 10-19-64

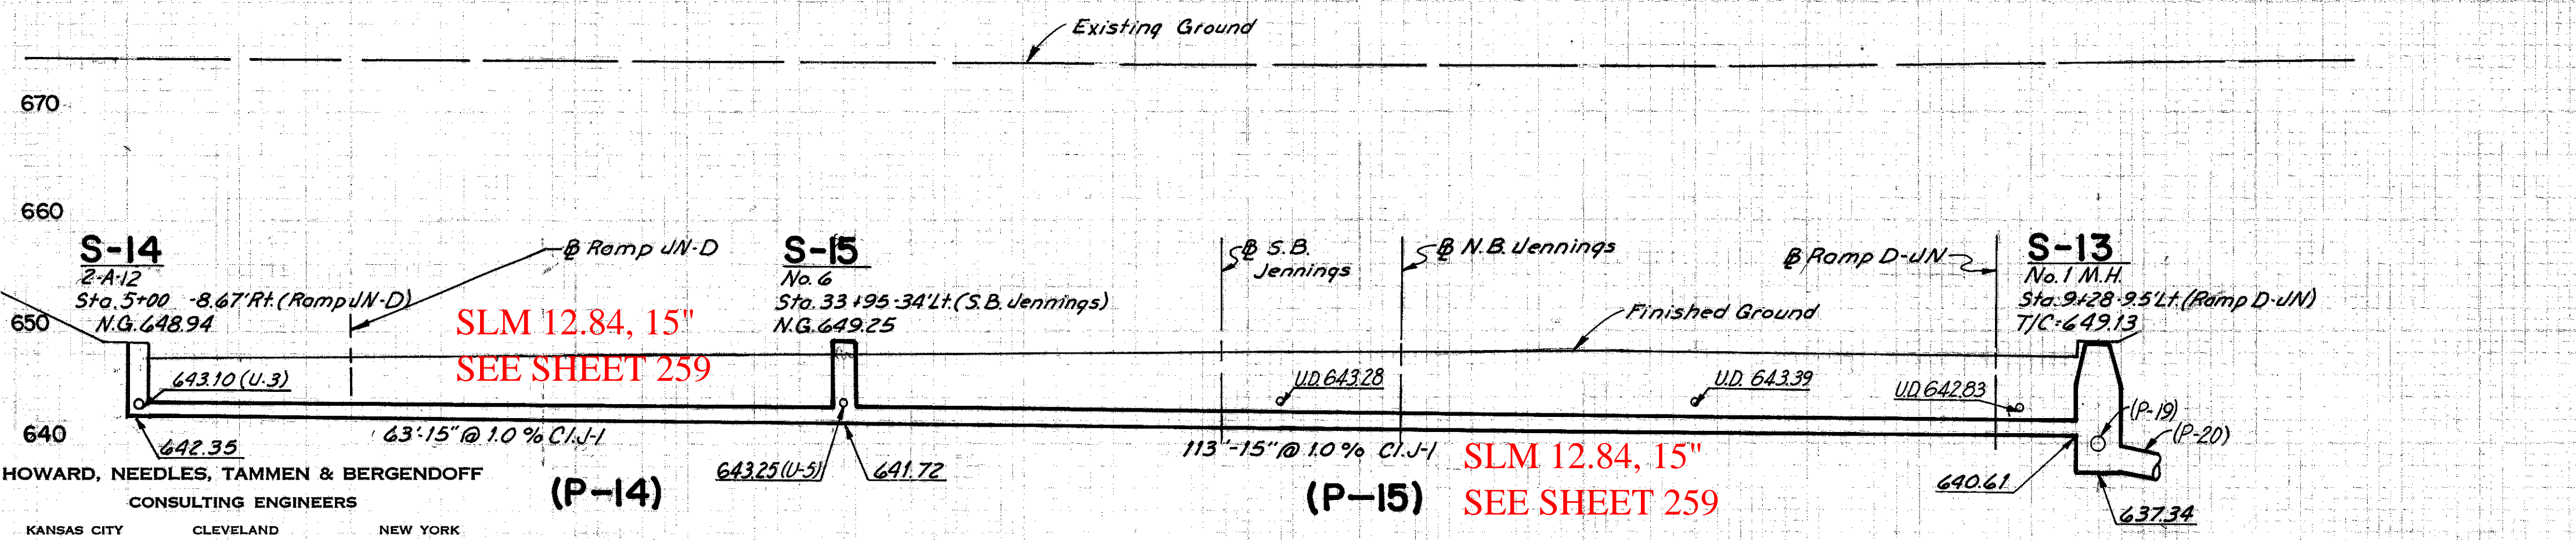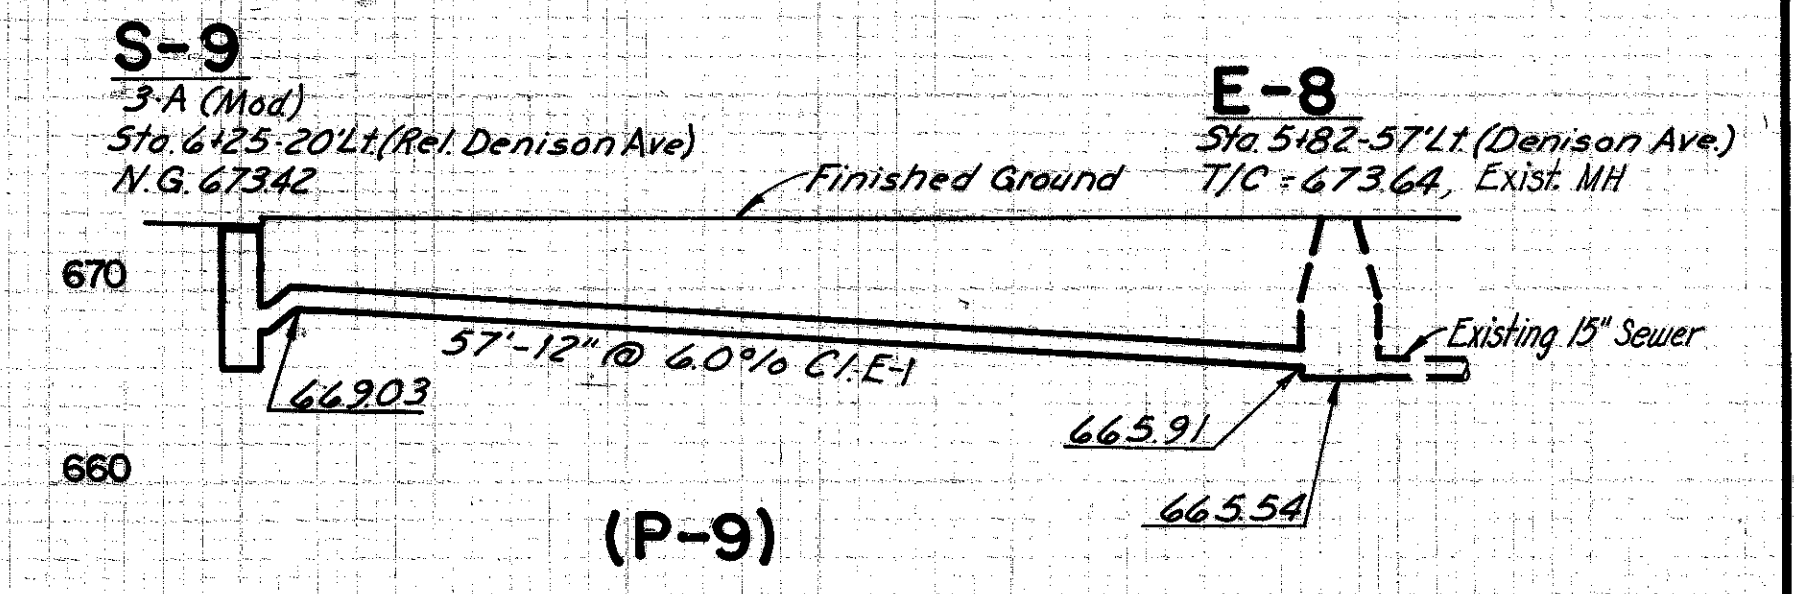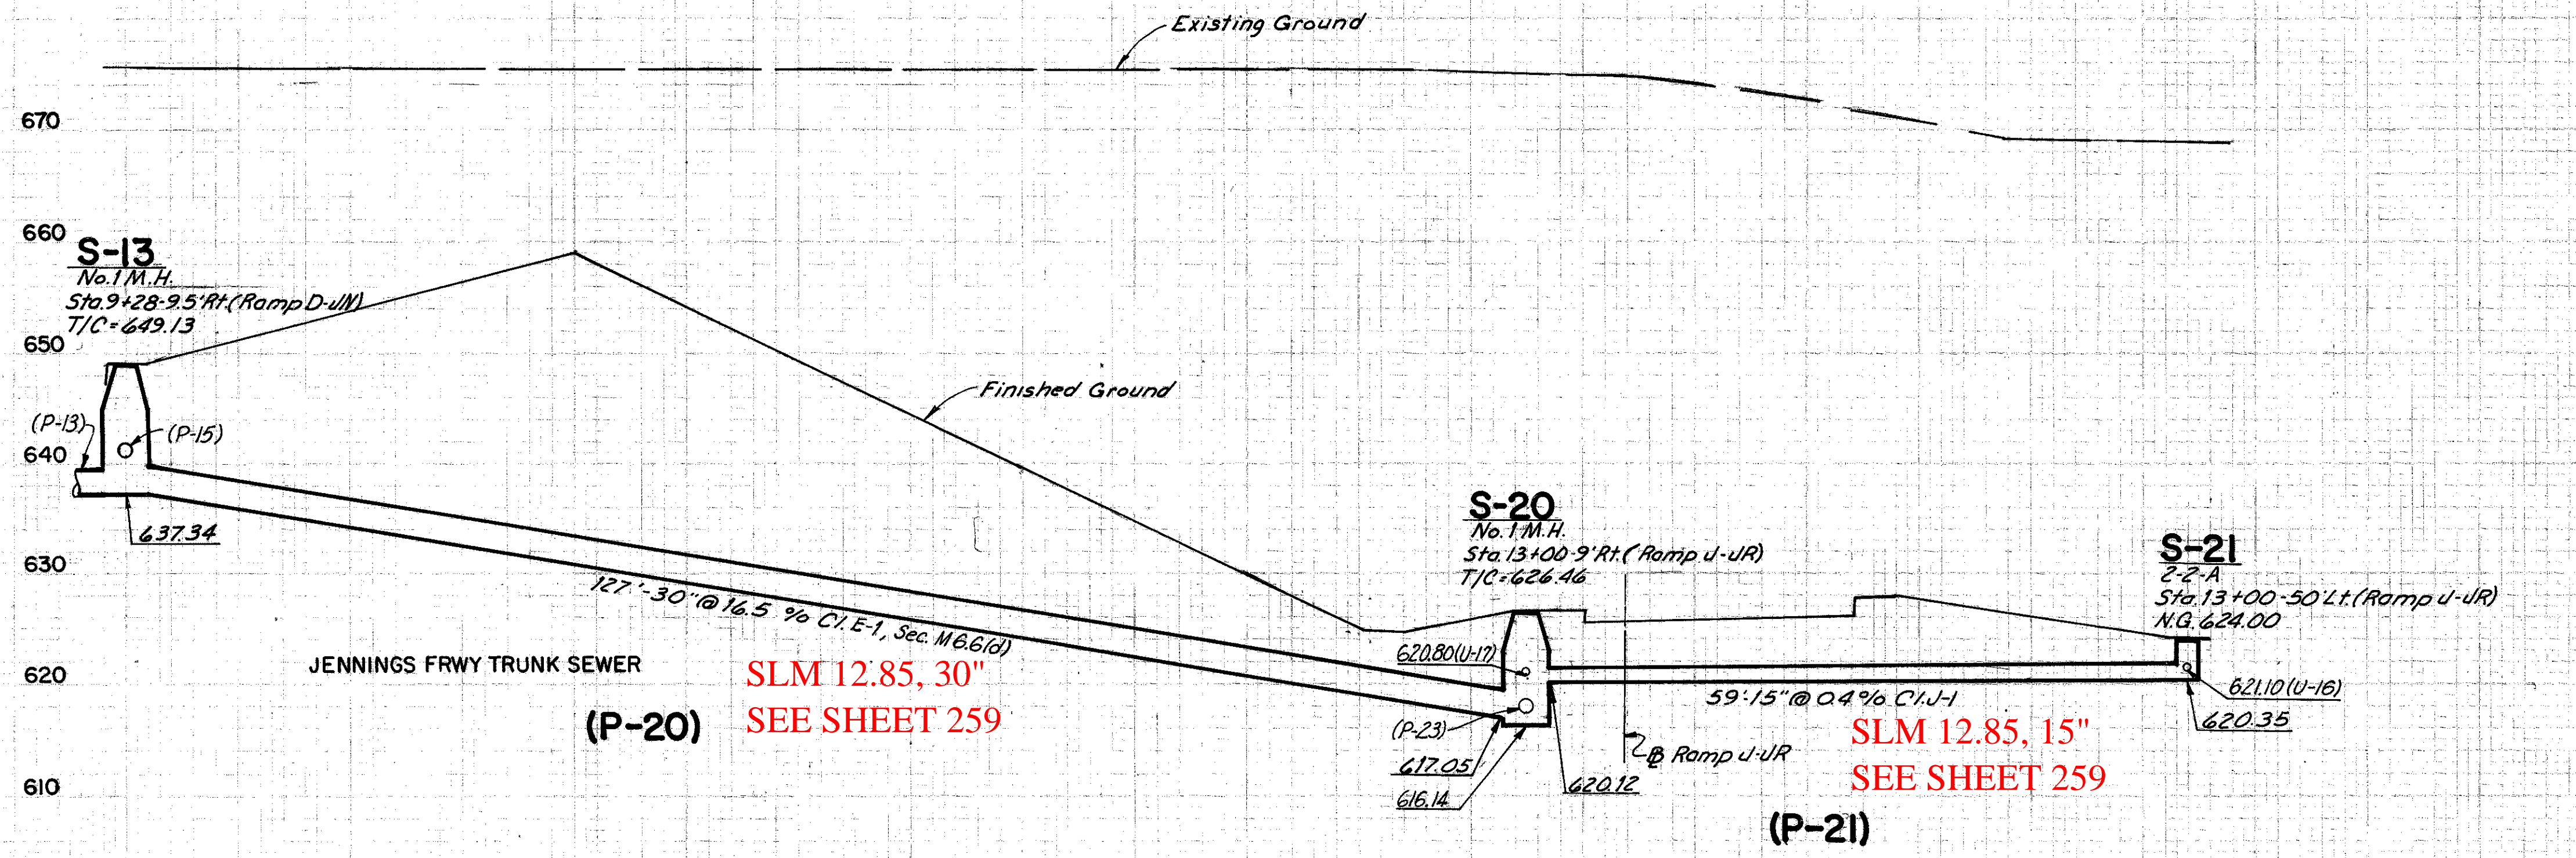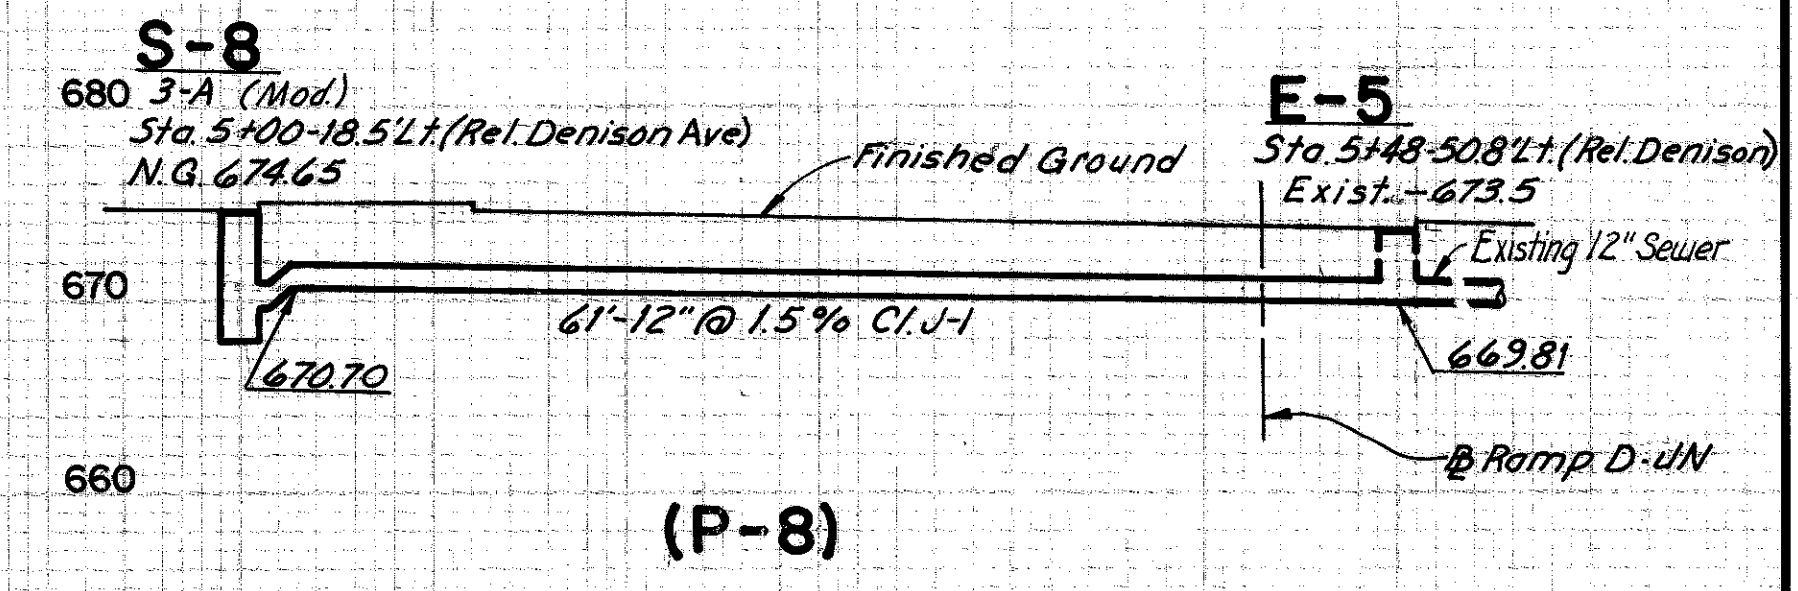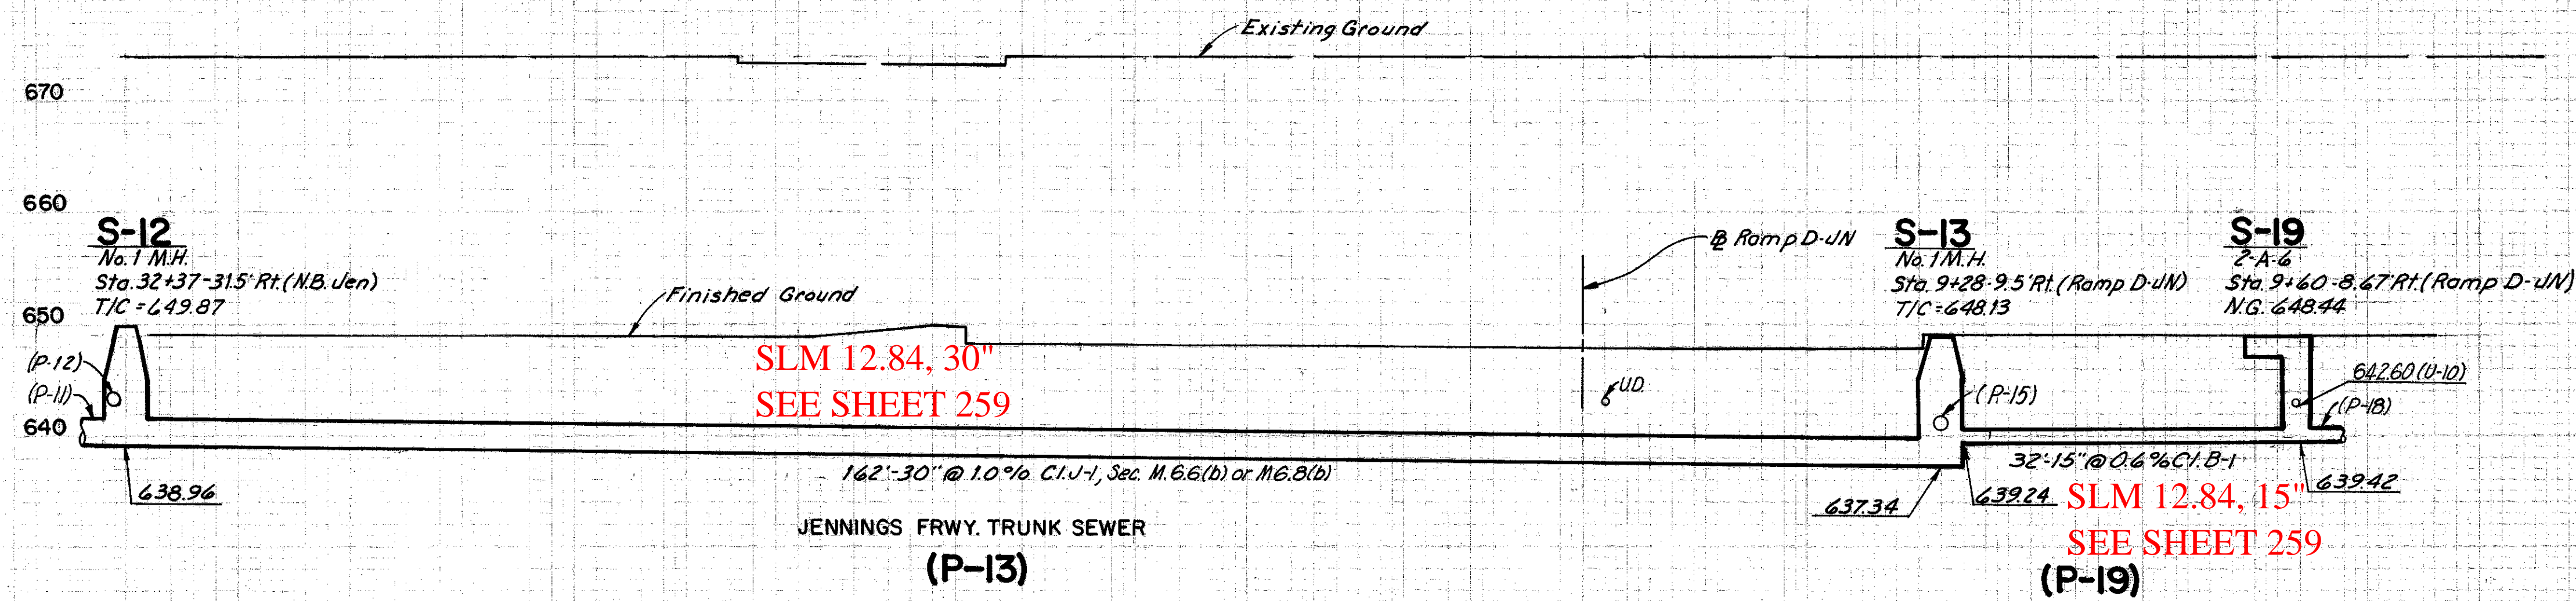

Scale 1" = 10' Hor. & Vert.

P-10 to P-12 SEE SH. 23  
P-16 to P-18 SEE SH. 25