


FED. RD. DIVISION	STATE	PROJECT
2	OHIO	

279
646

CUYAHOGA COUNTY
CUY-71-17.83
CUY-176-12.76

28
54

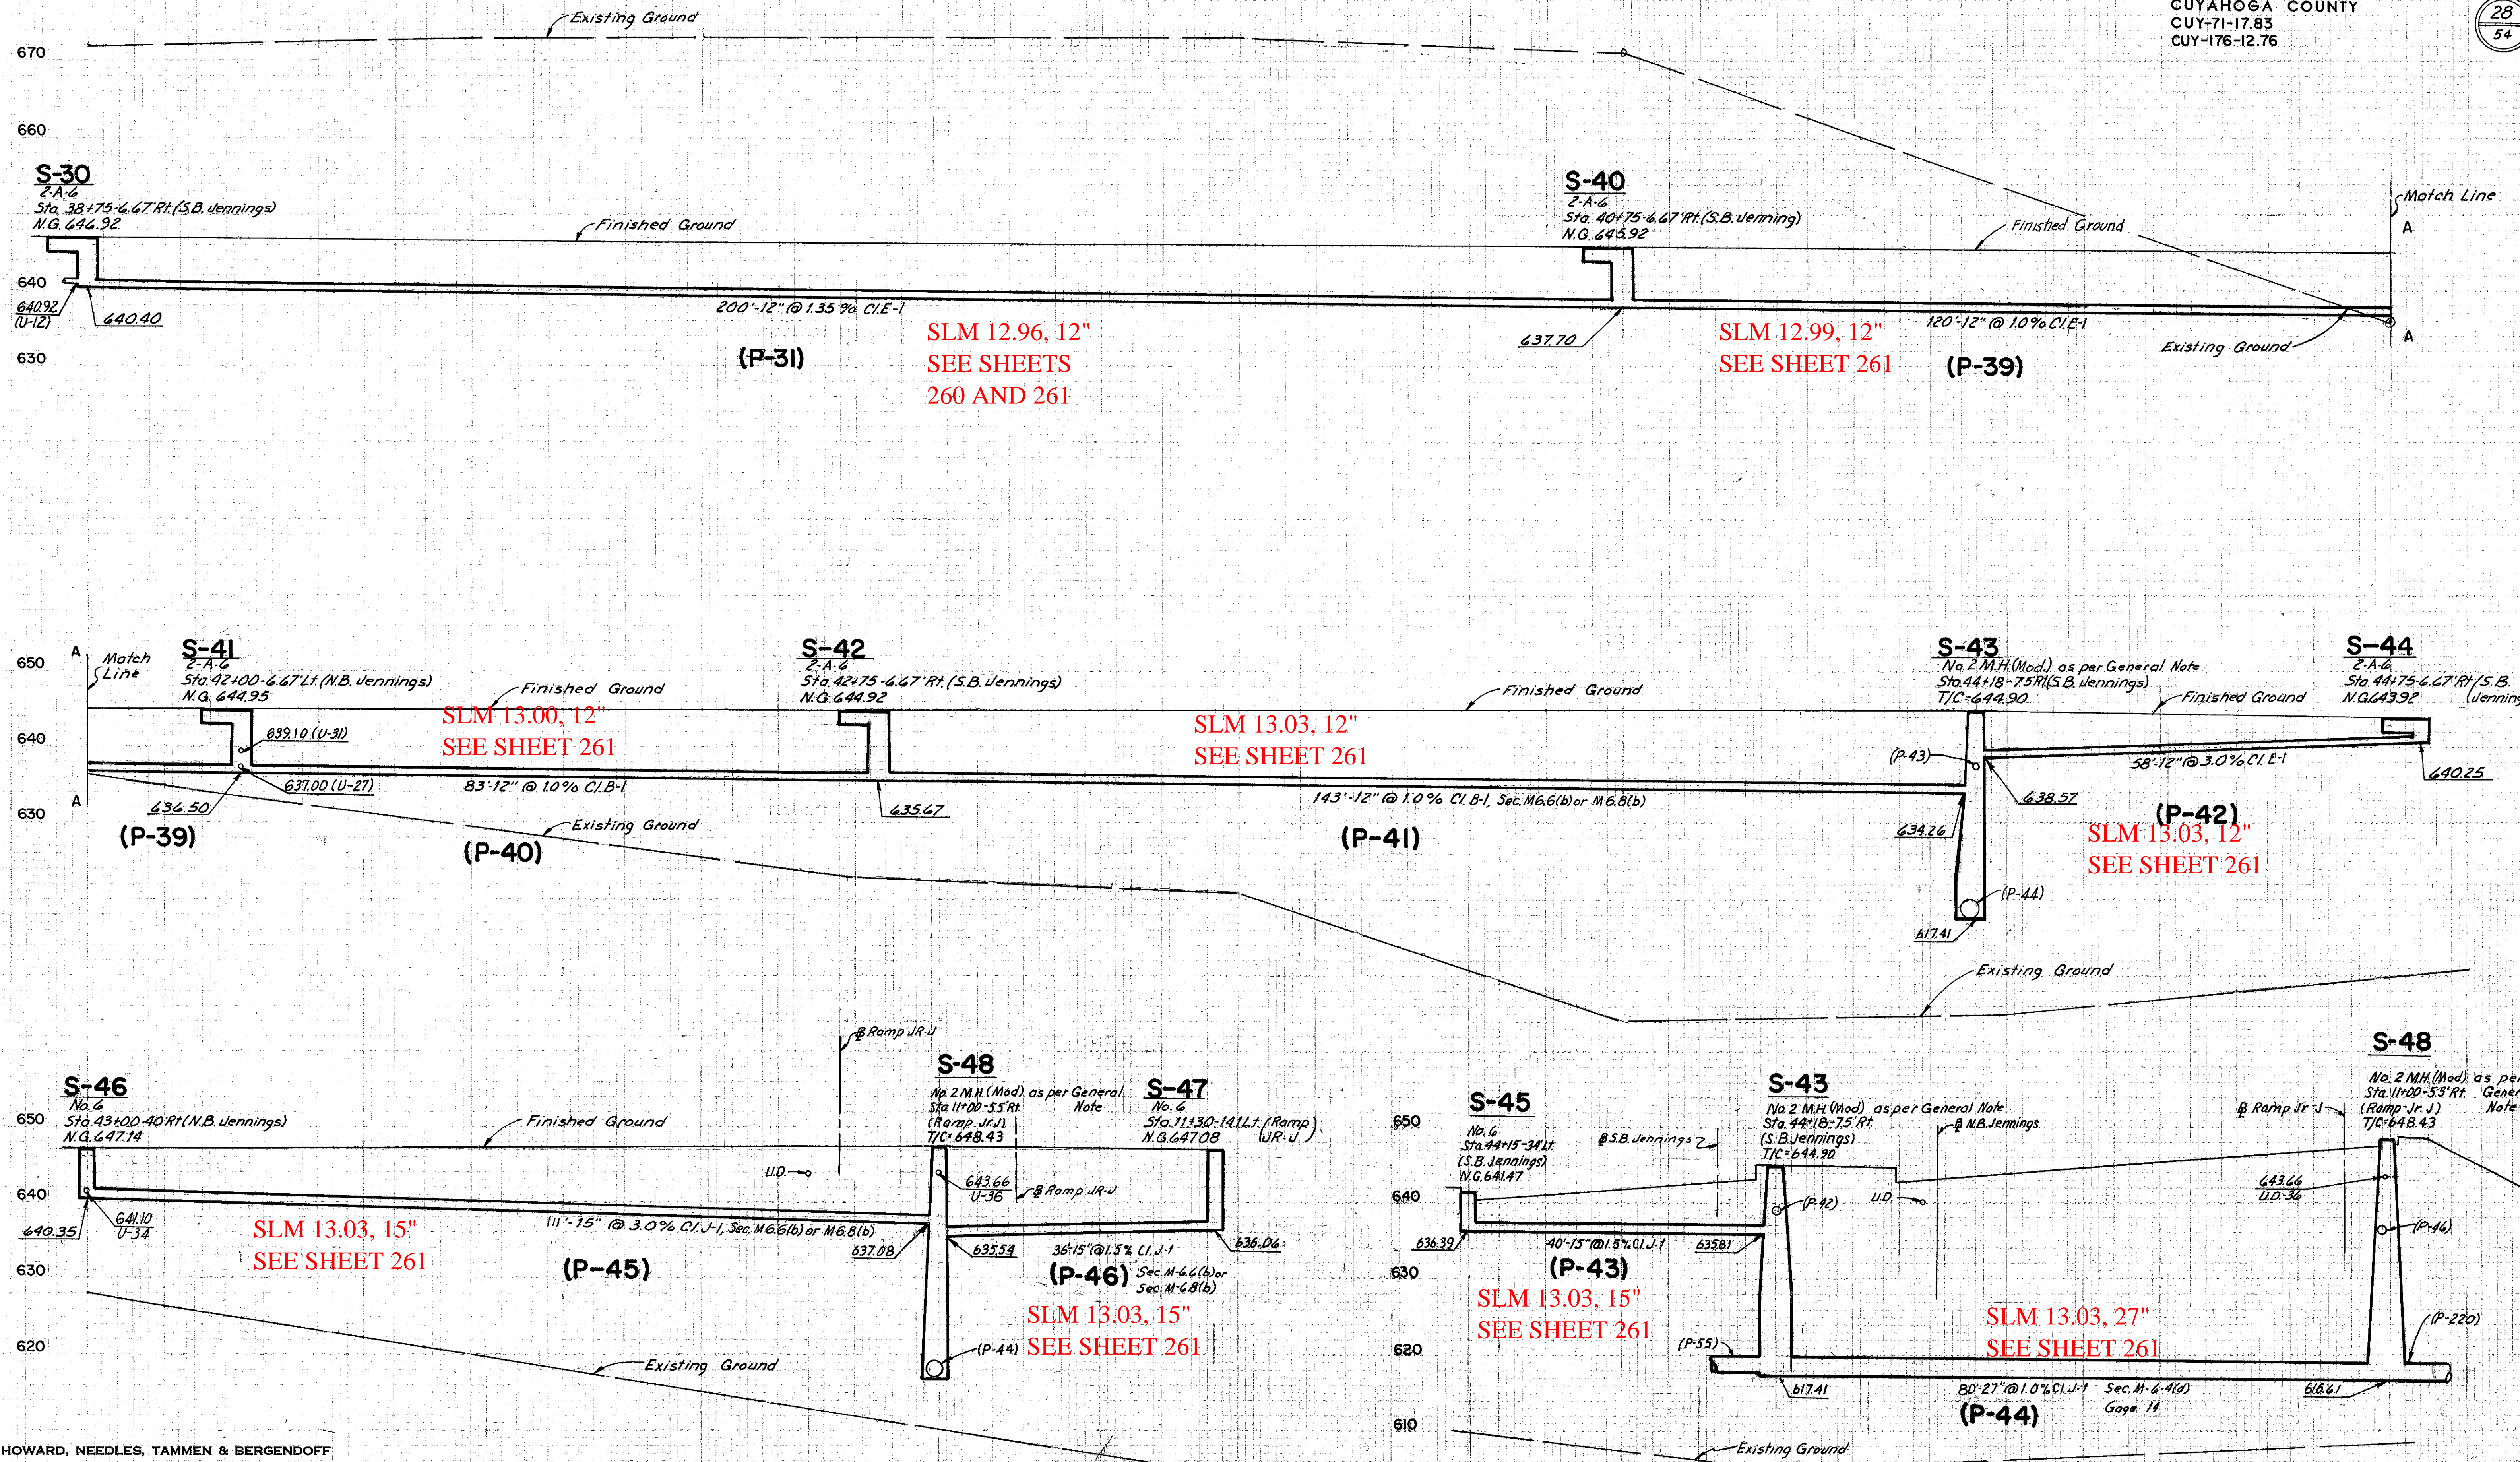

RD. J. 8-10-44 J.M.O. 10-22-44

HOWARD, NEEDLES, TAMMEN & BERGENDOFF
CONSULTING ENGINEERS
KANSAS CITY CLEVELAND NEW YORK

Scale 1"=10' Hor. & Vert. P-32 to P-38 SEE SH. 27