


FED. RD. DIVISION	STATE	PROJECT
2	OHIO	

CUYAHOGA COUNTY
CUY-480-18.43

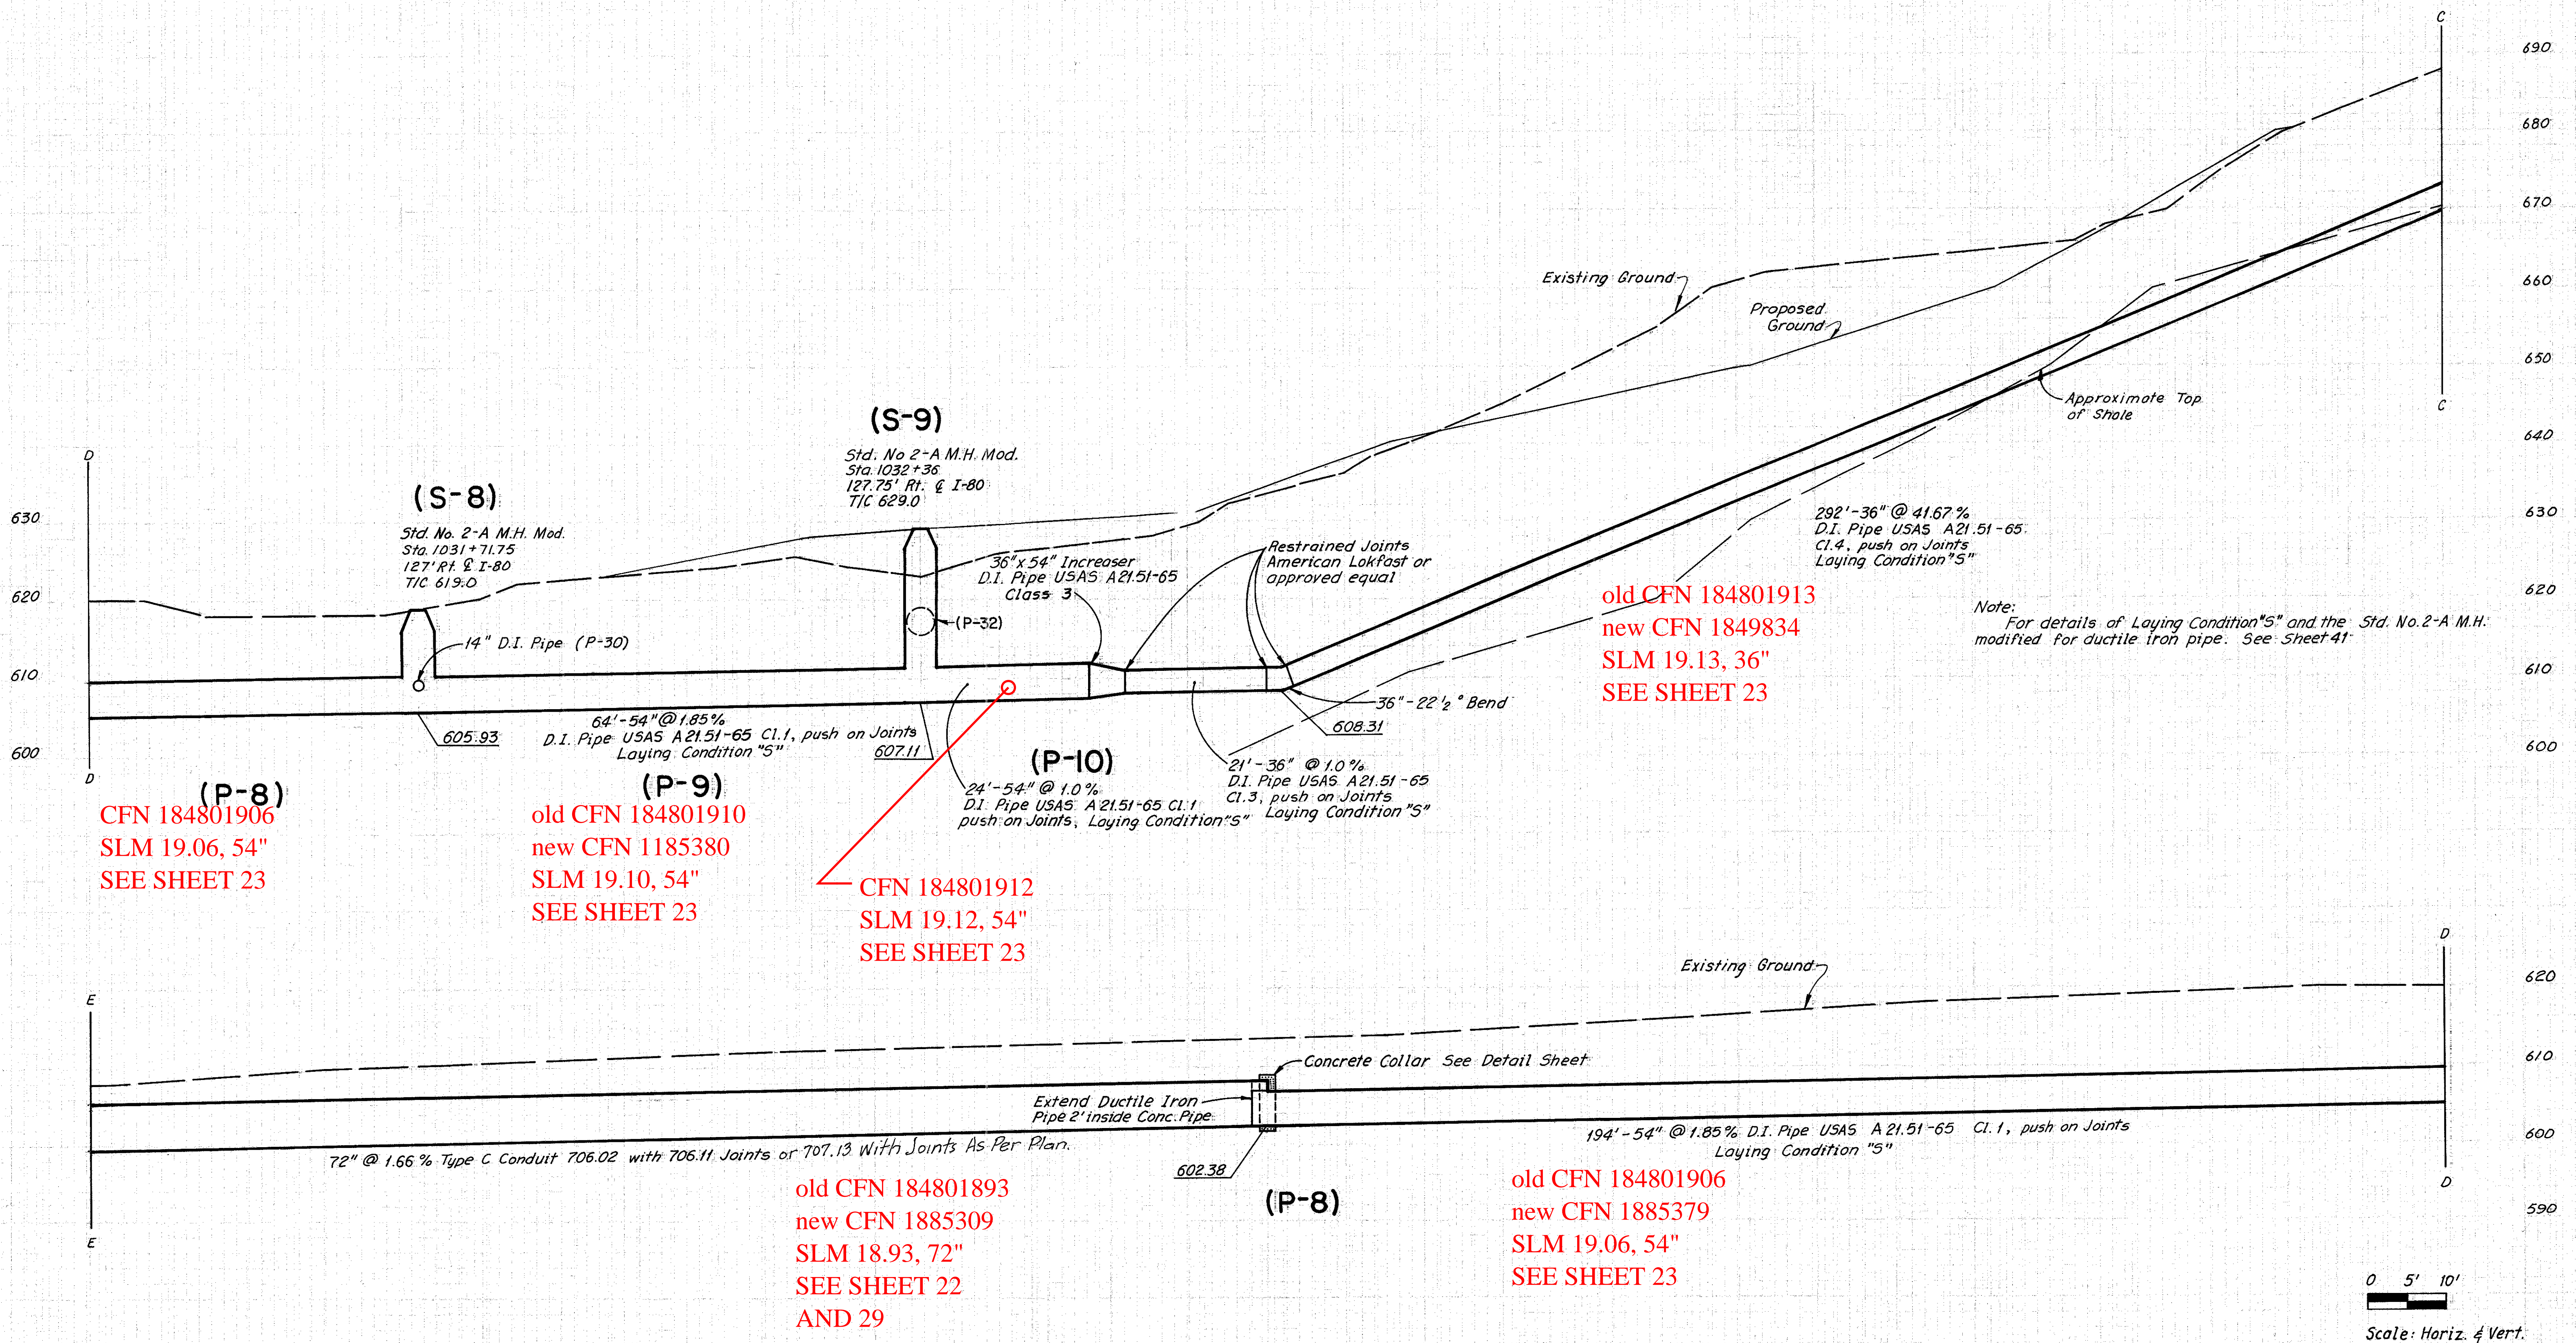

(P-8)
CFN 184801906
SLM 19.06, 54"
SEE SHEET 23

(P-9)
old CFN 184801910
new CFN 1185380
SLM 19.10, 54"
SEE SHEET 23


CFN 184801912
SLM 19.12, 54"
SEE SHEET 23

old CFN 184801893
new CFN 1885309
SLM 18.93, 72"
SEE SHEET 22
AND 29

old CFN 184801913
new CFN 1849834
SLM 19.13, 36"
SEE SHEET 23

old CFN 184801906
new CFN 1885379
SLM 19.06, 54"
SEE SHEET 23

Note:
For details of Laying Condition "S" and the Std. No. 2-A M.H. modified for ductile iron pipe. See Sheet 41

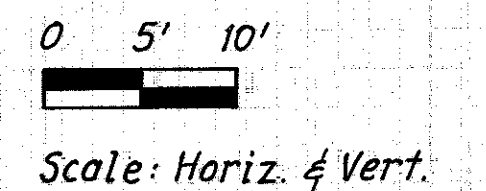

P.D.S./M.N.E.
10-17-89
J.M.C.
10-17-89
1M