FED. RD. DIVISION	STATE	PROJECT	TYPE FUNDS
2	OHIO	I-480-4(16)161	

17 / 120

CUYAHOGA COUNTY

CUY-480-6.48

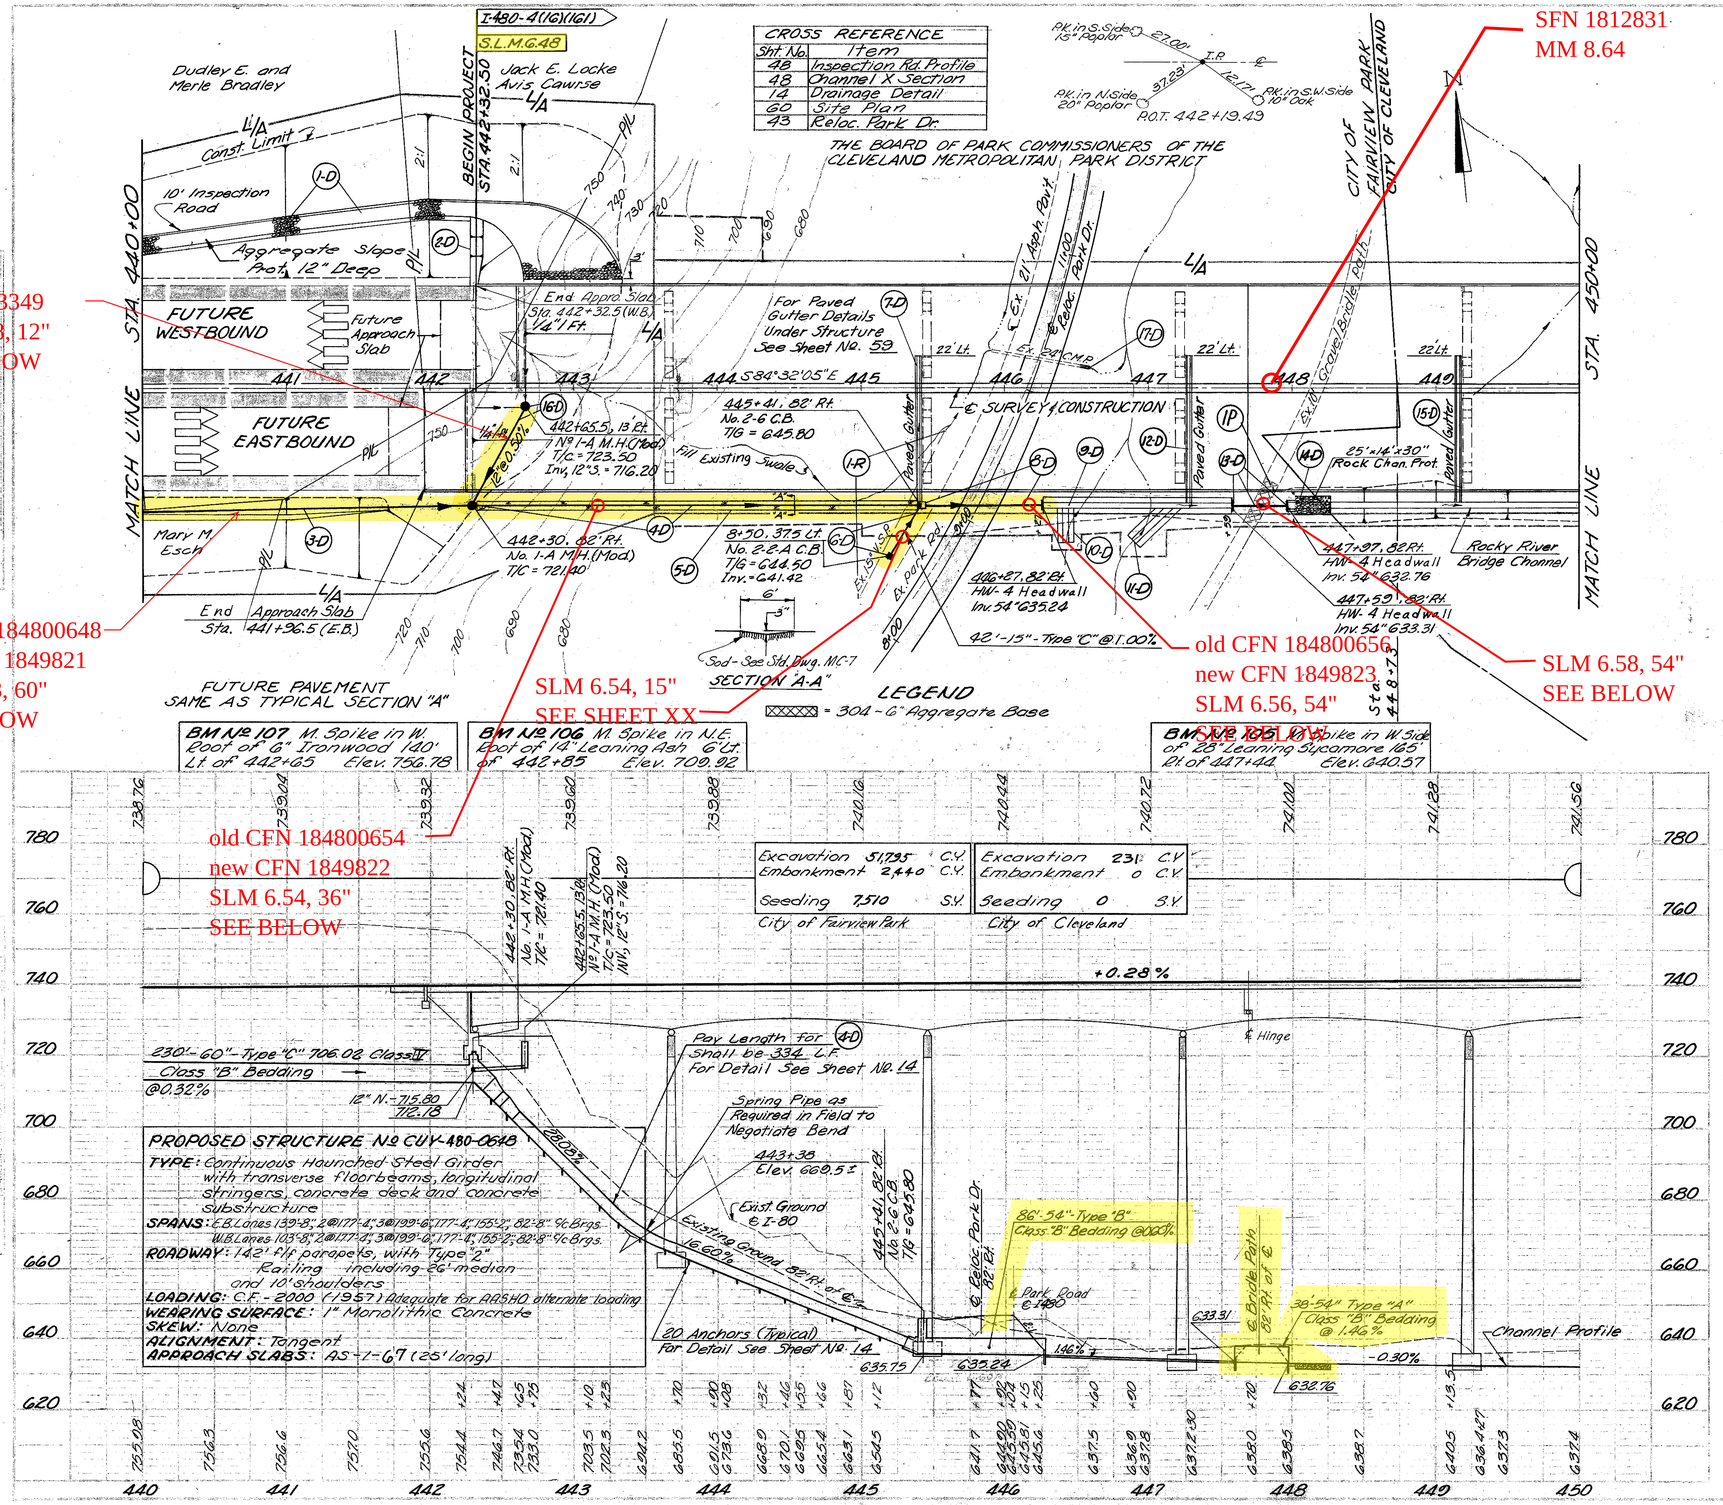

		Part No.	Side	Location	604 Nº 1-A M.H. Mod. (Sp. Fr. & Cov.) Ea.	604 Nº 2-6 C.B. ✱ Ea.	604 Nº 2-2-A C.B. Ea.	604 66"×48" Conduit Reducer Type "F" 707.04 Class "B" Bedding L.F.	604 48"×36" Conduit Reducer Type "F" 707.04 Class "B" Bedding L.F.	604 Type "F" 707.04 Encased as per plan 36" L.F.	604 Type "F" 707.04 Class "B" Bedding 66" L.F.	604 Type "F" 707.04 Class "B" Bedding 36" L.F.	603 Type "C" 706.02 Class IV 60" L.F.	603 Type "C" 15" L.F.	603 Type "C" 18" L.F.	603 Type "B" 54" L.F.	603 Type "A" 54" L.F.	602 Concrete Masonry C.Y.	601 6" Reinf. Concrete Riprap S.Y.	601 Paved Gutter Type 1-2 L.F.	601 Rock Channel Protect. C.Y.	601 Aggregate Slope Protection S.Y.	603 Type "F" 707.04 24" L.F.	602 Pipe Removed 24" & Under L.F.
DRAINAGE		1-D	Lt.	440+00 to 443+35		1																	
		2-D	Lt.	442+32.50			1																
		3-D	Rt.	440+00 to 442+30				16															
		4-D	Rt.	442+30 to 445+41					12														
		5-D	Rt.	442+30 to 445+41					12														
		6-D	Rt.	8+50 (Reloc. Park Dr.)						12													
		7-D	Lt/Rt.	445+41							8												
		8-D	Rt.	445+41 to 446+27								334											
		9-D	Rt.	446+27 to 447+59									230										
		10-D	Rt.	446+43										48									
		11-D	Rt.	446+92 to 447+14											80								
		12-D	Lt/Rt.	447+28												86							
		13-D	Rt.	447+59 to 447+97													38						
		14-D	Rt.	447+97 to 448+12														3.99					
		15-D	Lt/Rt.	449+15															296				
		16-D	Rt.	442+30 to 442+65.5																312			
		17-D	Lt.	446+59 to 446+60																	39		
		1-R		444+07.58 to 445+58																		765	
				TOTAL																			6
																							135

* Side Inlet, on north side only

		Part No.	Side	Location	604 Special Berm & Slope Protection S.Y.	604 Sodding S.Y.	604 Aggregate Base C.Y.
ROADWAY & DRAINAGE		2-D	Lt.	442+32.50	47		
		5-D	Rt.	442+30 to 445+41	205		
		7-D	Lt/Rt.	445+41		35	
		9-D	Rt.	446+27 to 447+59		43	
		12-D	Lt/Rt.	447+28		35	
		15-D	Lt/Rt.	449+15		35	
		1-P	Rt.	447+68 to 447+86			8
				TOTAL			8
					252	148	

NOTE: VERT. SCALE: 1" = 20'

E.J.K. 3-8-67
H.J.H. ~~3-13-68~~
Rev. 10-22-70 REV. 10-14-70

PLAN & PROFILE STA. 440+00 TO STA. 450+00