

SLM 22.29, 12"
MM 24.46
SEE SHEET 92

SLM 22.13, 12"
MM 24.30
SEE SHEET 90

SLM 22.13, 18"
MM 24.30
SEE SHEET 91

SLM 22.13, 15"
MM 24.30
SEE SHEET 90

SLM 22.16, 12"
MM 24.33
SEE SHEET 90

CFN 1974765
SLM 22.13, 24"
MM 24.30
SEE SHEET 91



CFN 1974766
SLM 22.13, 24"
MM 24.30
SEE SHEET 91

SLM 22.13, 27"
MM 24.30
SEE SHEET 91

SLM 22.32, 12"
MM 24.49
SEE SHEET 92


SLM 22.27=MM 24.44

Note:
Do not disturb existing water pipe, under this Contract.

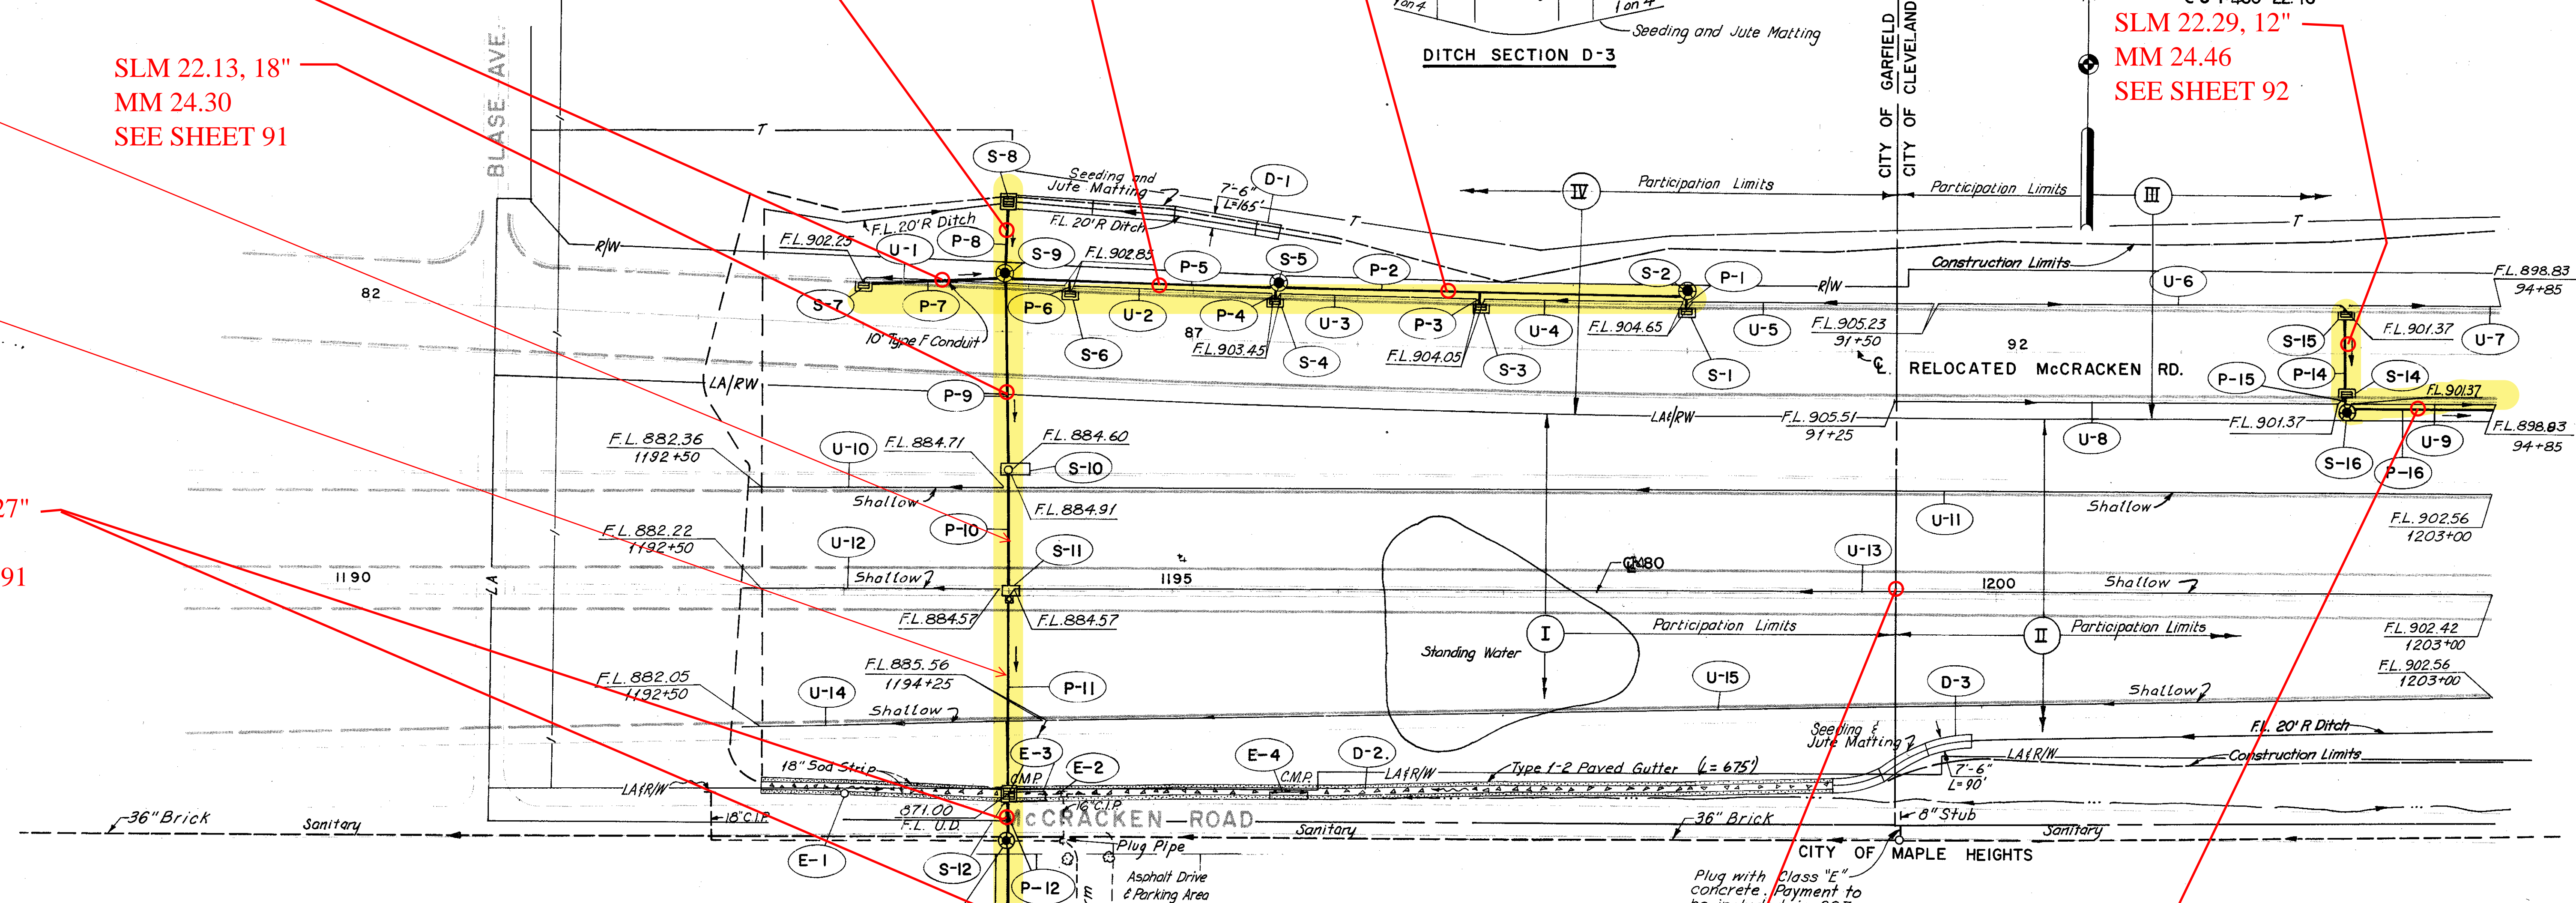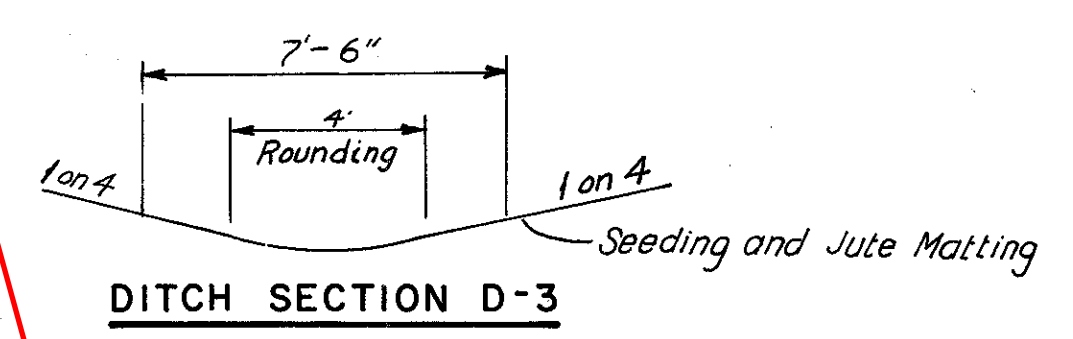

DRAINAGE LEGEND

- Proposed Storm and Sanitary Sewers
- Existing Storm Sewer and Sanitary Sewer
- Proposed Storm Manhole
- Proposed Sanitary Manhole
- Proposed Paved Shoulder Inlet
- Proposed Paved Shoulder Inlet Manhole
- Proposed Ditch Catch Basin
- Proposed Pavement Catch Basin
- Existing Storm and Sanitary Manhole
- Existing Storm Inlet
- Seeding and Jute Matting
- Paved Gutter
- Sodding
- Top of Cut Slope
- Toe of Fill Slope

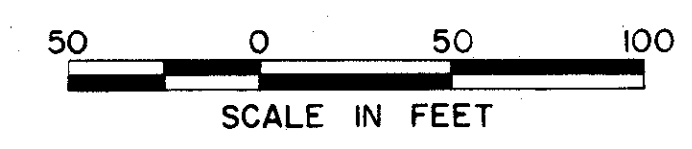

SCALE 1"=50'
HOWARD, NEEDLES, TAMMEN & BERGENDOFF
MADE D.D. DATE 1-2-68 CONSULTING ENGINEERS
TRCD DATE DATE
C.K.D. DATE 9-21-69 KANSAS CITY, CLEVELAND, NEW YORK

Note: All existing sewer pipes are storm sewers unless otherwise stated.

Note:
See Sheet 74 for Drainage Quantities.
See Sheet 79 for Drainage Quantities D-1, D-2, D-3, D-33 & R12