FED. RD. DIVISION	STATE	PROJECT	TYPE FUNDS
2	OHIO		

45
526

CUYAHOGA COUNTY
CUY-480-8.00
CUY-17-7.59

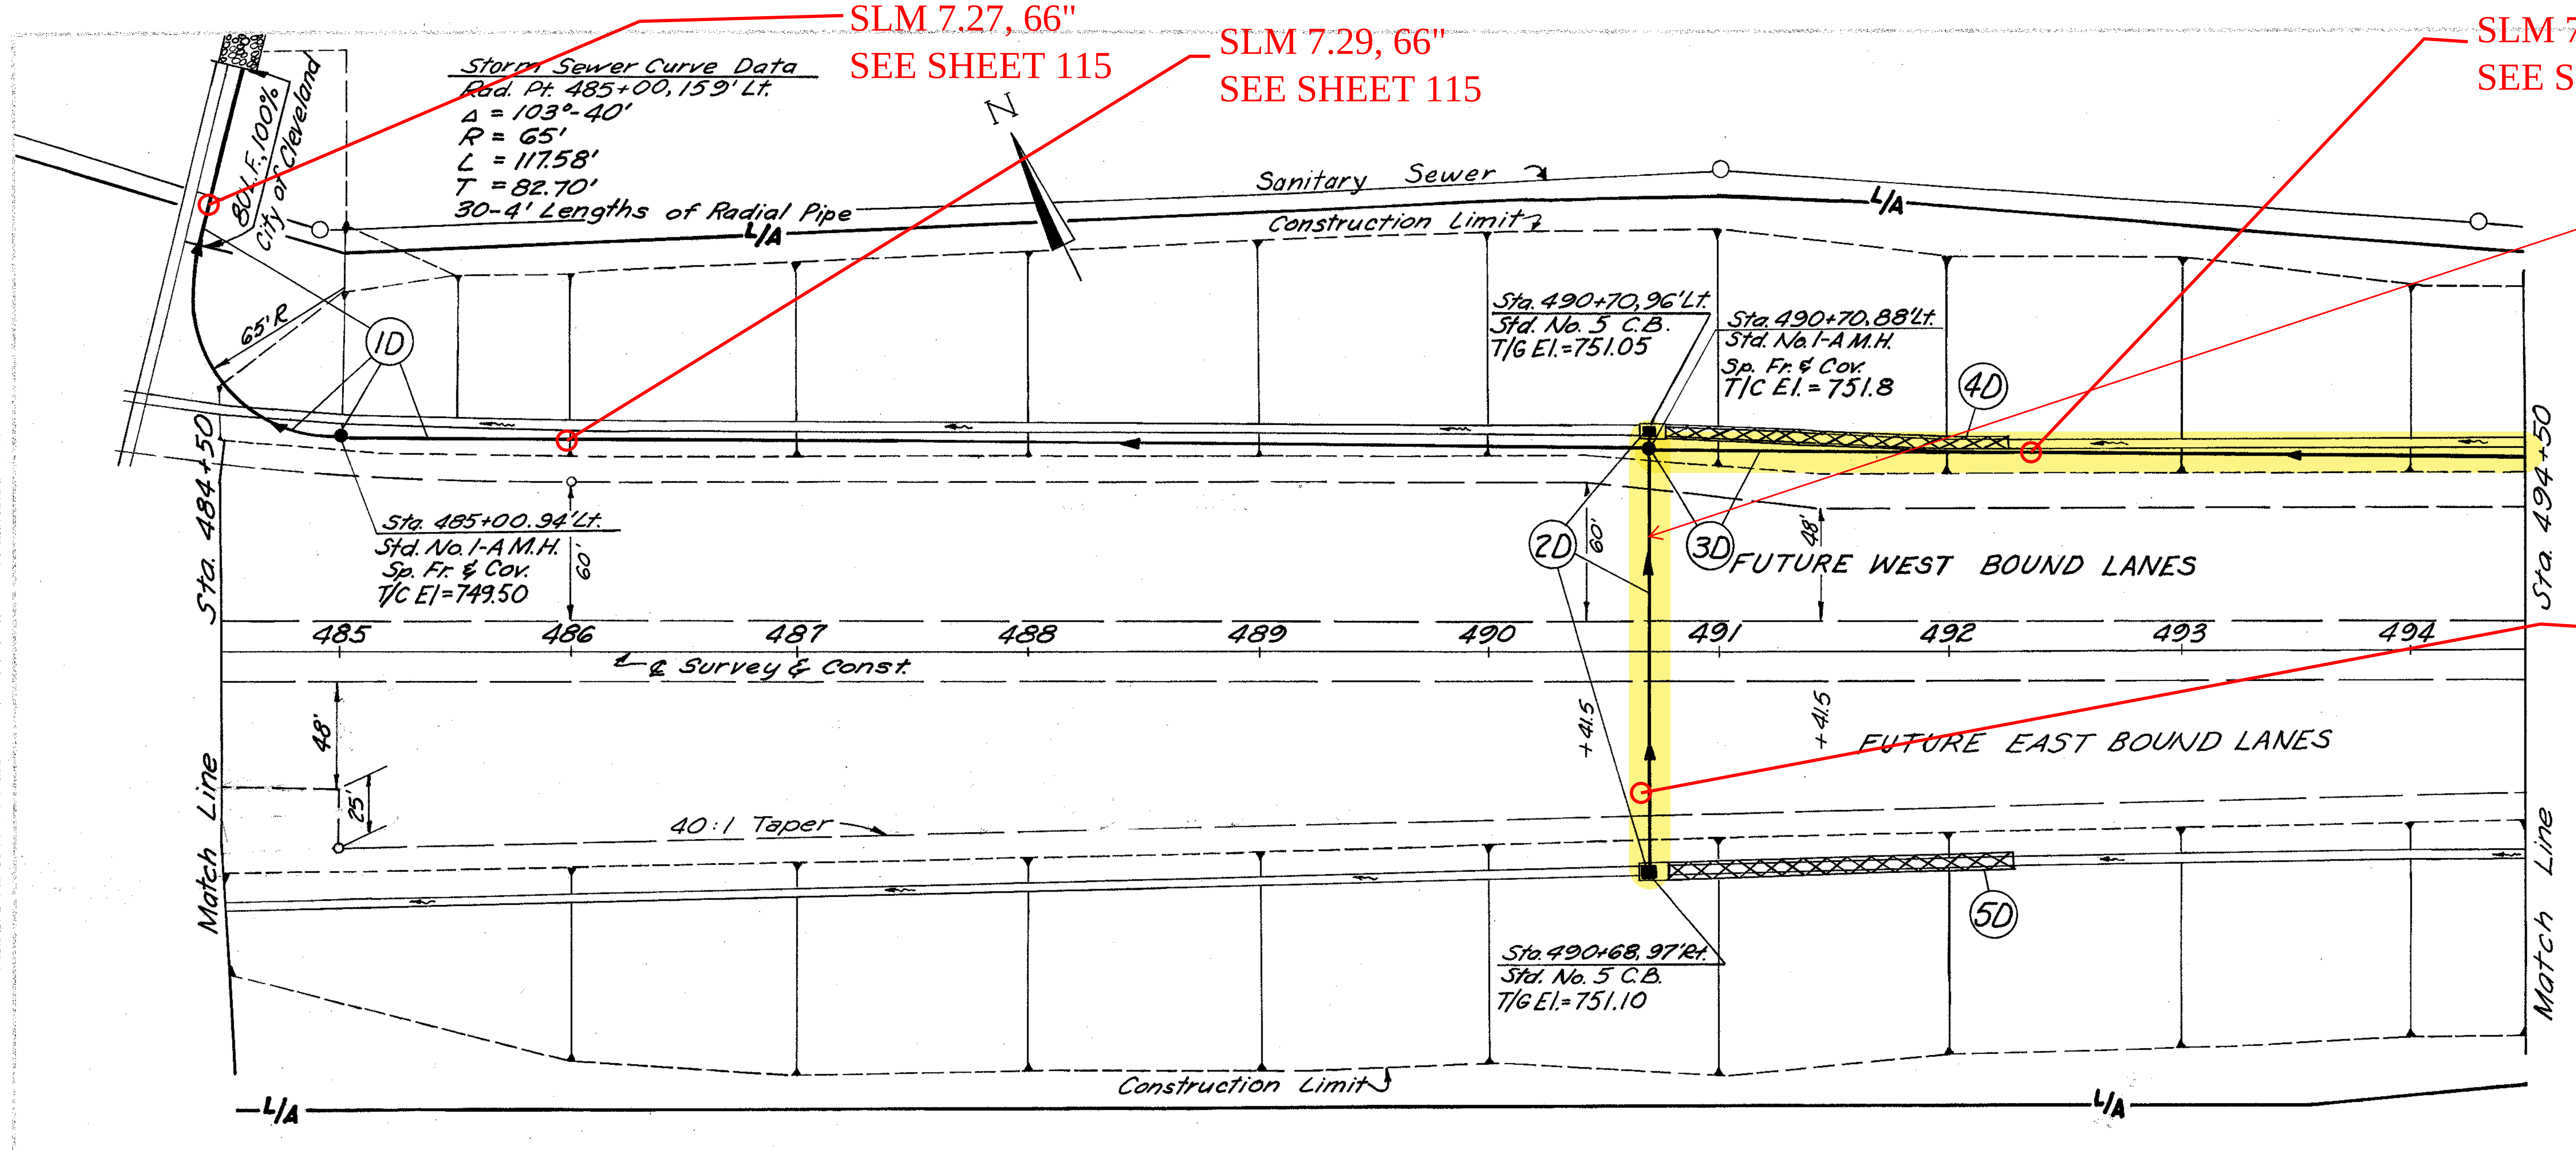

Tree Removal
484+50 to 494+50

Size	№
18"	116
30"	22

SEE 1978 CUY-480-6.78
Sheet 27

CROSS REFERENCE

Item	Sht. No.
Storm Sewer Profiles	115-121
Sanitary Sewer	155
Water Line Work	

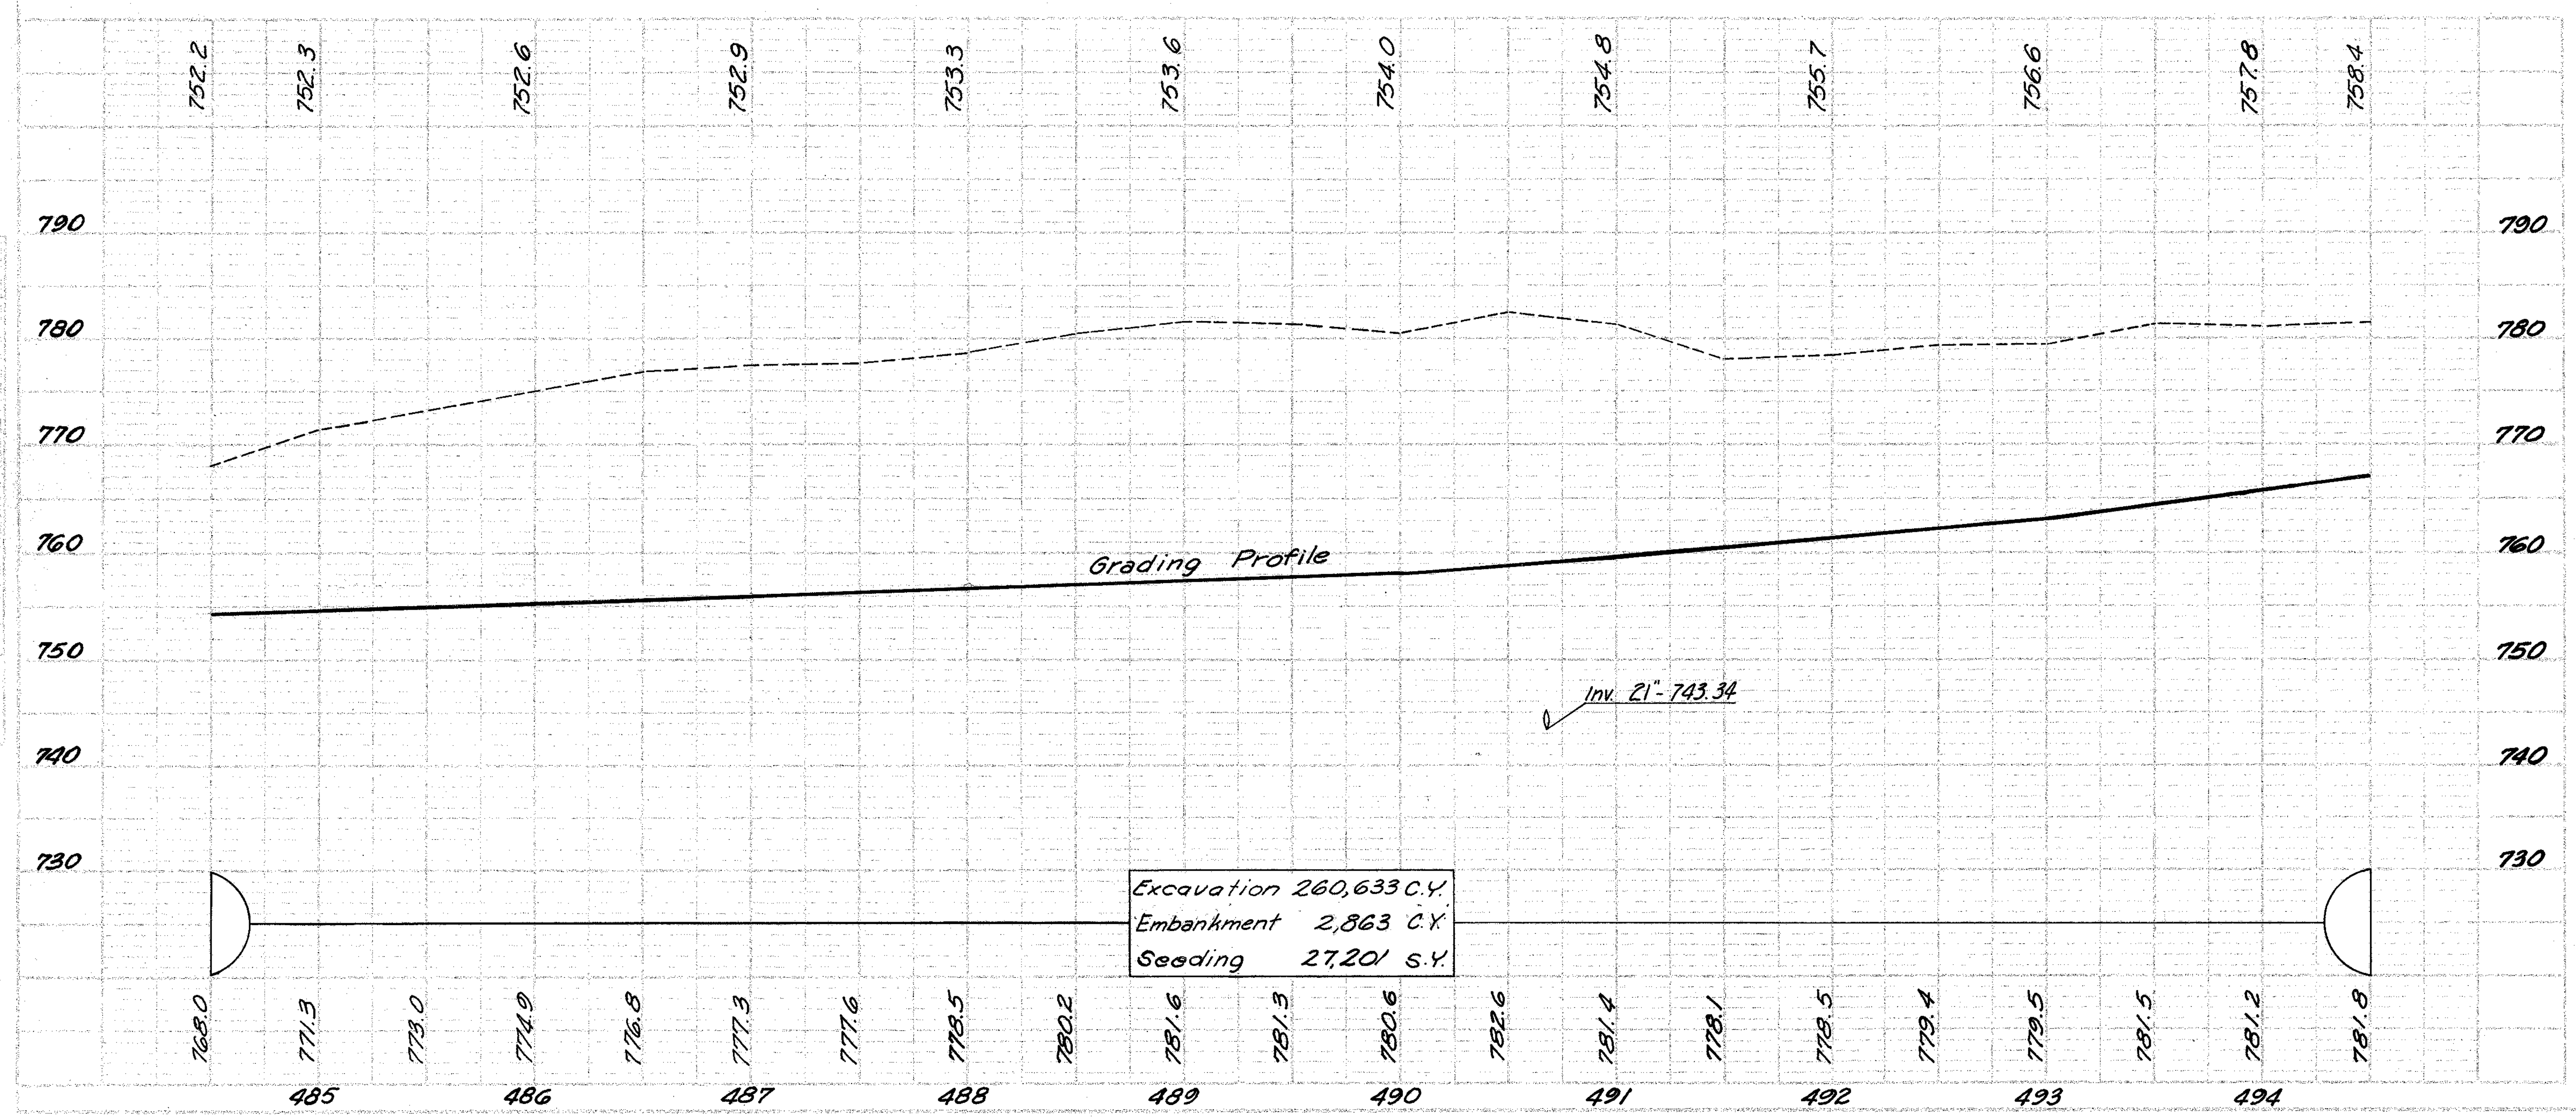

DRAINAGE — Estimated Quantities

Ref. #	Side	Location	667 Seeding and Jute Matting (S.Y.)	604 No. 1-A Manhole (Spec. Fr. & Cov.) (Ea.)	604 No. 5 C.B. (Ea.)	603 Class "B" Bedding Type "C" 706.02 Cl. III 66" (L.F.)	603 Class "B" Bedding Type "C" Radius Pipe 706.02 Cl. IV 66" (L.F.)	603 Class "B" Bedding Type "C" 706.02 Cl. IV 66" (L.F.)	603 Class "B" Bedding Type "C" 66" (L.F.)	603 Class "B" Bedding Type "B" 21" (L.F.)	603 Class "B" Bedding Type "C" 15" (L.F.)
1D*	Lt.	484+50 to 490+70**		1			120**	80*	568**		
2D	Lt./Rt.	490+70			2					182	8
3D	Lt.	490+70 to 494+50**		1		380**					
4D	Lt.	490+70 to 492+27	125								
5D	Rt.	490+72 to 492+27	125								
		TOTALS	250	2	2	380	120	80	568	182	8

* 100% City of Cleveland
** 1D, and 3D - 77.6% Interstate, 22.4% Urban

Calc. by D.E.M. 9-3-71
Chkd. by W.A.M. 9-16-71

PLAN & PROFILE STA. 484+50 TO STA. 494+50