


SEERING 150 140 130 120 110 100 90 80 70 60 50 40 30 20 10 0 10 20 30 40 50 60 70 80 90 100 110

END WIDTH 50 YDS.

FED. RD. DIVISION	STATE	PROJECT	31
5	OHIO		107

CUYAHOGA COUNTY
CUY-80-8.26

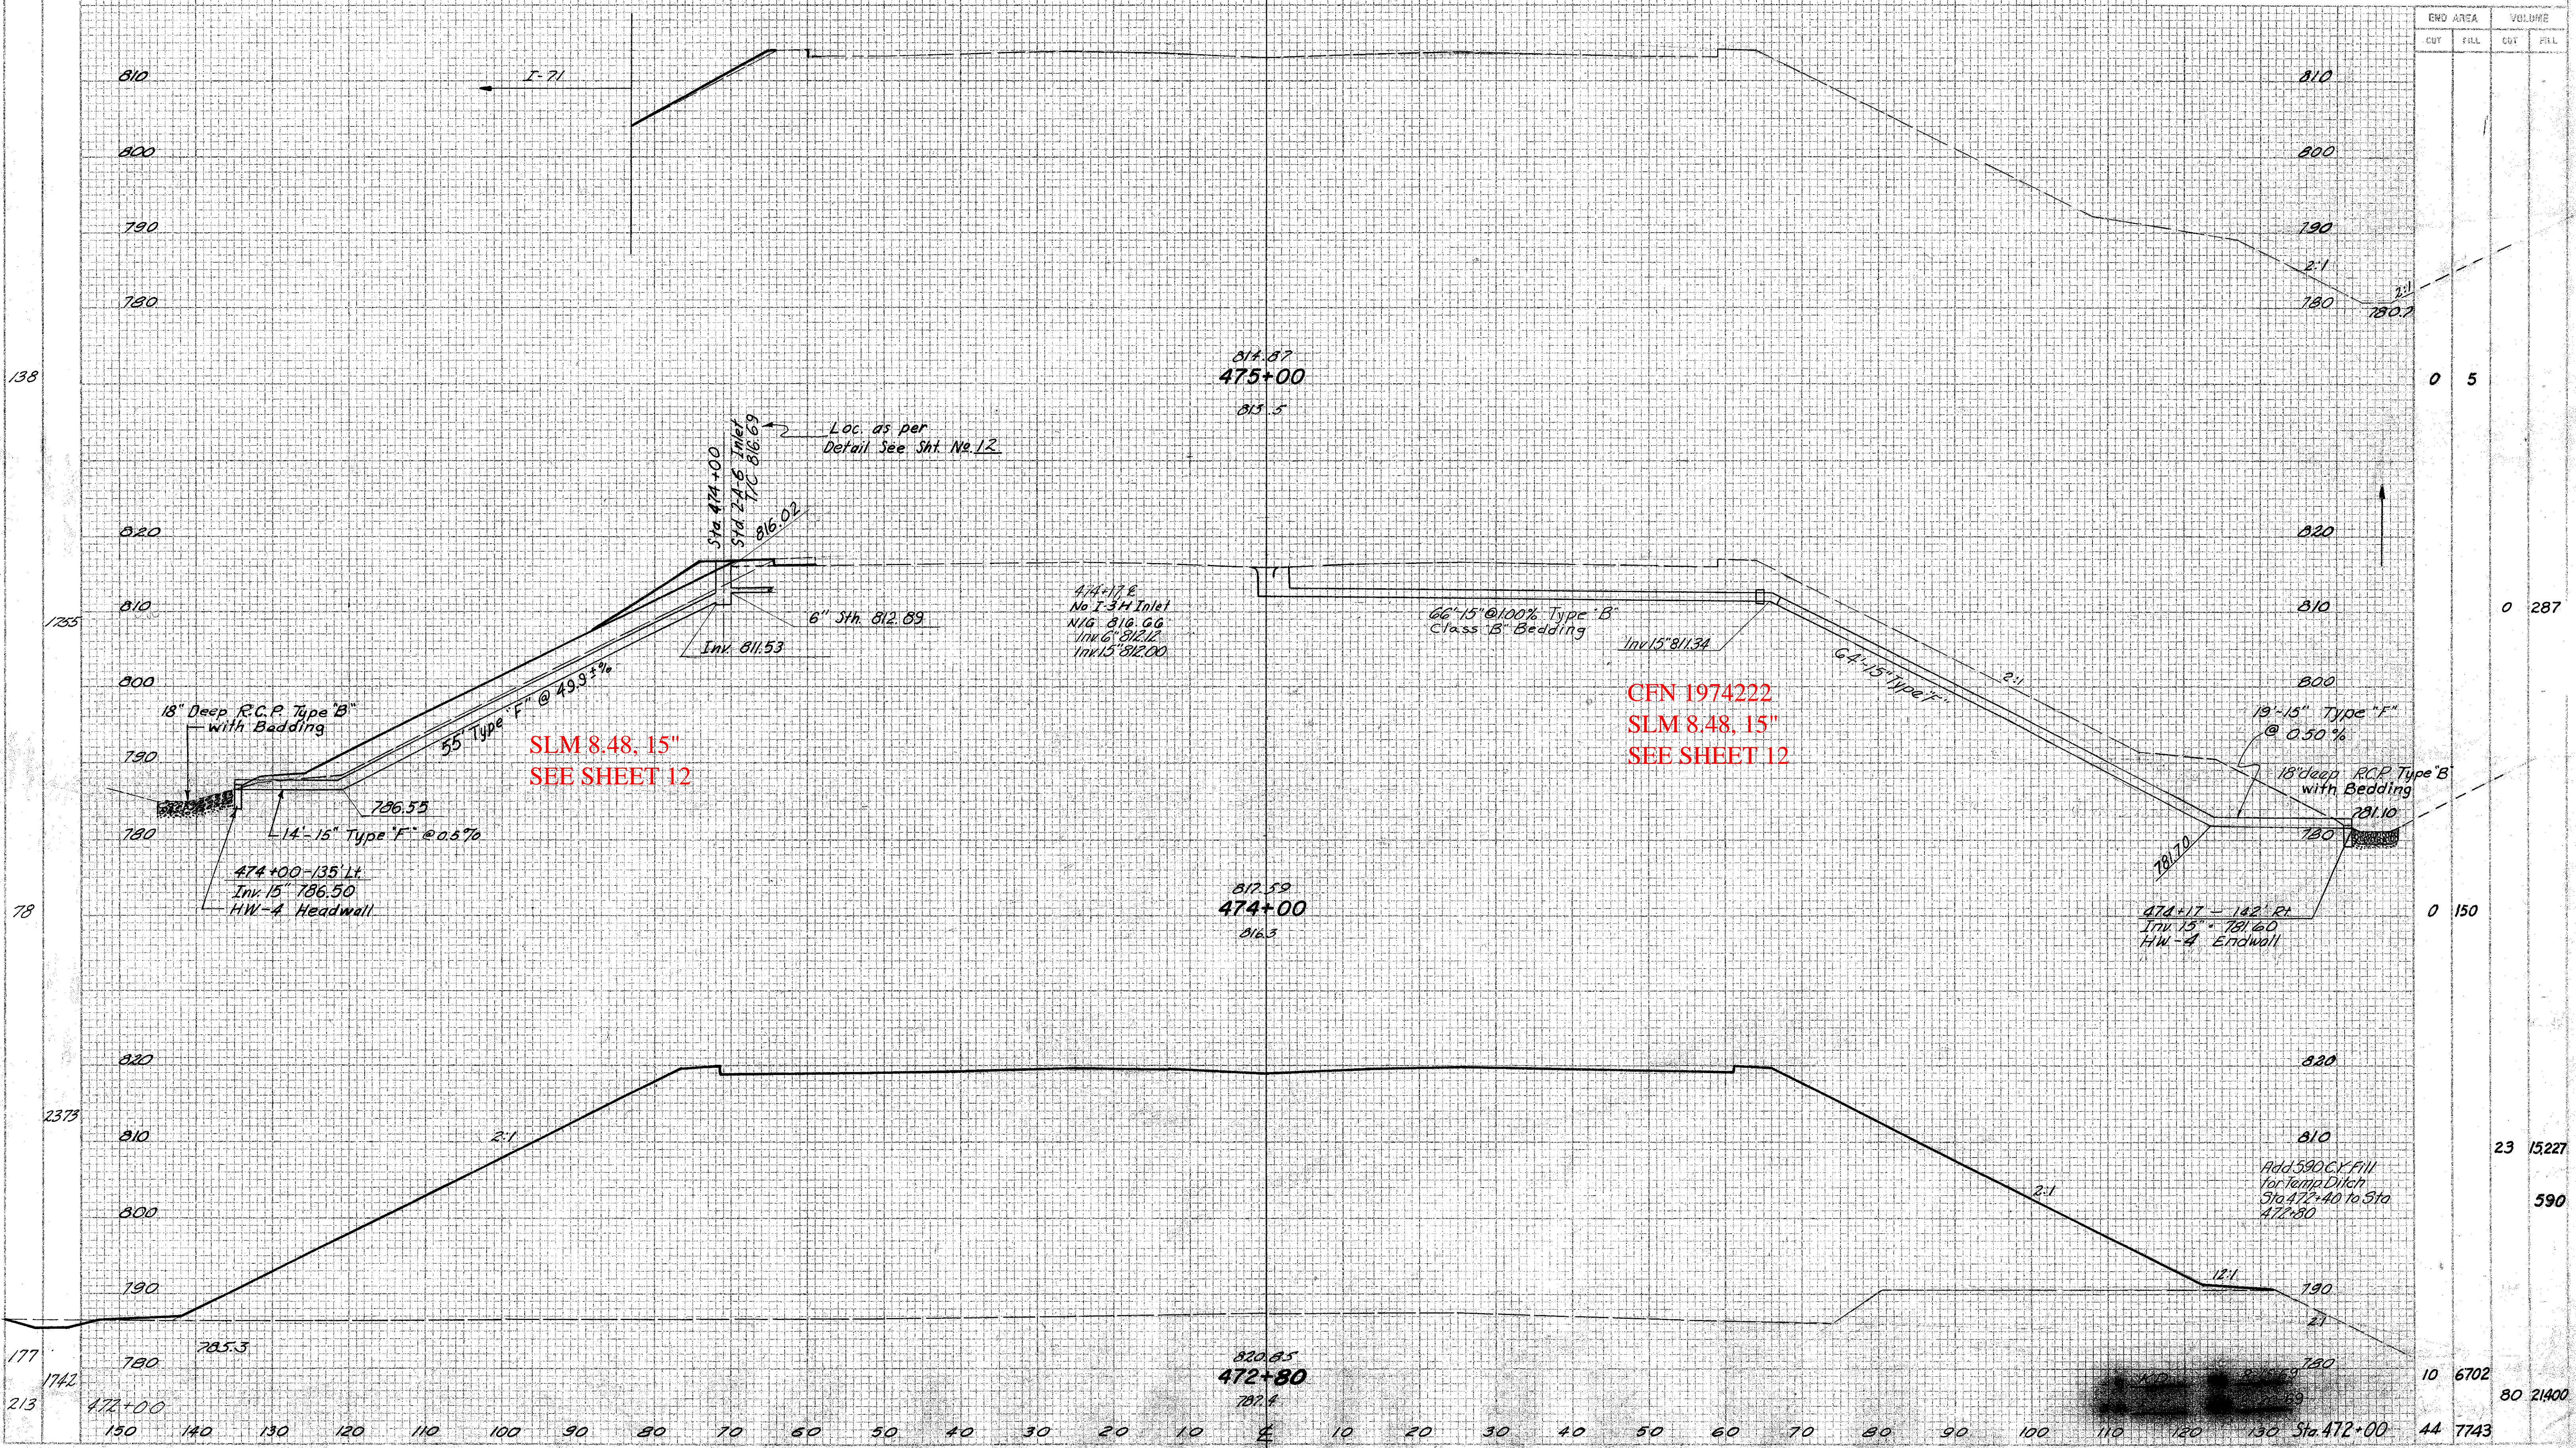

END AREA	VOLUME	
	CUT	FILL
0	5	
0	287	
0	150	
23	15227	590
10	6702	80 21400
44	7743	

SLM 8.48, 15"
SEE SHEET 12

CFN 1974222
SLM 8.48, 15"
SEE SHEET 12

I-80 CROSS-SECTIONS STA. 472+80 TO STA. 475+00