SLM 7.23, 27"
SEE BELOW

SLM 7.27, 30"
SEE BELOW

SLM 7.27, 60"
SEE CUY-480-8.00

SLM 7.27, 66"
SEE BELOW AND
CUY-480-8.00

GRAYTON RD
SLM 7.27=MM 9.44

SLM 7.40, 66"
SEE BELOW AND
CUY-480-8.00

CFN 1973393
SLM 7.40, 21"
SEE CUY-480-8.00

CFN 1973392
SLM 7.40, 21"

CFN 1973326
SLM 7.23, 18"
SEE SHEET 74

old CFN 184800727
new CFN 1873070
SLM 7.27, 60"
SEE CUY-480-8.00
SHEETS 44 AND 52

CALC. BY E.J.K. DATE 10-75
CHKD BY B.B. DATE 11-75

FED. RD. DIVISION	STATE	PROJECT	SHEET NO.
2	OHIO		

27
3/7

CUYAHOGA COUNTY
CUY:- 480 – 6.78

CROSS REFERENCE	
SH. No.	ITEM
37	RAMP G-4 P & P
44, 45	RELOCATED GRAYTON RD.
27, 74	SEWER PROFILES
63	PAVEMENT DETAILS
260	STRUCTURE – RELOC. GRAYTON

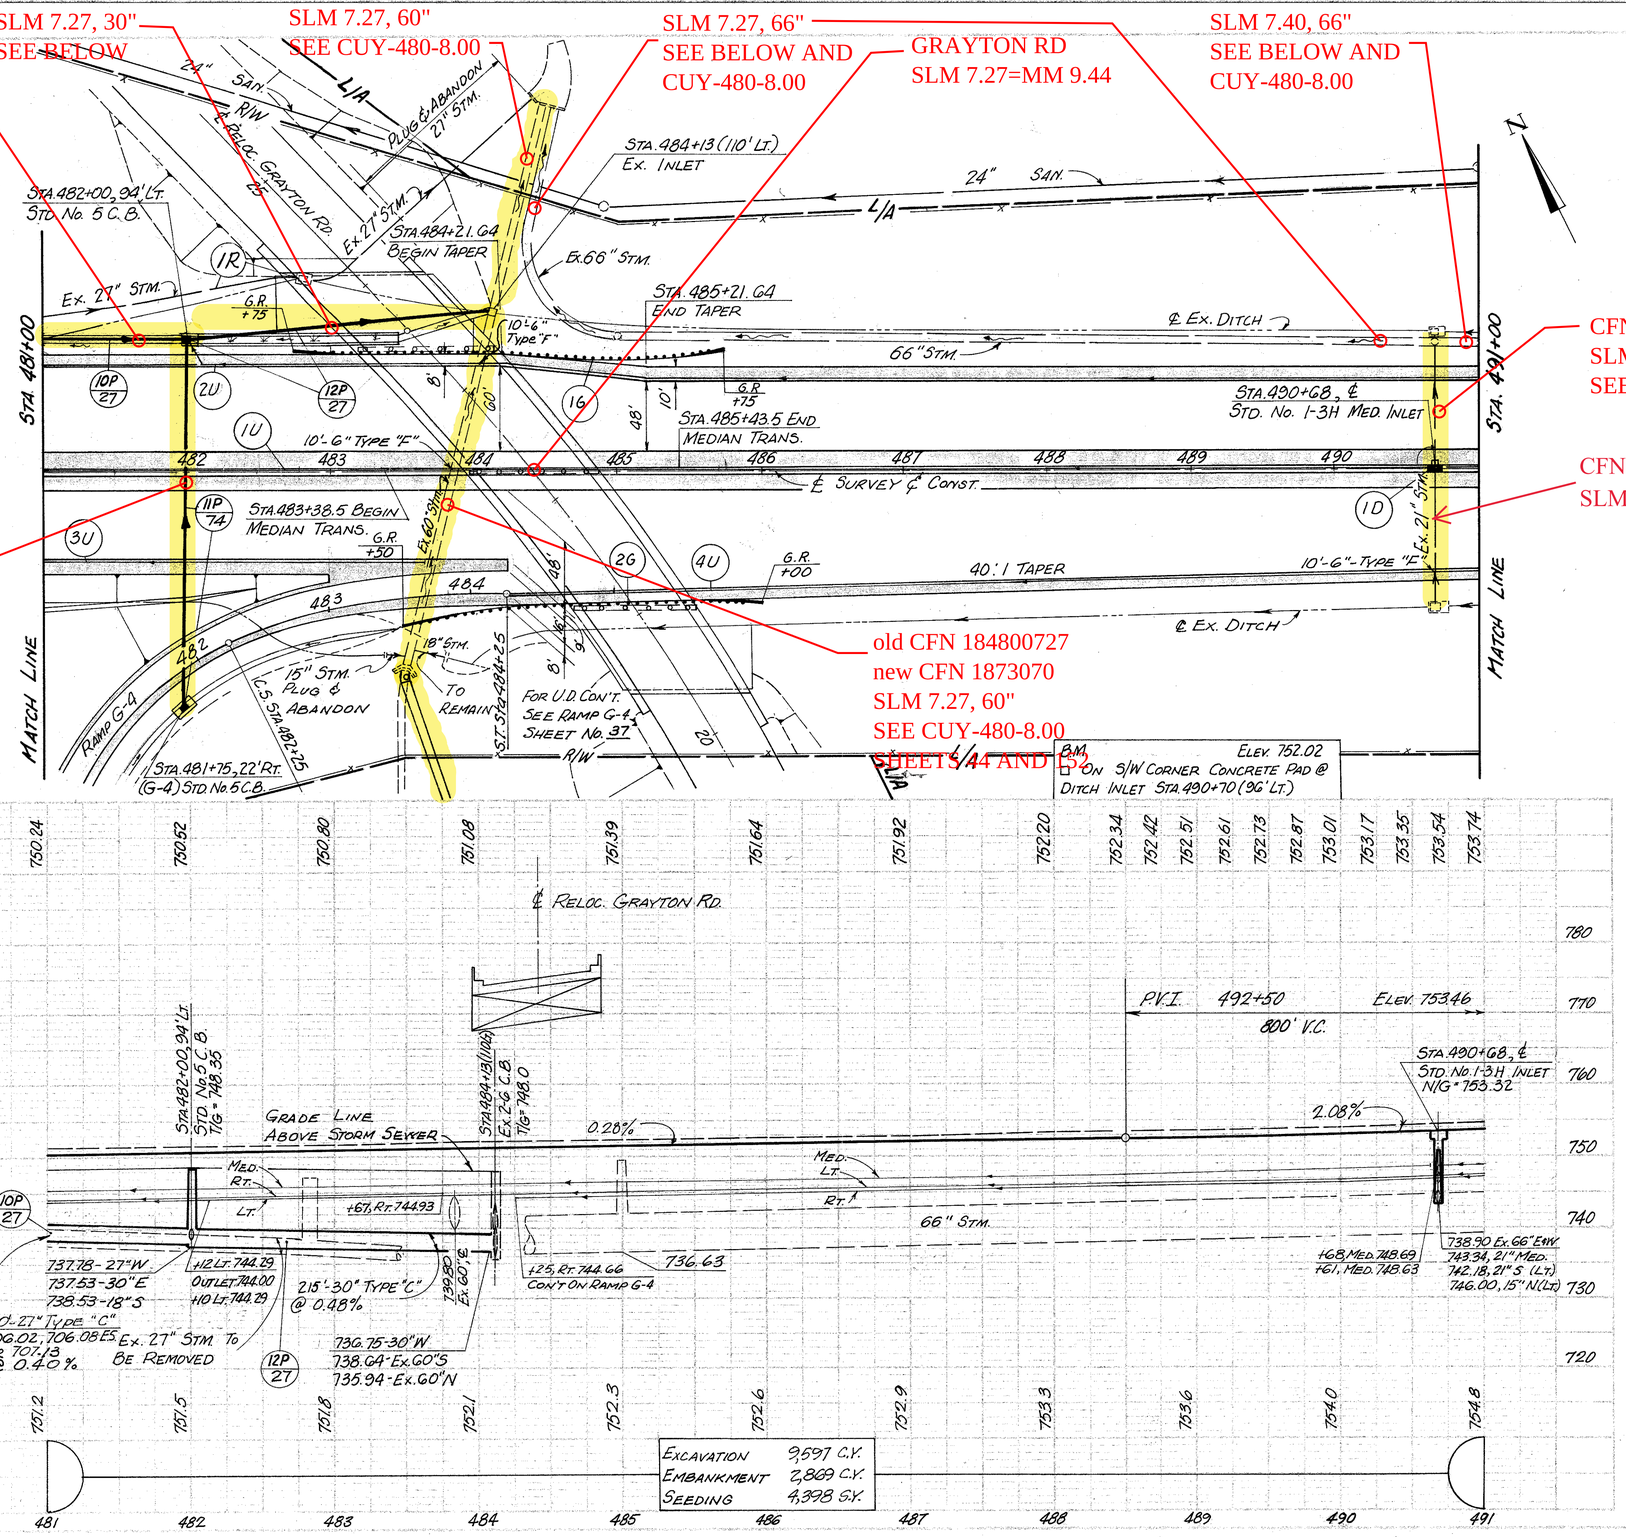

| | | |