


T-5

CUYAHOGA COUNTY
CUY-480-6.78

CALC. BY E.J.R. DATE 10-75
CHKD. BY H.J.H. DATE 11-75

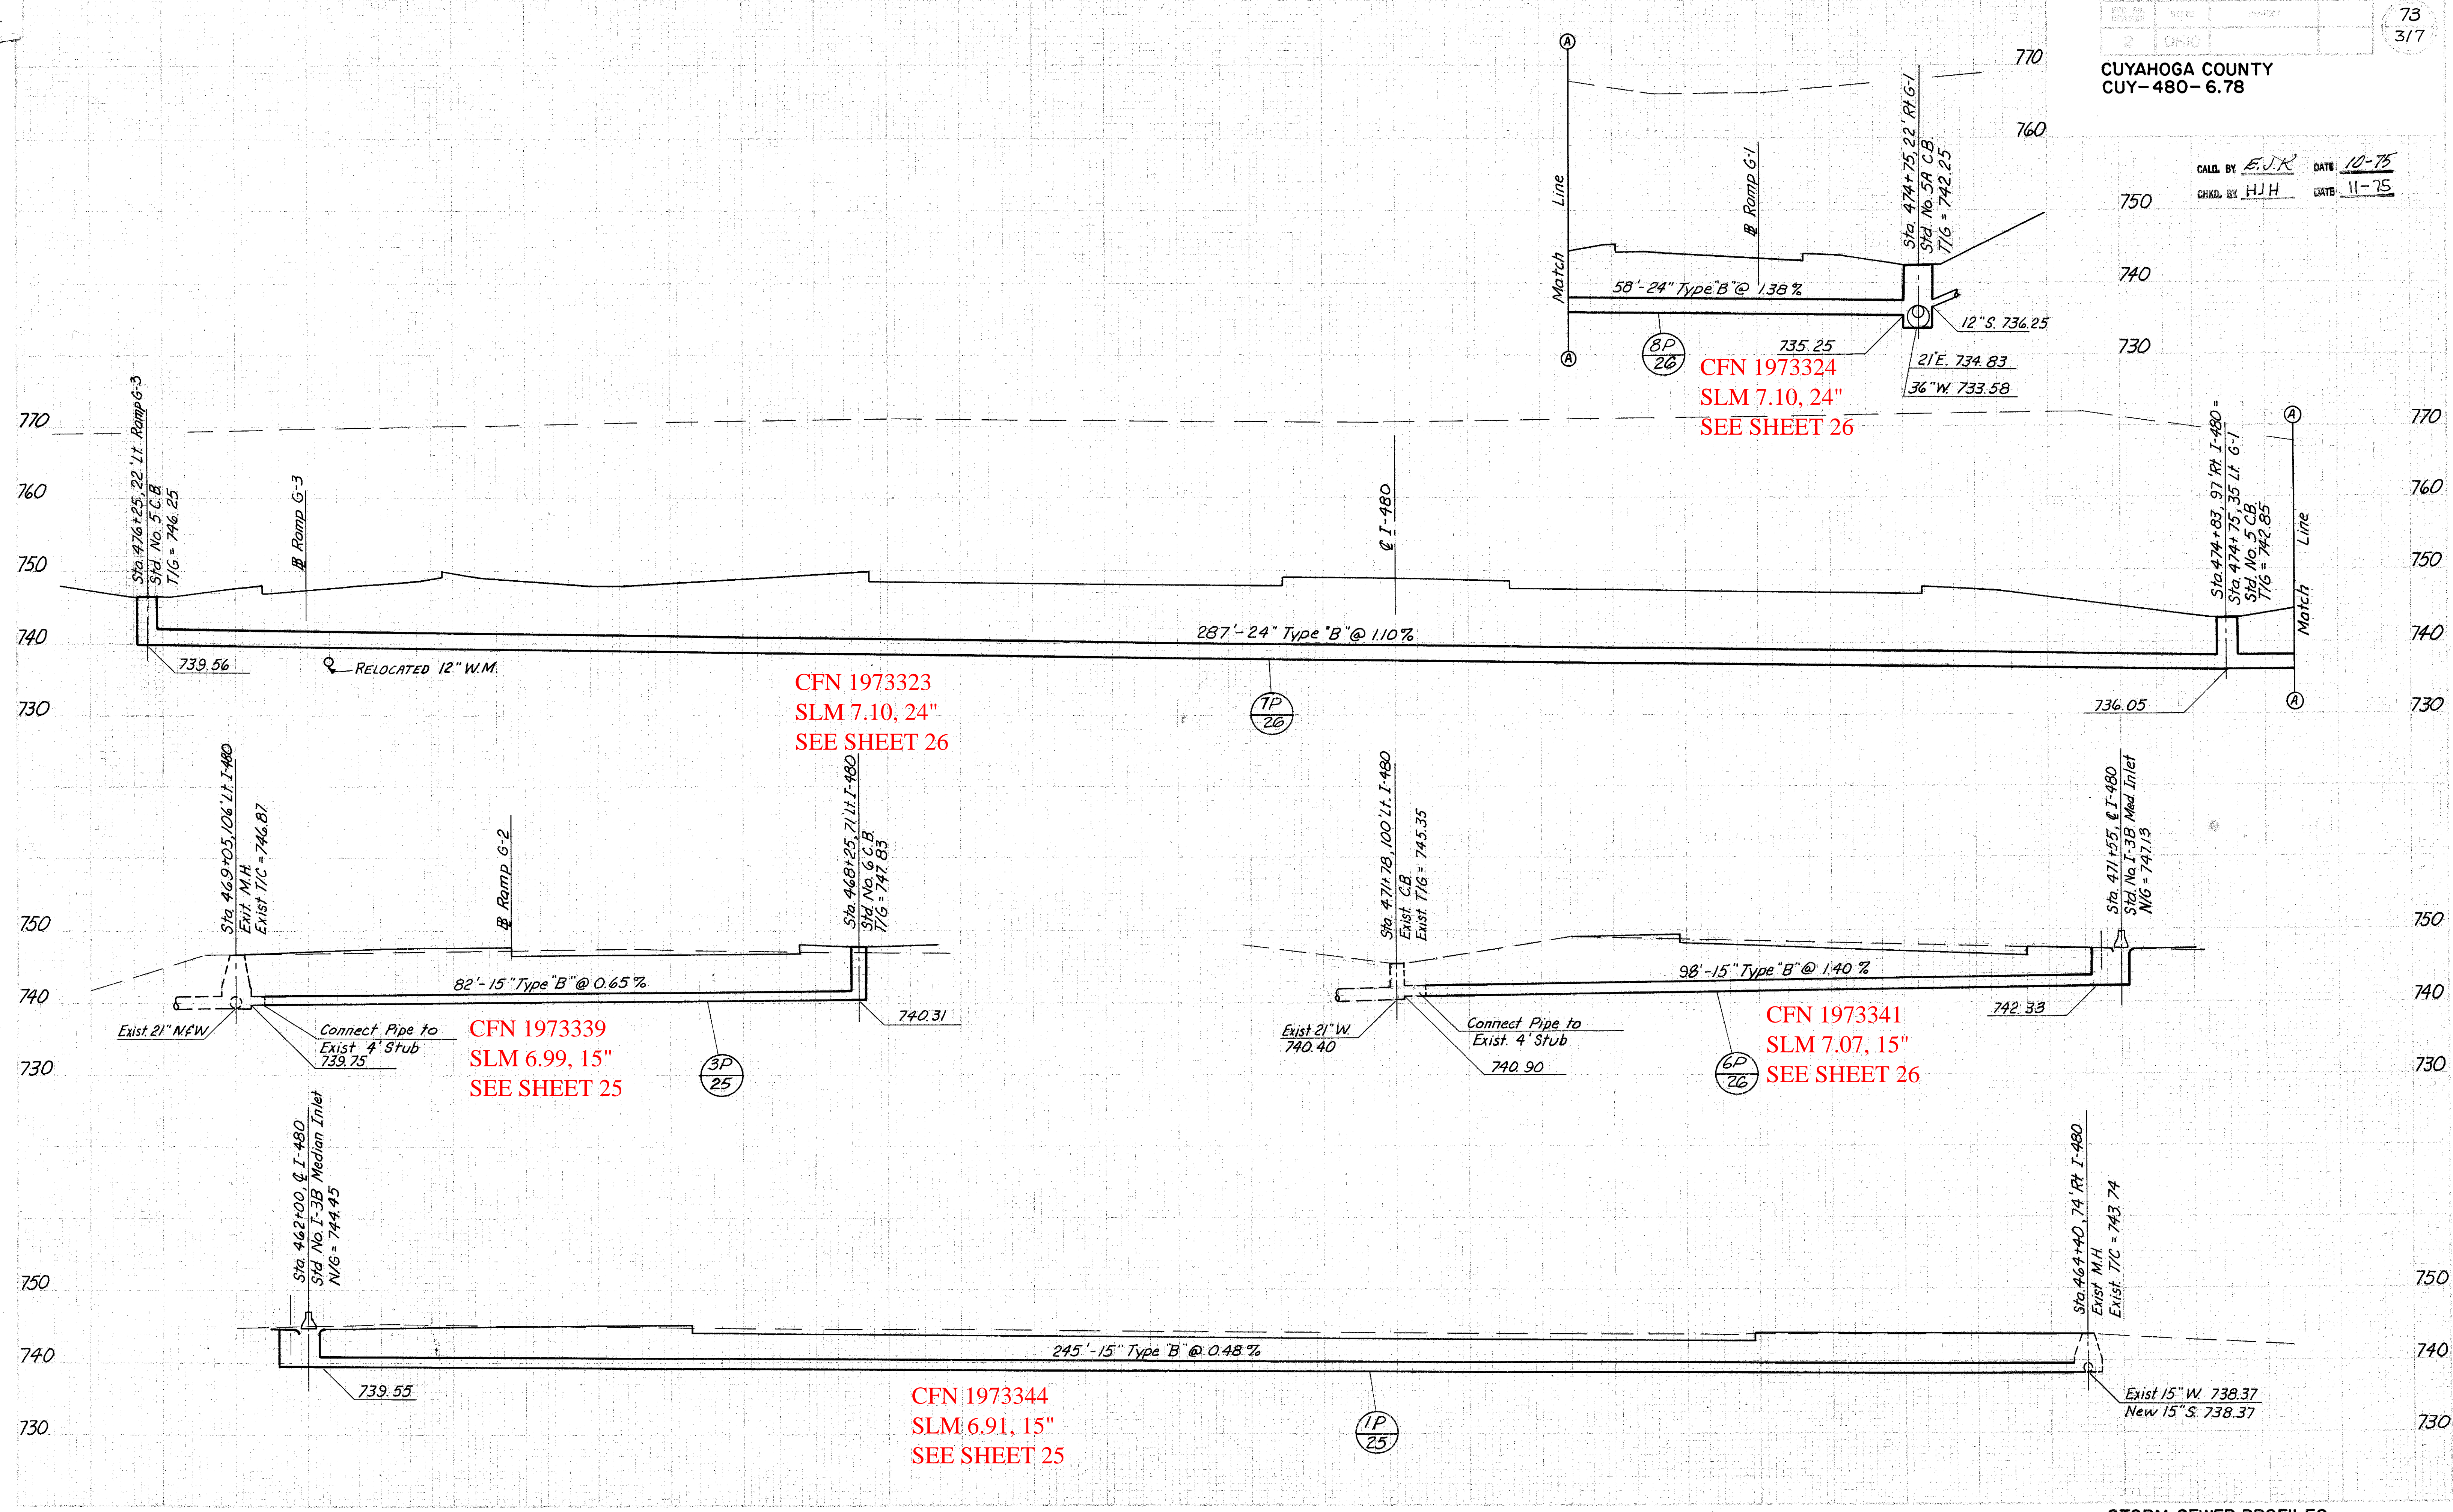

CFN 1973324
SLM 7.10, 24"
SEE SHEET 26

CFN 1973323
SLM 7.10, 24"
SEE SHEET 26

CFN 1973339
SLM 6.99, 15"
SEE SHEET 25

CFN 1973341
SLM 7.07, 15"
SEE SHEET 26

CFN 1973344
SLM 6.91, 15"
SEE SHEET 25