


CUYAHOGA COUNTY  
CUY-480-8.54

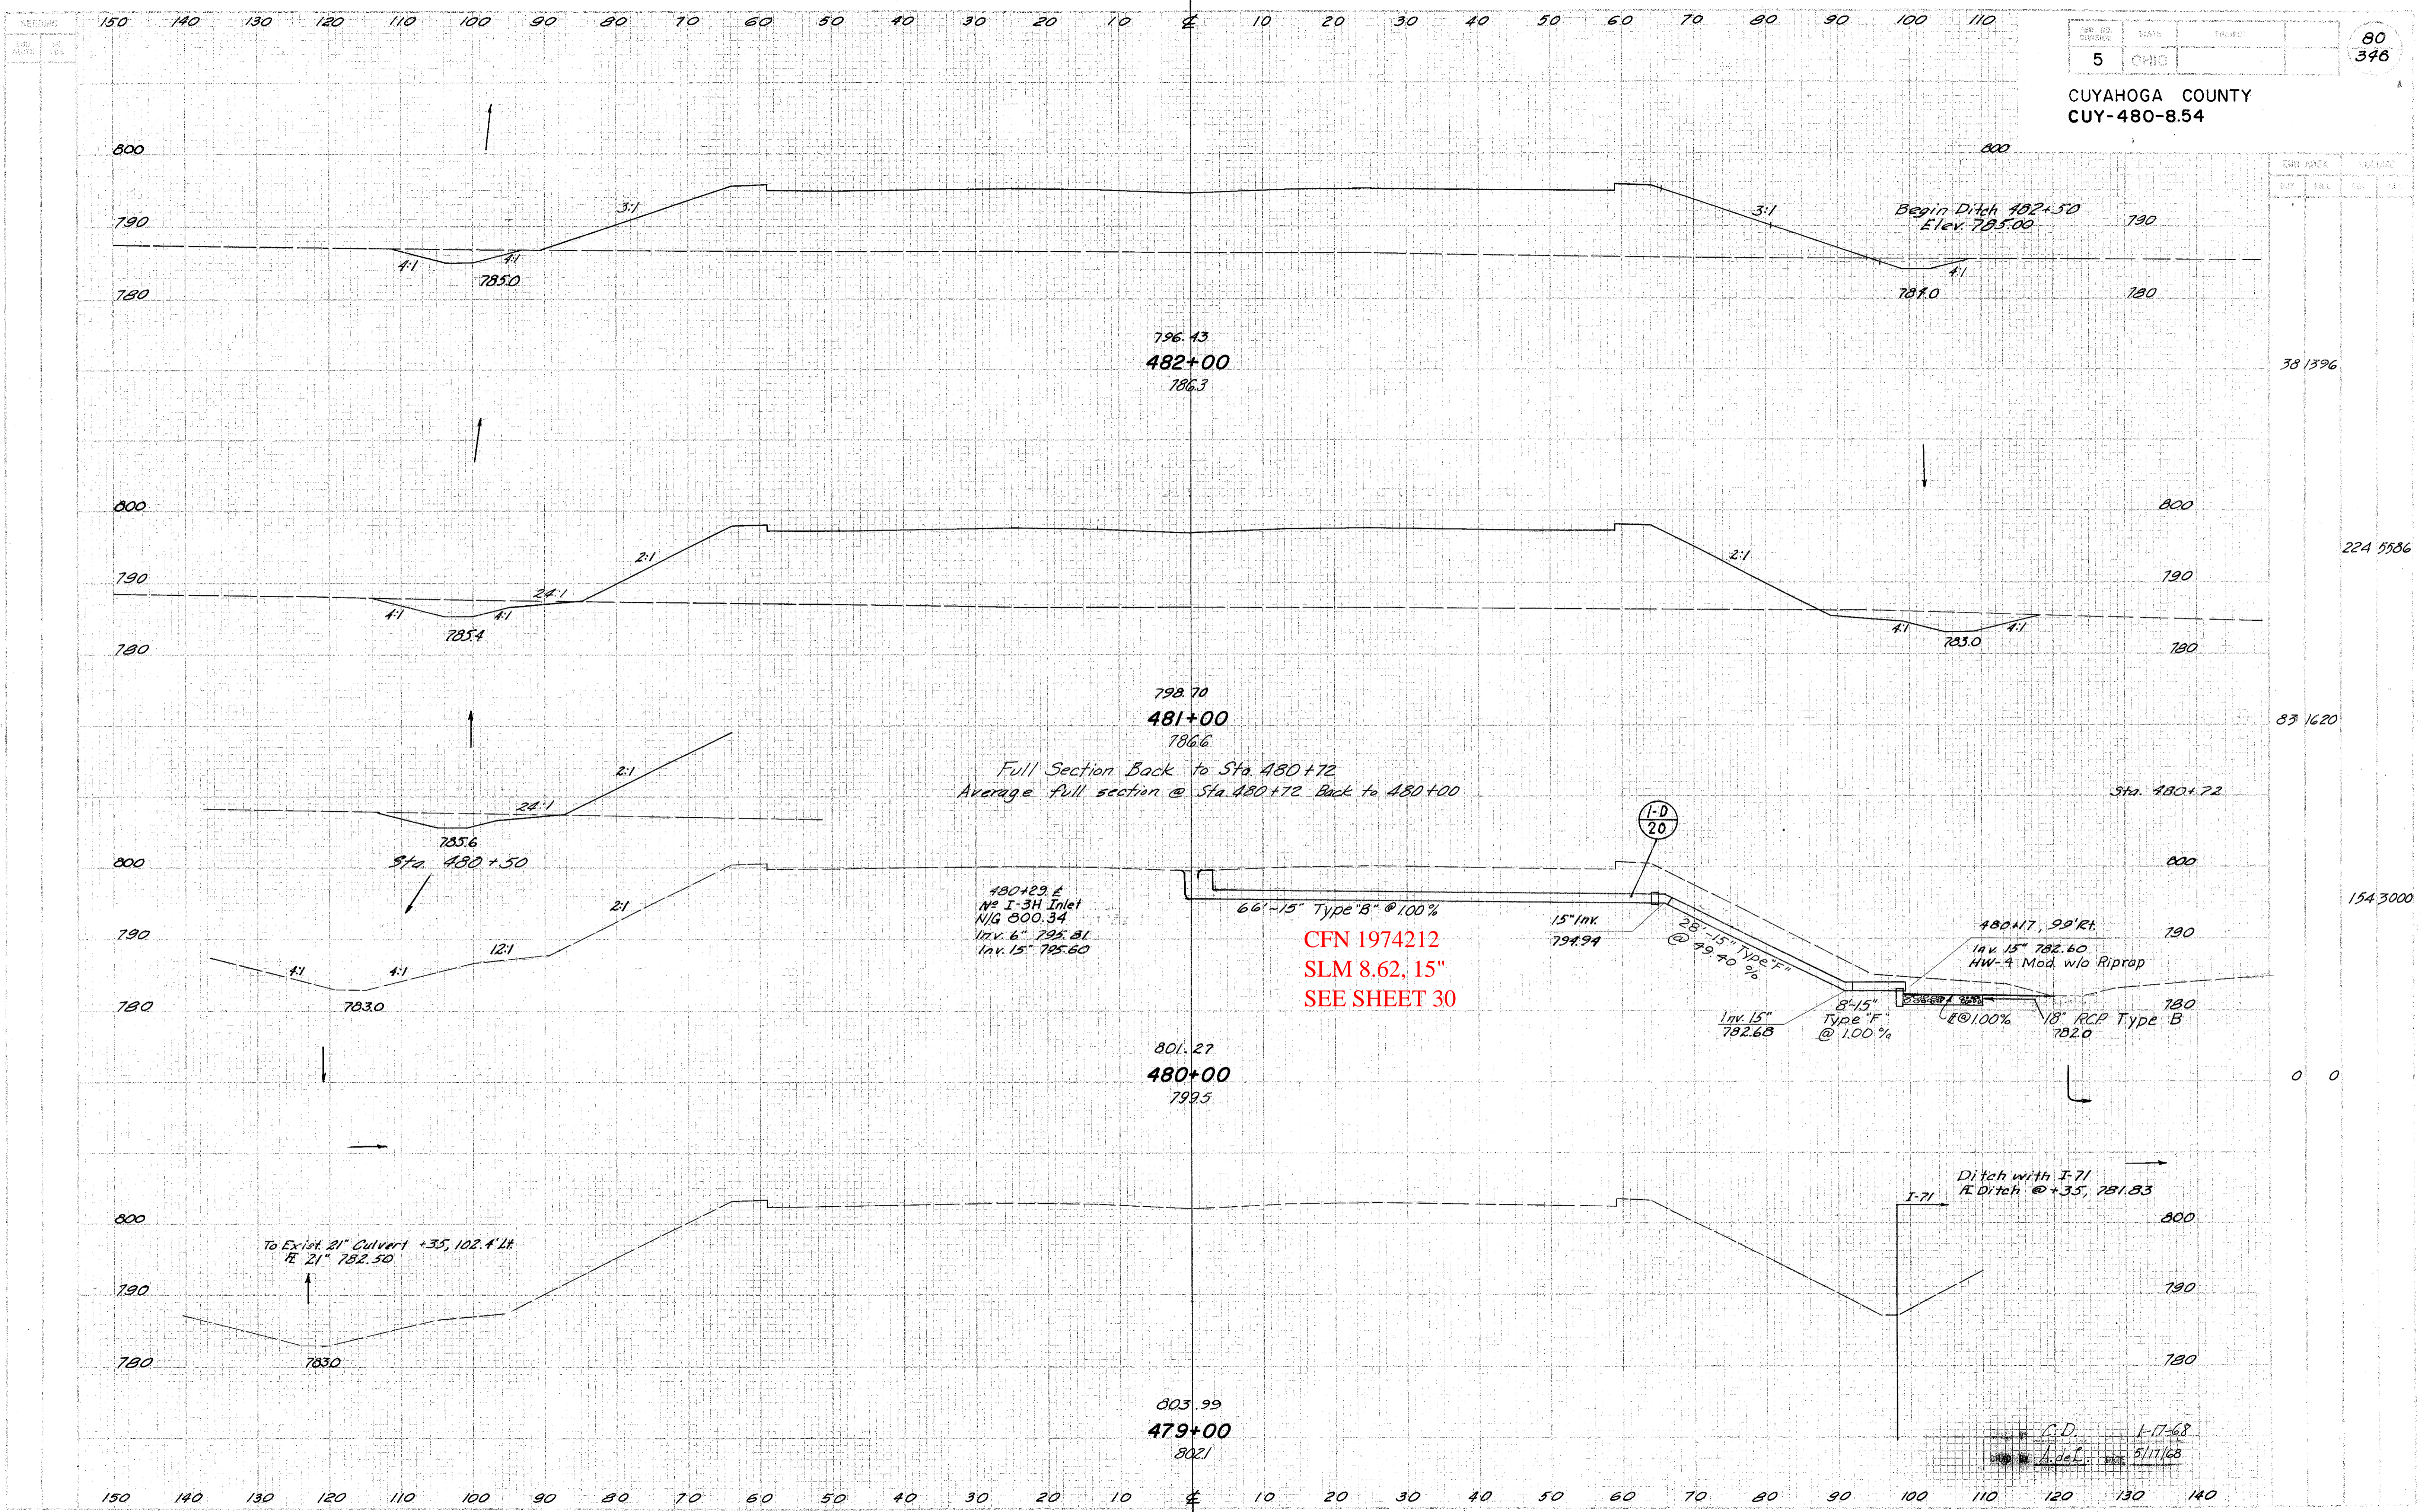

Full Section Back to Sta. 480+72  
Average full section @ Sta. 480+72 Back to 480+00

CFN 1974212  
SLM 8.62, 15"  
SEE SHEET 30

C.D. 1-17-68  
5/17/68

