


CUYAHOGA COUNTY
CUY-480-8.54

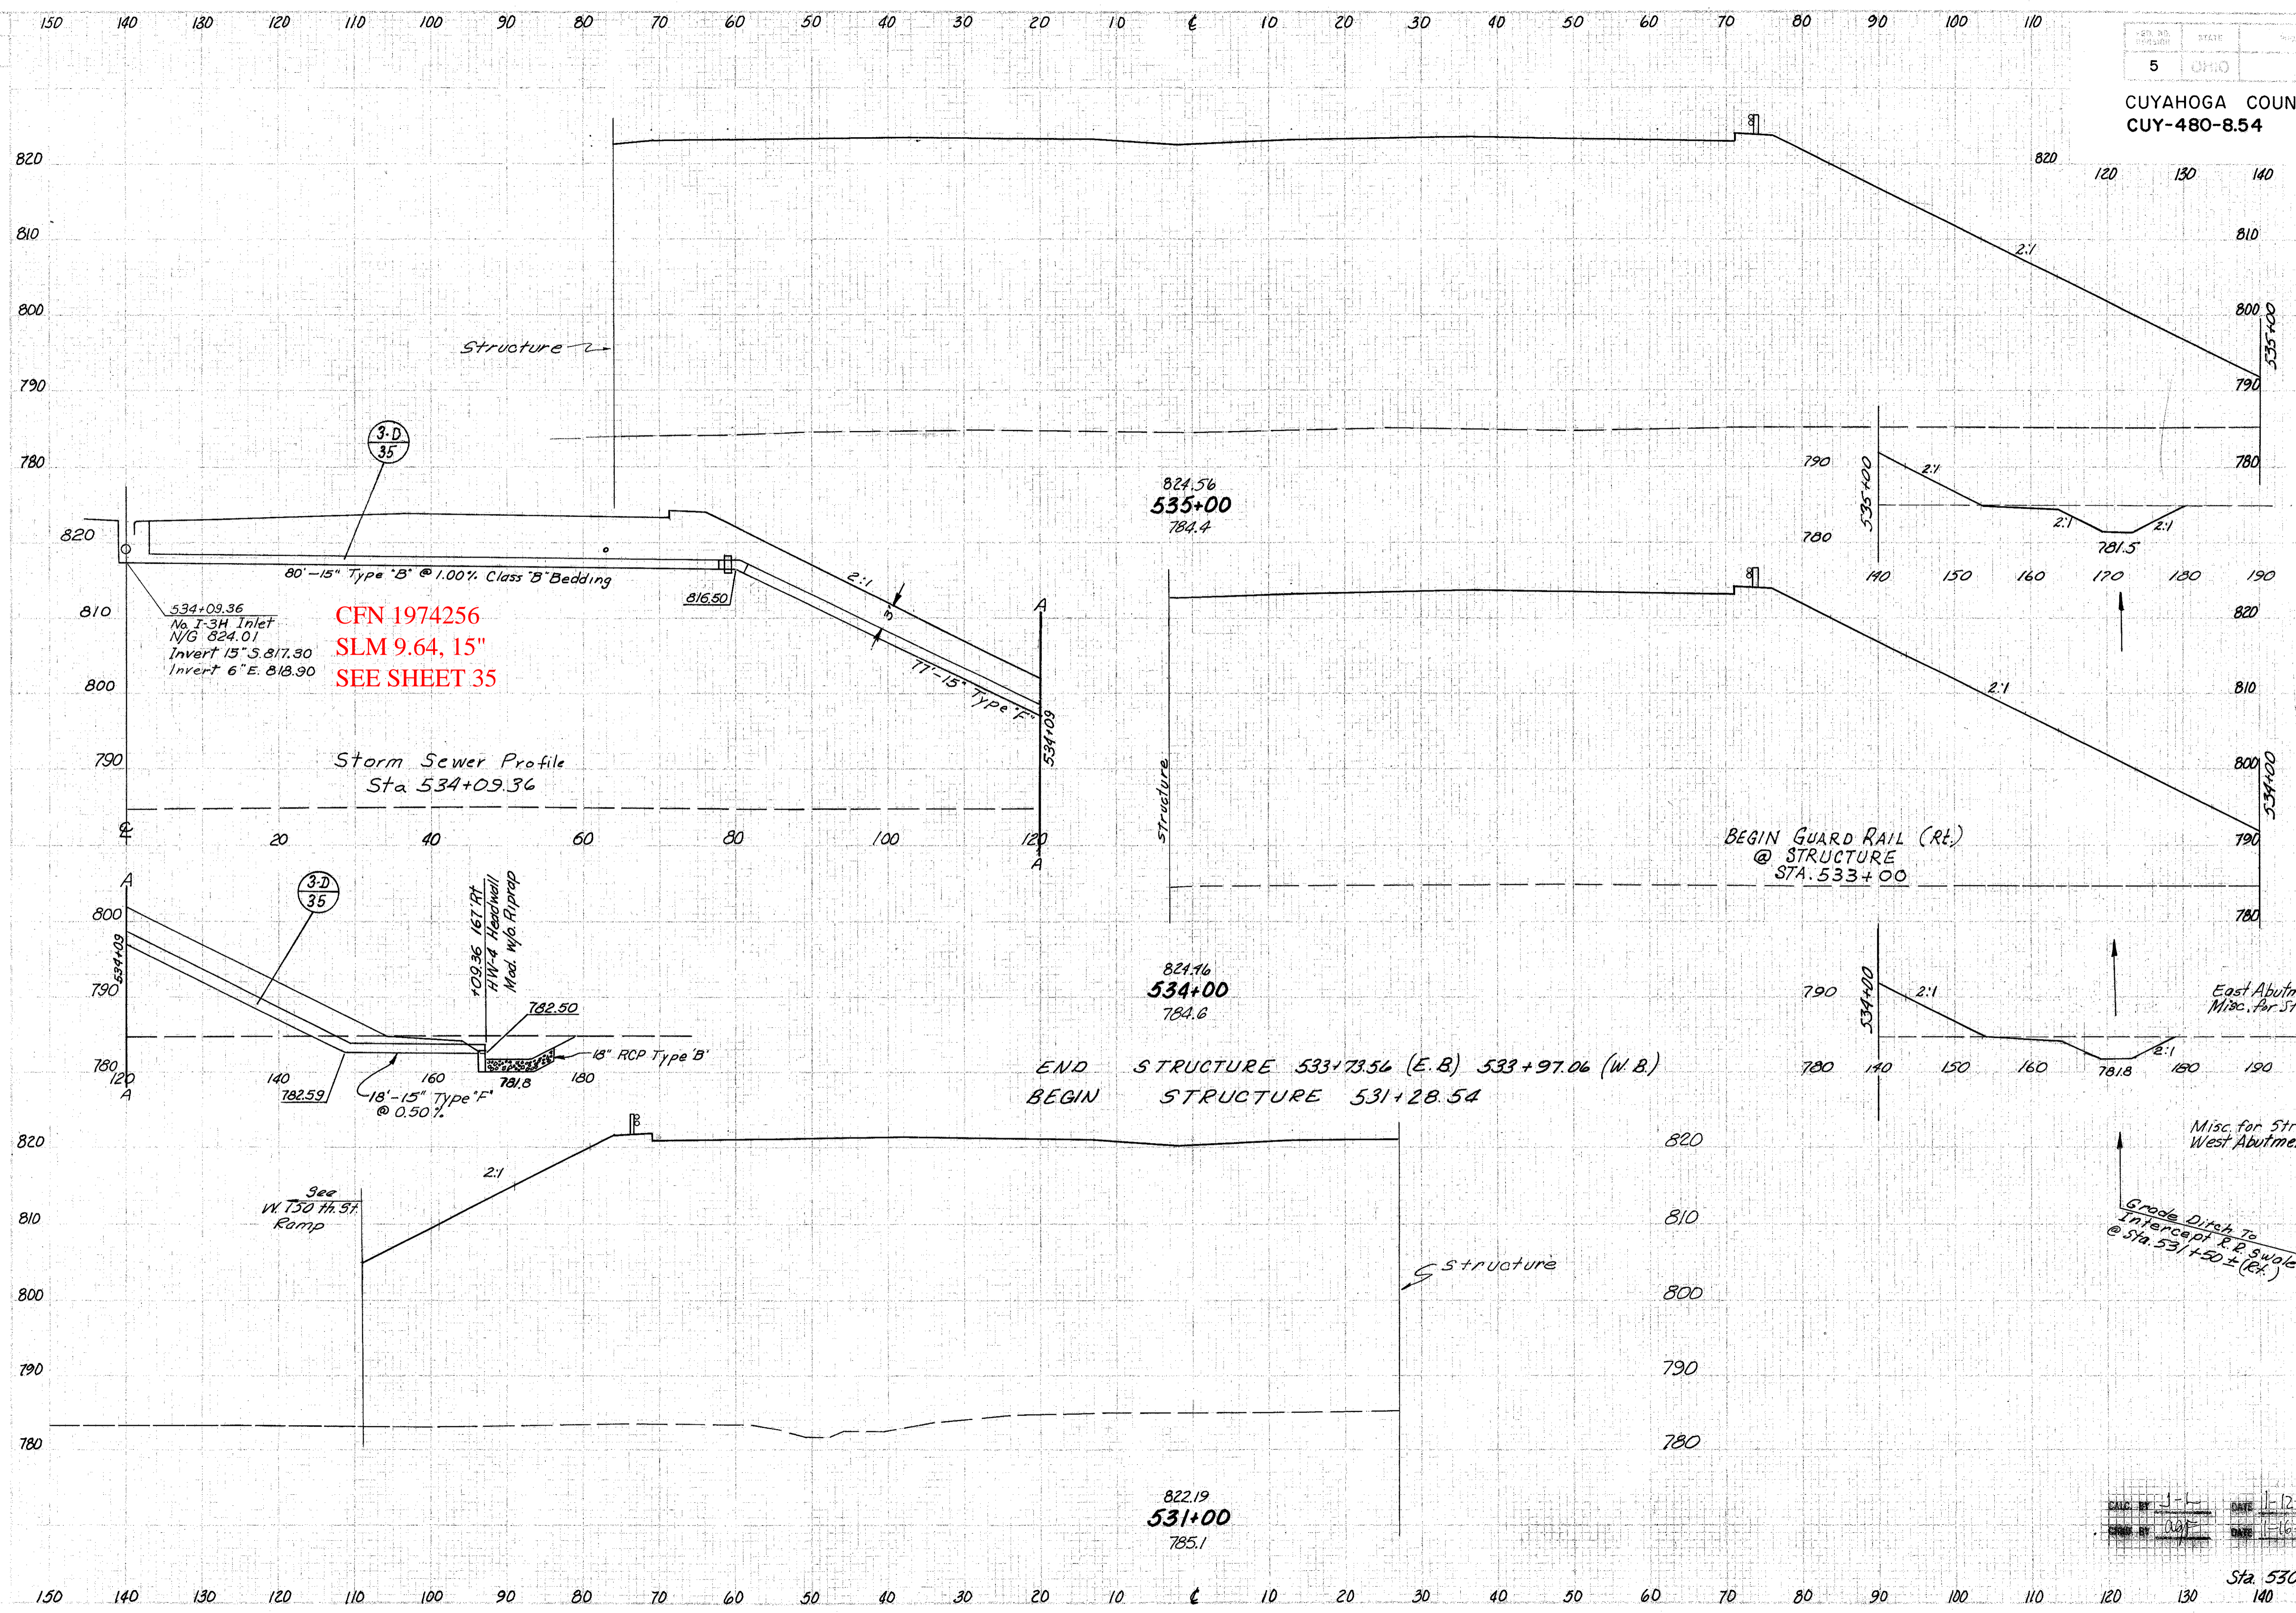

CFN 1974256
SLM 9.64, 15"
SEE SHEET 35

Storm Sewer Profile
Sta 534+09.36

END STRUCTURE 533+78.56 (E.B.) 533+97.06 (W.B.)
BEGIN STRUCTURE 531+28.54

BEGIN GUARD RAIL (RT.)
@ STRUCTURE
STA. 533+00

Grade Direct To
Intercept R.R. Swale
@ Sta. 531+50 ± (Et.)

See
W. 150 Th. St.
Ramp

DATE	1-12-68
DATE	1-16-68

NO.	DATE	BY	REVISION
45	7255		
144	21817		
33	4526		
	286	33519	
	0	23099	
	0	4782	
	0	10550	
	Sta. 530+50	0	6611

CROSS-SECTIONS STA. 531+00 TO STA. 535+00