


CALC. BY K.M. DATE 12-77
 CHKD. BY T.R.B. DATE 12-77

CUYAHOGA COUNTY
 CUY-480-15.22

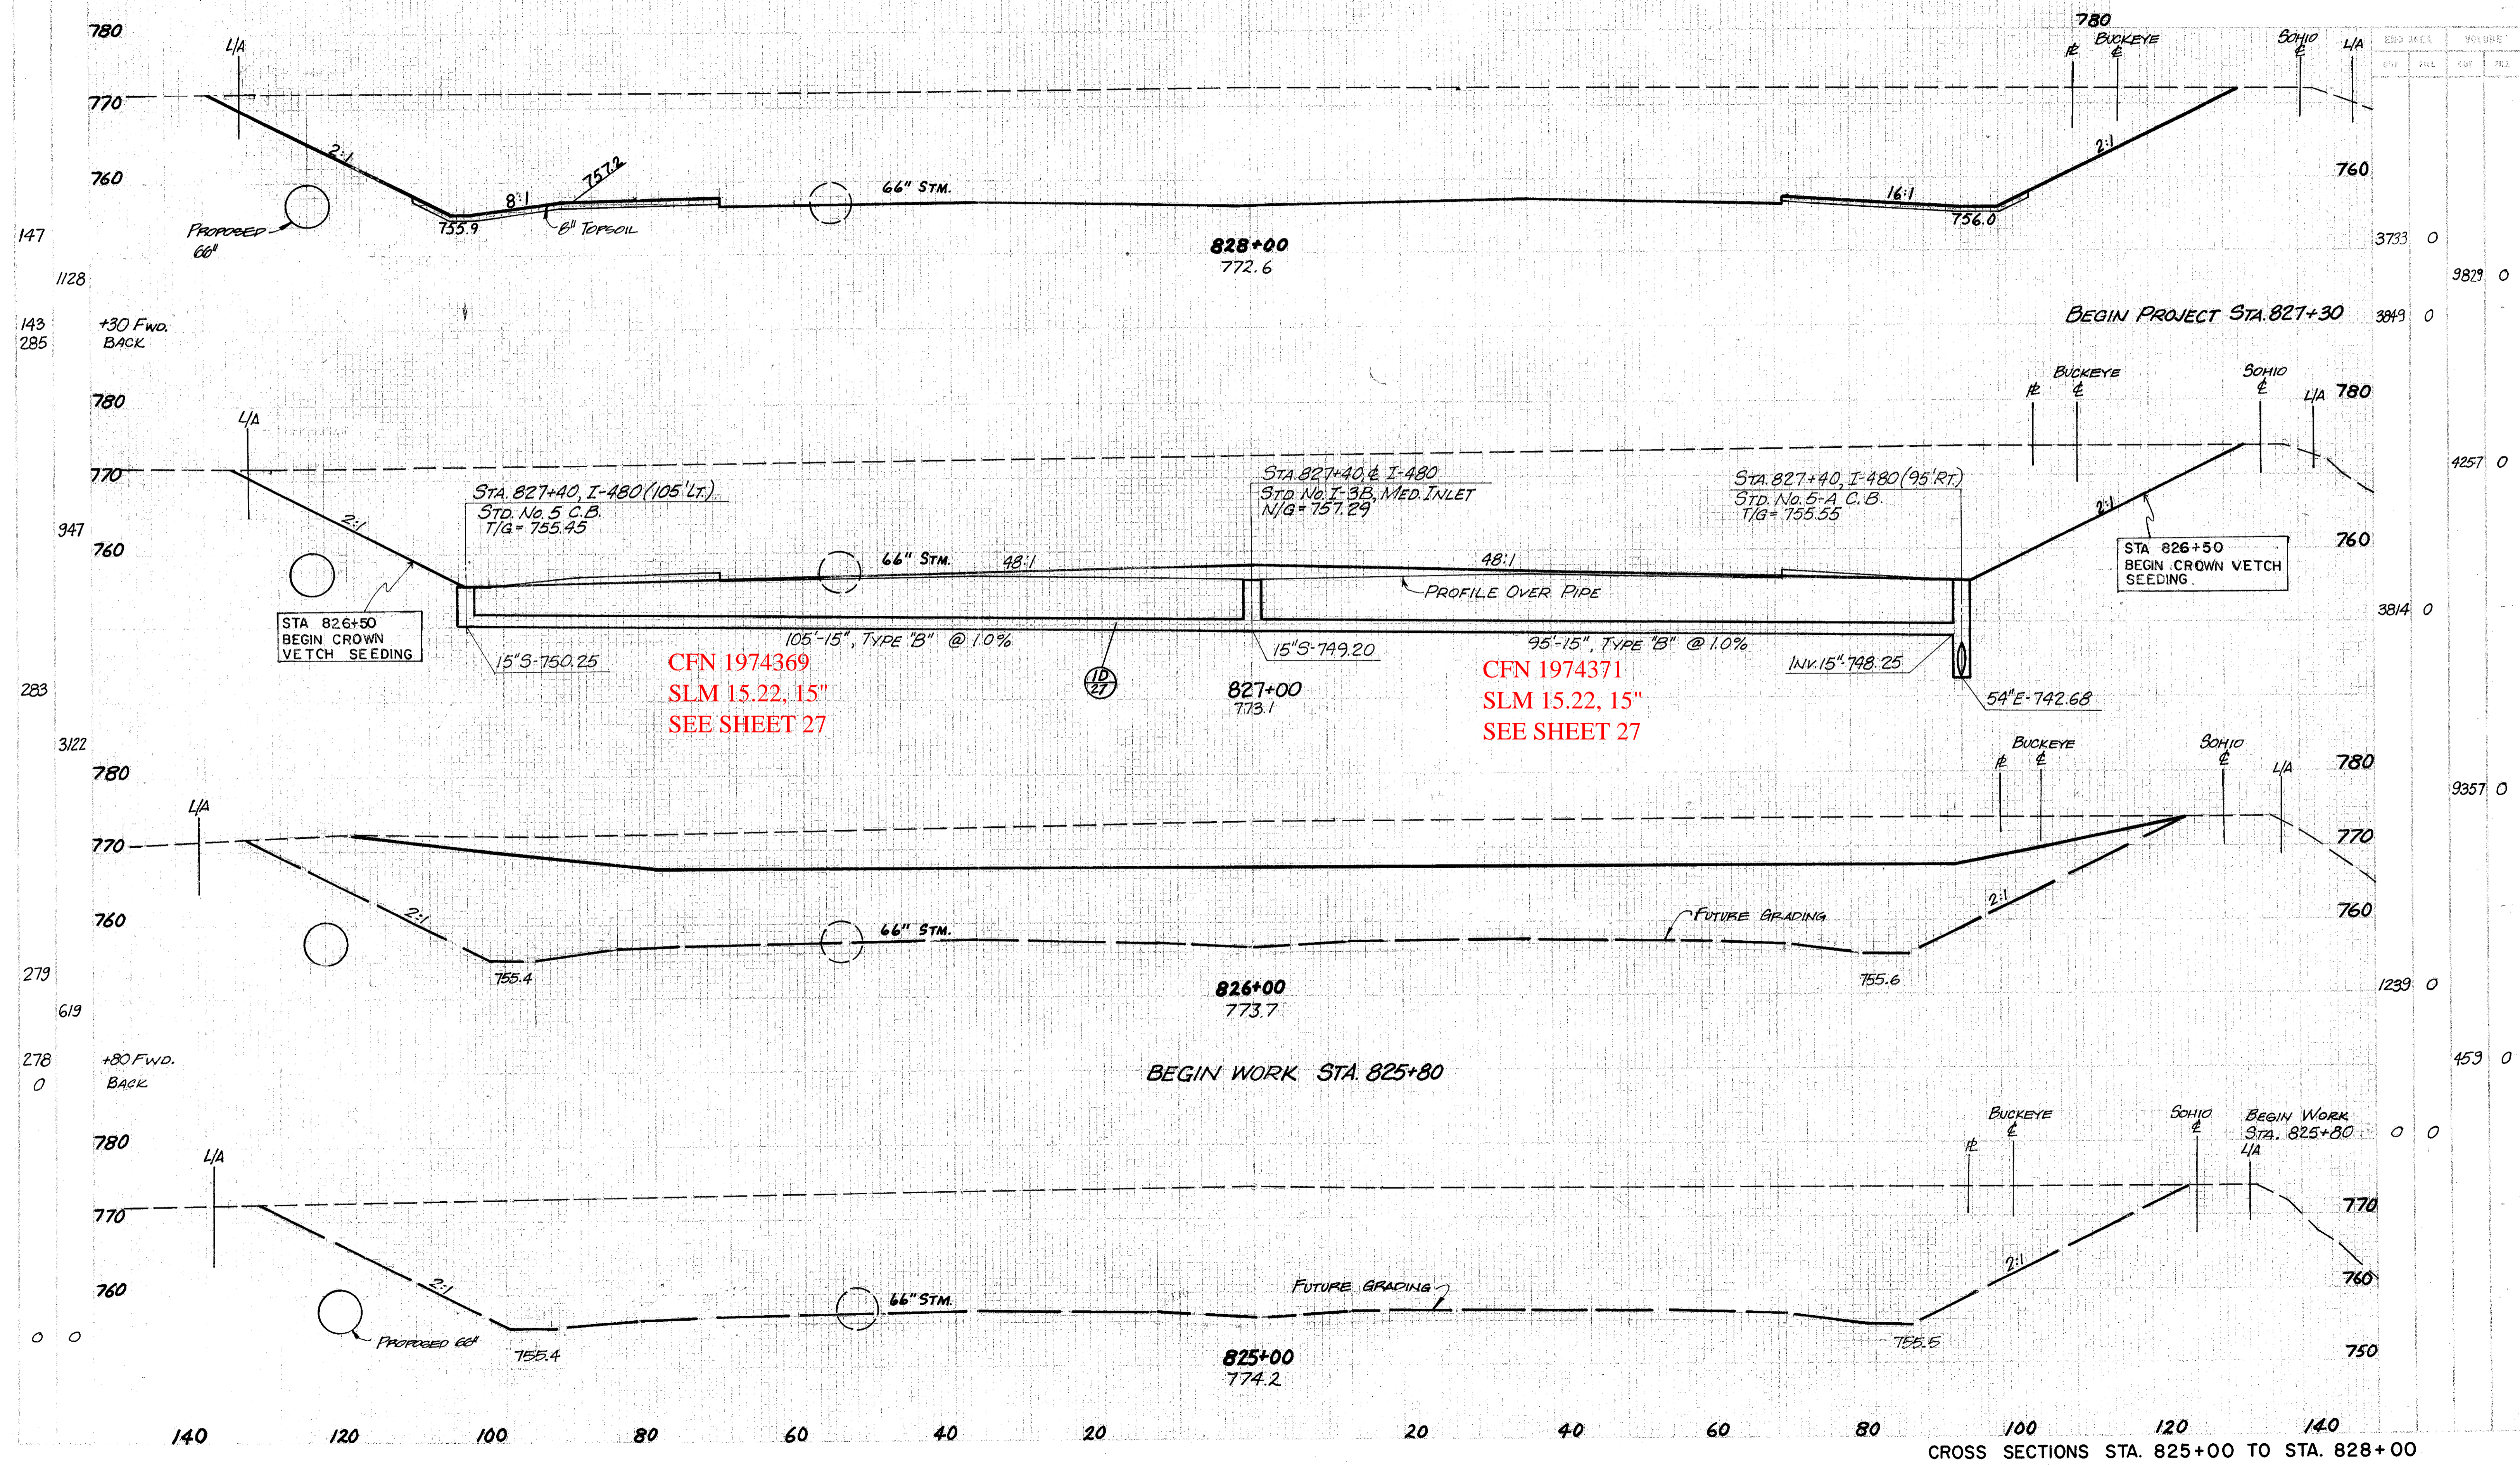

CROSS SECTION	CROSS AREA		VOLUME	
	EST.	FILL	CUT	FILL
147				
1128				
143				
285				
947				
283				
3122				
279				
619				
278				
0				
0				

CFN 1974369
 SLM 15.22, 15"
 SEE SHEET 27

CFN 1974371
 SLM 15.22, 15"
 SEE SHEET 27

CROSS SECTIONS STA. 825+00 TO STA. 828+00