


CALC. BY APH DATE 11/78  
 CHKD. BY RES DATE 12/78

PLAN NO.	STATE	PROJECT
2	OHIO	

CUYAHOGA COUNTY  
 CUY-480-10.39

149  
 500

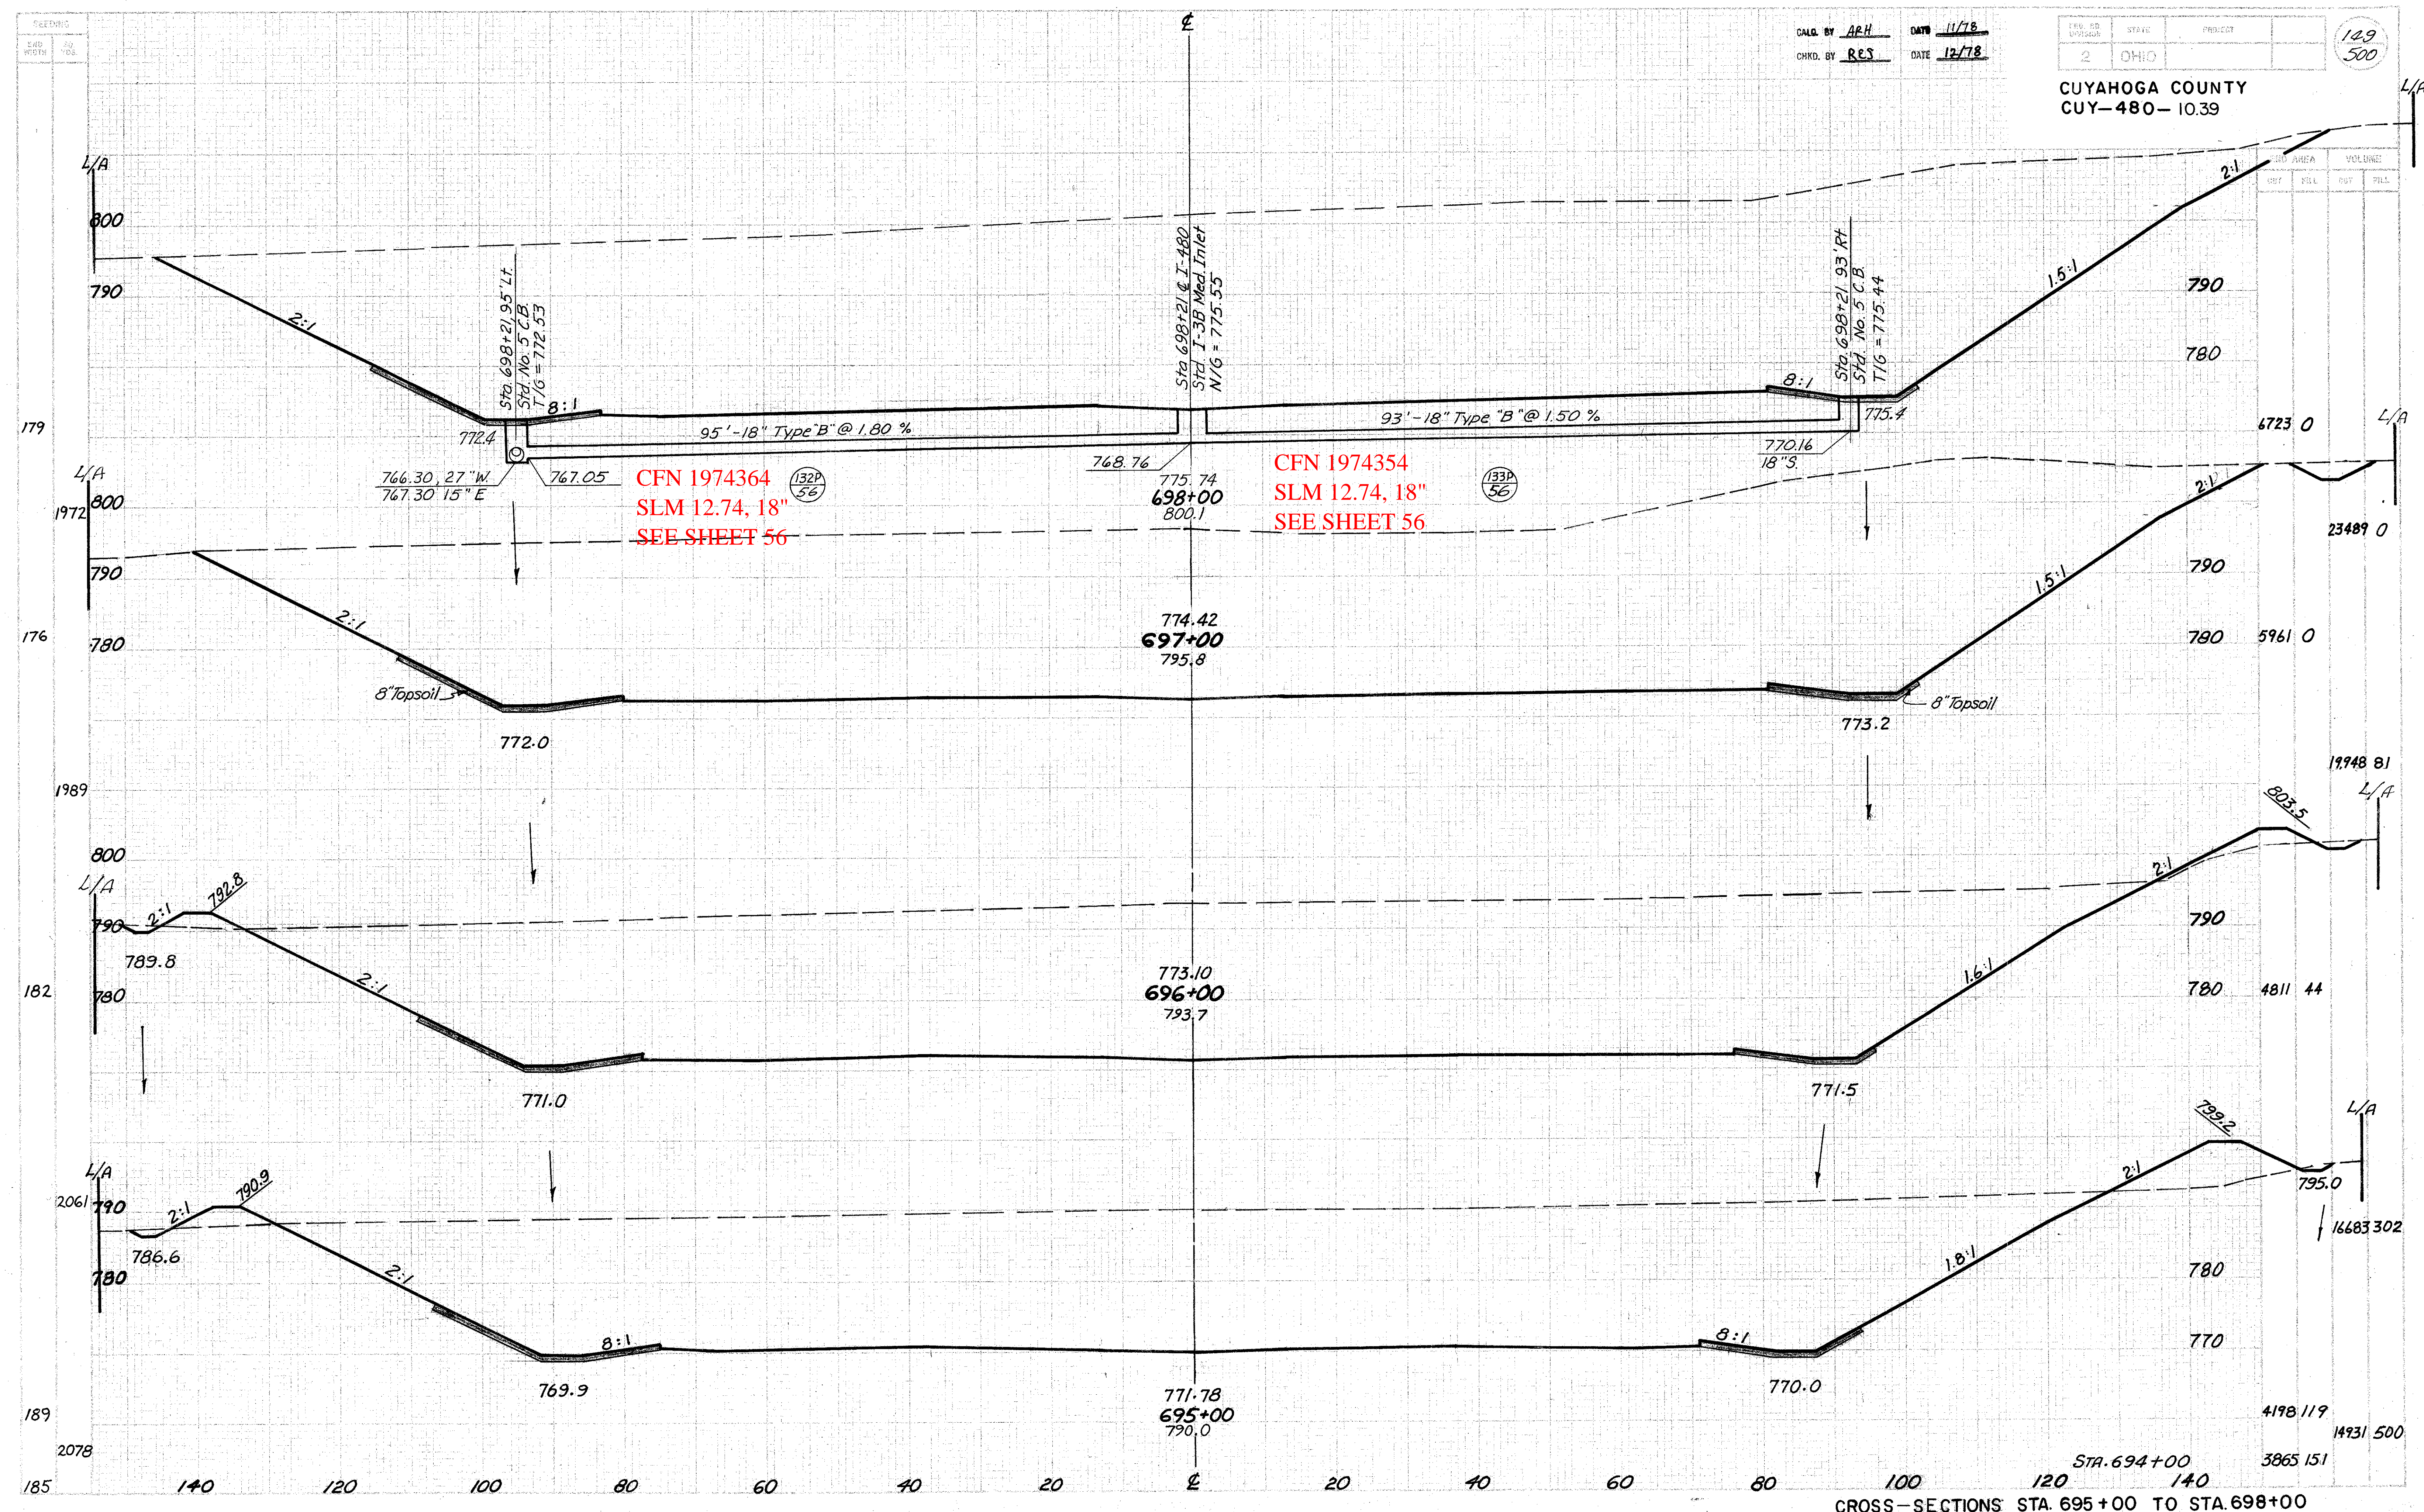

CFN 1974364  
 SLM 12.74, 18"  
 SEE SHEET 56

CFN 1974354  
 SLM 12.74, 18"  
 SEE SHEET 56

CROSS-SECTIONS STA. 695+00 TO STA. 698+00