

SLM 13.30, 42"  
SEE BELOW

SLM 13.37, 36"  
SEE BELOW

SLM 13.52, 24"  
SEE BELOW

CALC. BY WAM DATE 10/83  
CHKD. BY B.B. DATE 1/84

FILE NO.	STATE	PROJECT	TYPE FUNDS
2	OHIO		

49  
632

CUYAHOGA COUNTY  
CUY-480-12.08

CFN 1974366  
SLM 13.52, 24"  
SEE SHEET 142

CFN 1974348  
SLM 13.52, 15"  
SEE SHEET 115

CFN 1974343  
SLM 13.52, 24"  
SEE SHEET 142

TREE REMOVAL  
730+00 TO 740+00



SIZE	NO.
18"	38
30"	14

CFN 1974362  
SLM 13.37, 15"  
SEE SHEET 139

CFN 1974365  
SLM 13.52, 15"  
SEE SHEET 111

PROJECT NO. 480-12-08  
SHEET NO. 142  
DATE 1/84

PROJECT NO. 480-12-08  
SHEET NO. 142  
DATE 1/84

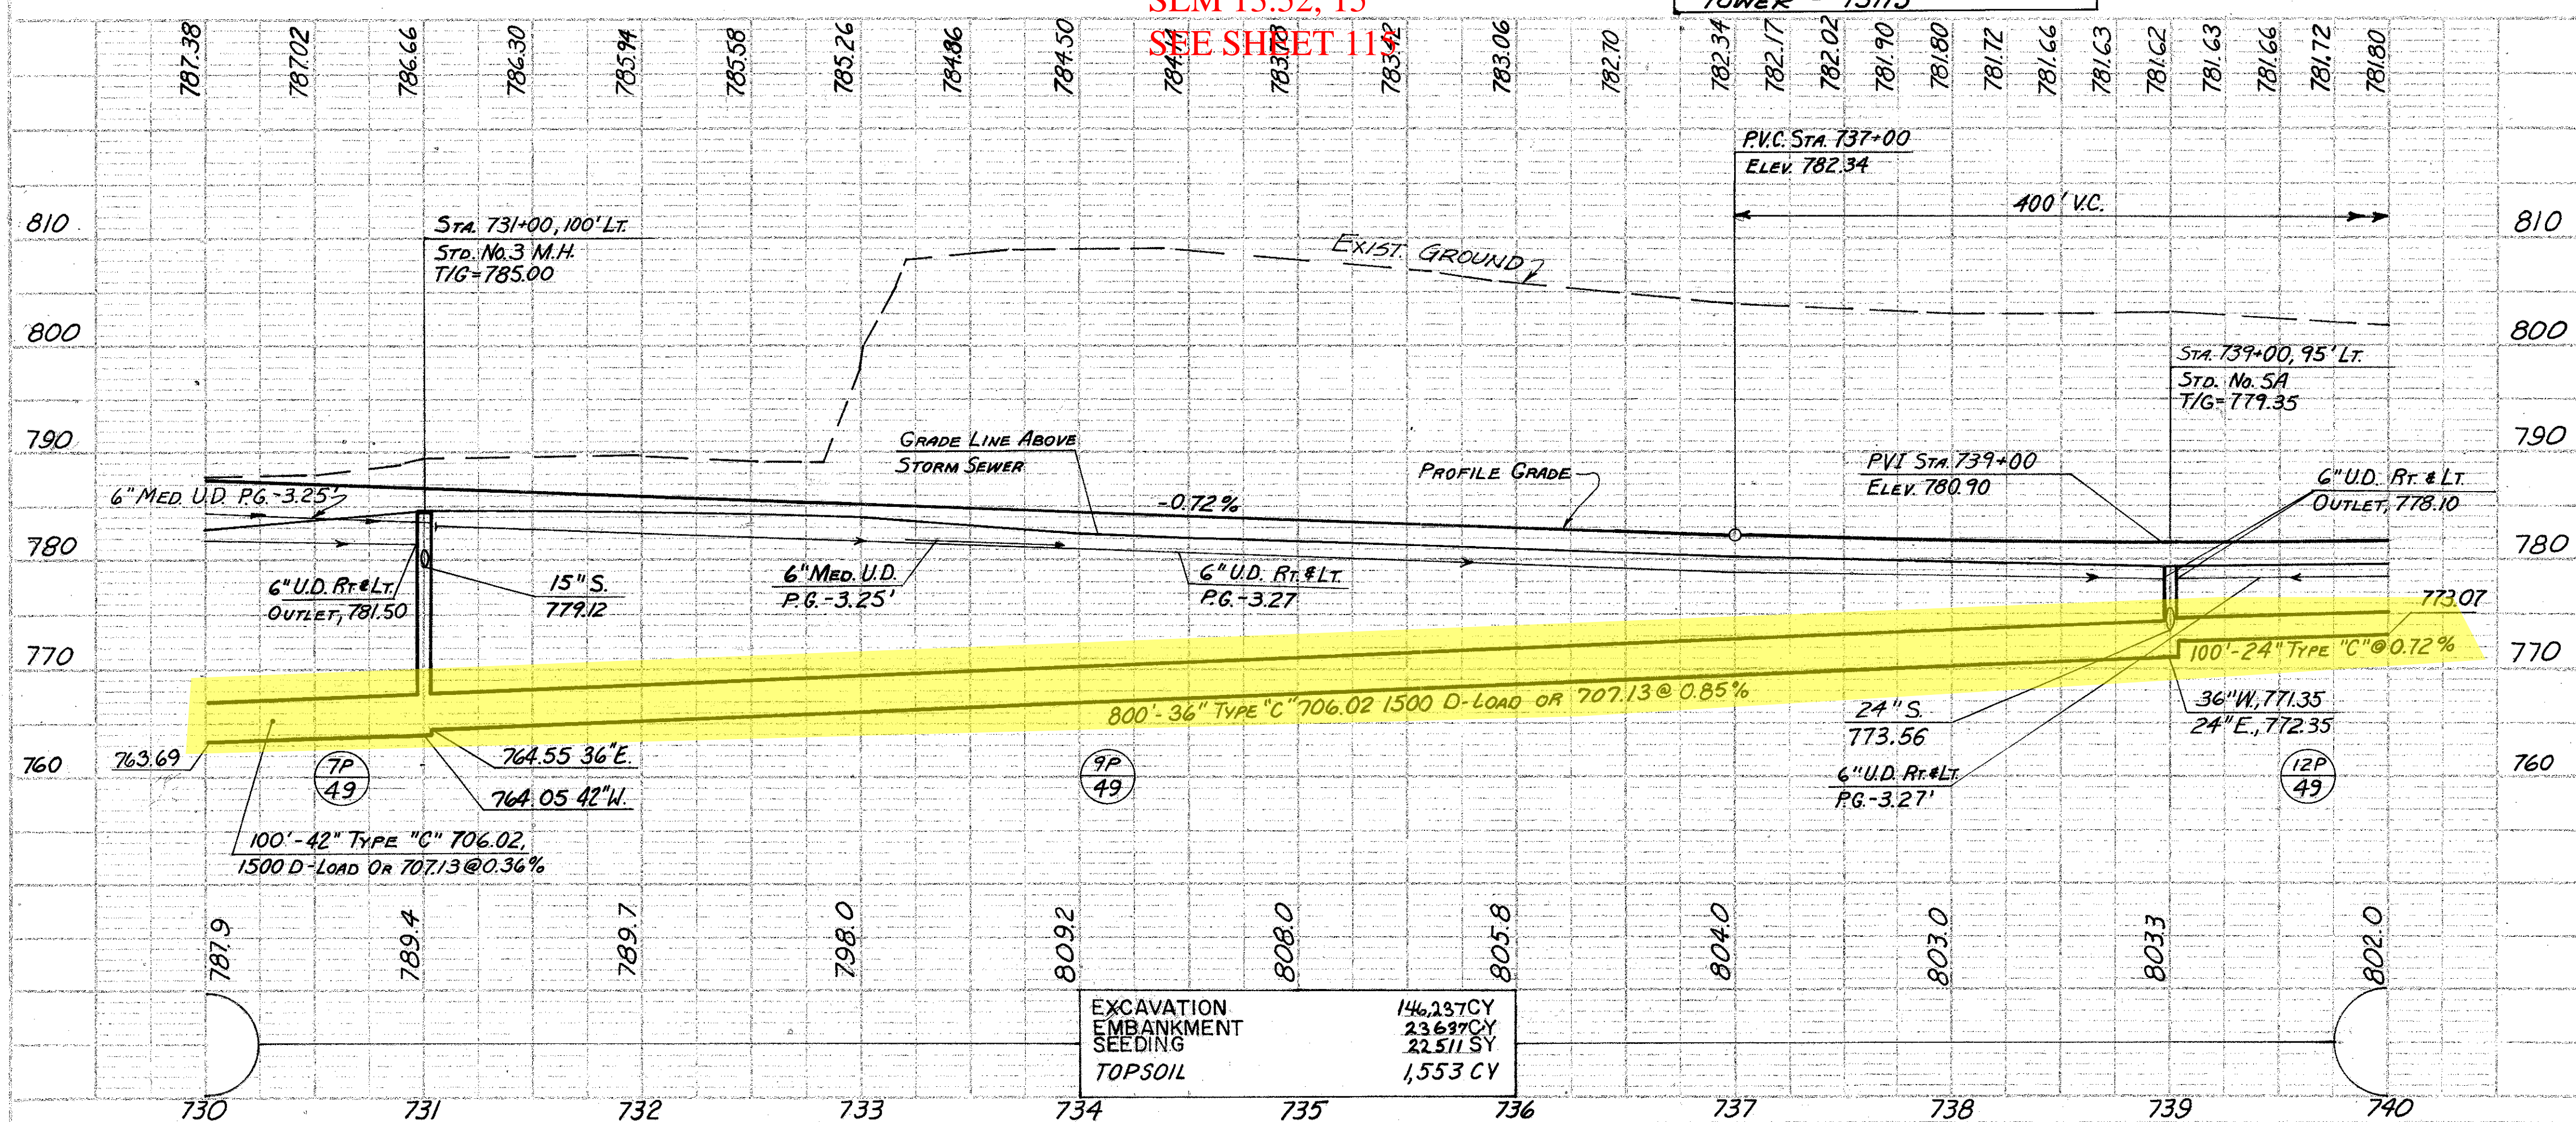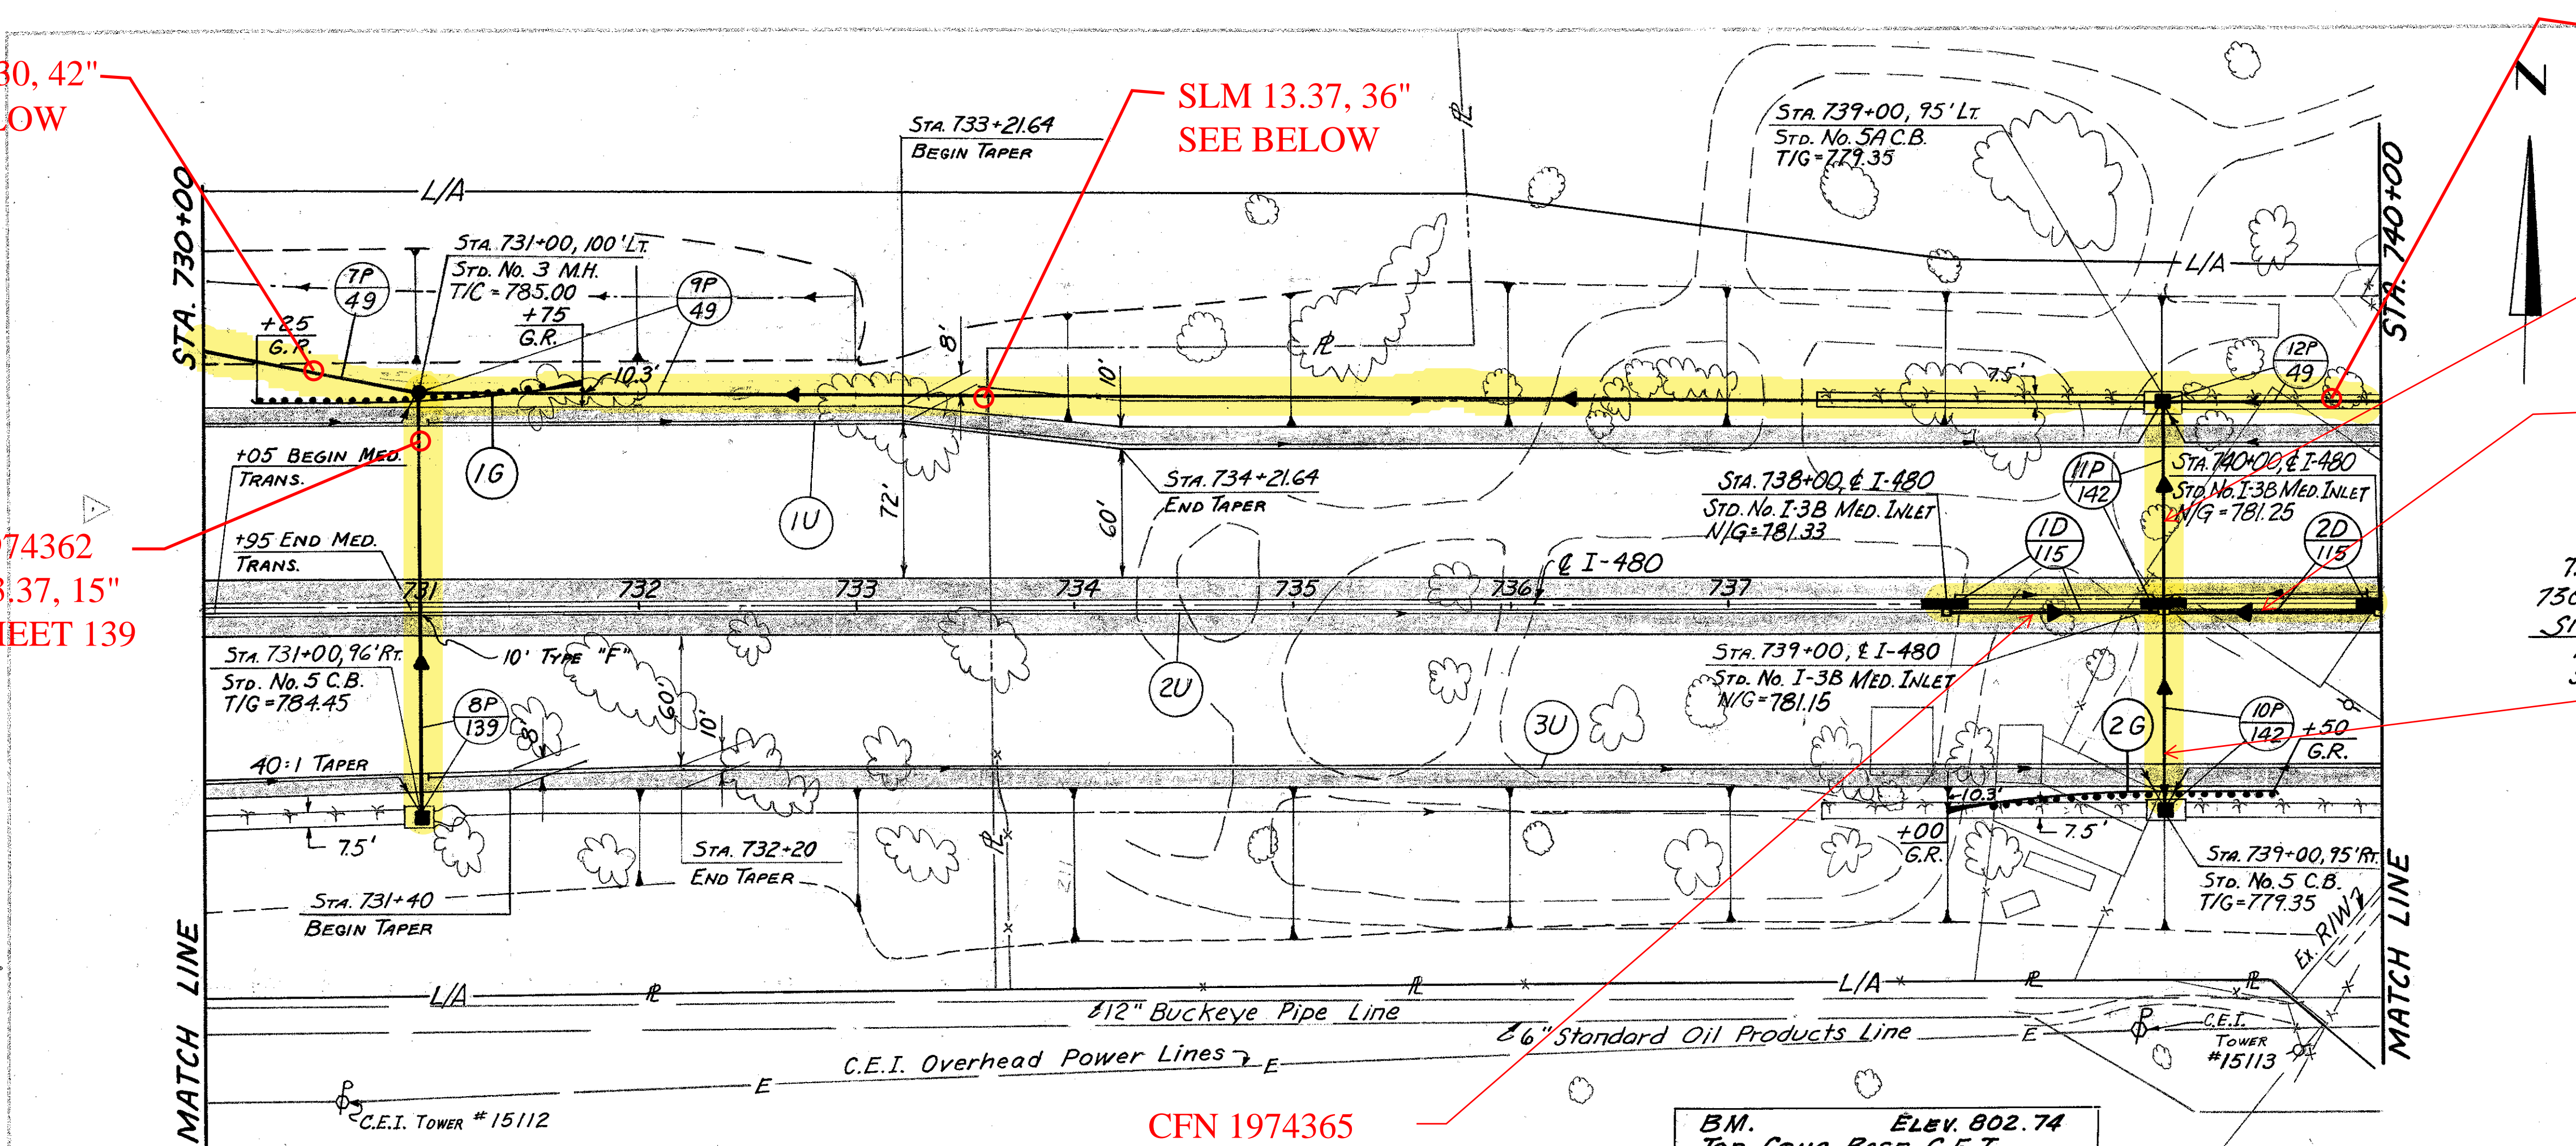

606	Anchor Assembly Type A	EA																		
	Guard Rail Type 5	EA																		
	Anchor Assembly Type T	EA																		
Spec.	SEEDING & EROSION CONTROL MATTING	SY	77	200	200														477	
605	UNCLASSIFIED UNDERDRAINS	6" L.F.							994	960	994								2948	
	BENDS & BRANCHES	EA							3										3	
604	Std. No. 3 M.H.	EA		1															1	
	Std. No. 5 C.B.	EA		1															2	
	Std. No. SA C.B.	EA																	1	
	Std. No. I-3B MEDIAN INLET	EA																	1	
603	TYPE "C" 706.02 1500 D-LOAD OR 707.13	L.F.	100																100	
	TYPE "C"	L.F.	100																100	
	TYPE "B"	L.F.		97	97														194	
	TYPE "B"	L.F.		197															397	
	TYPE "F"	L.F.																	100	
ESTIMATED QUANTITIES																				
