


FED. RD. DIVISION	STATE	PROJECT	

221  
302


CUYAHOGA COUNTY  
MED-42-26.17  
CUY-42-000

ESTIMATED QUANTITIES

I-1	12" Class J-1 Pipe	90 L.F.
	15" Class J-1 Pipe	314 L.F.
	18" Class J-1 Pipe	96 L.F.
	21" Class J-1 Pipe	118 L.F.
	24" Class J-1 Pipe	56 L.F.
	27" Class J-1 Pipe	430 L.F.
I-8	Std. No. 4 C.B.	3 Ea.
	Std. No. 5 C.B.	2 Ea.
	Std. No. 6 C.B.	3 Ea.

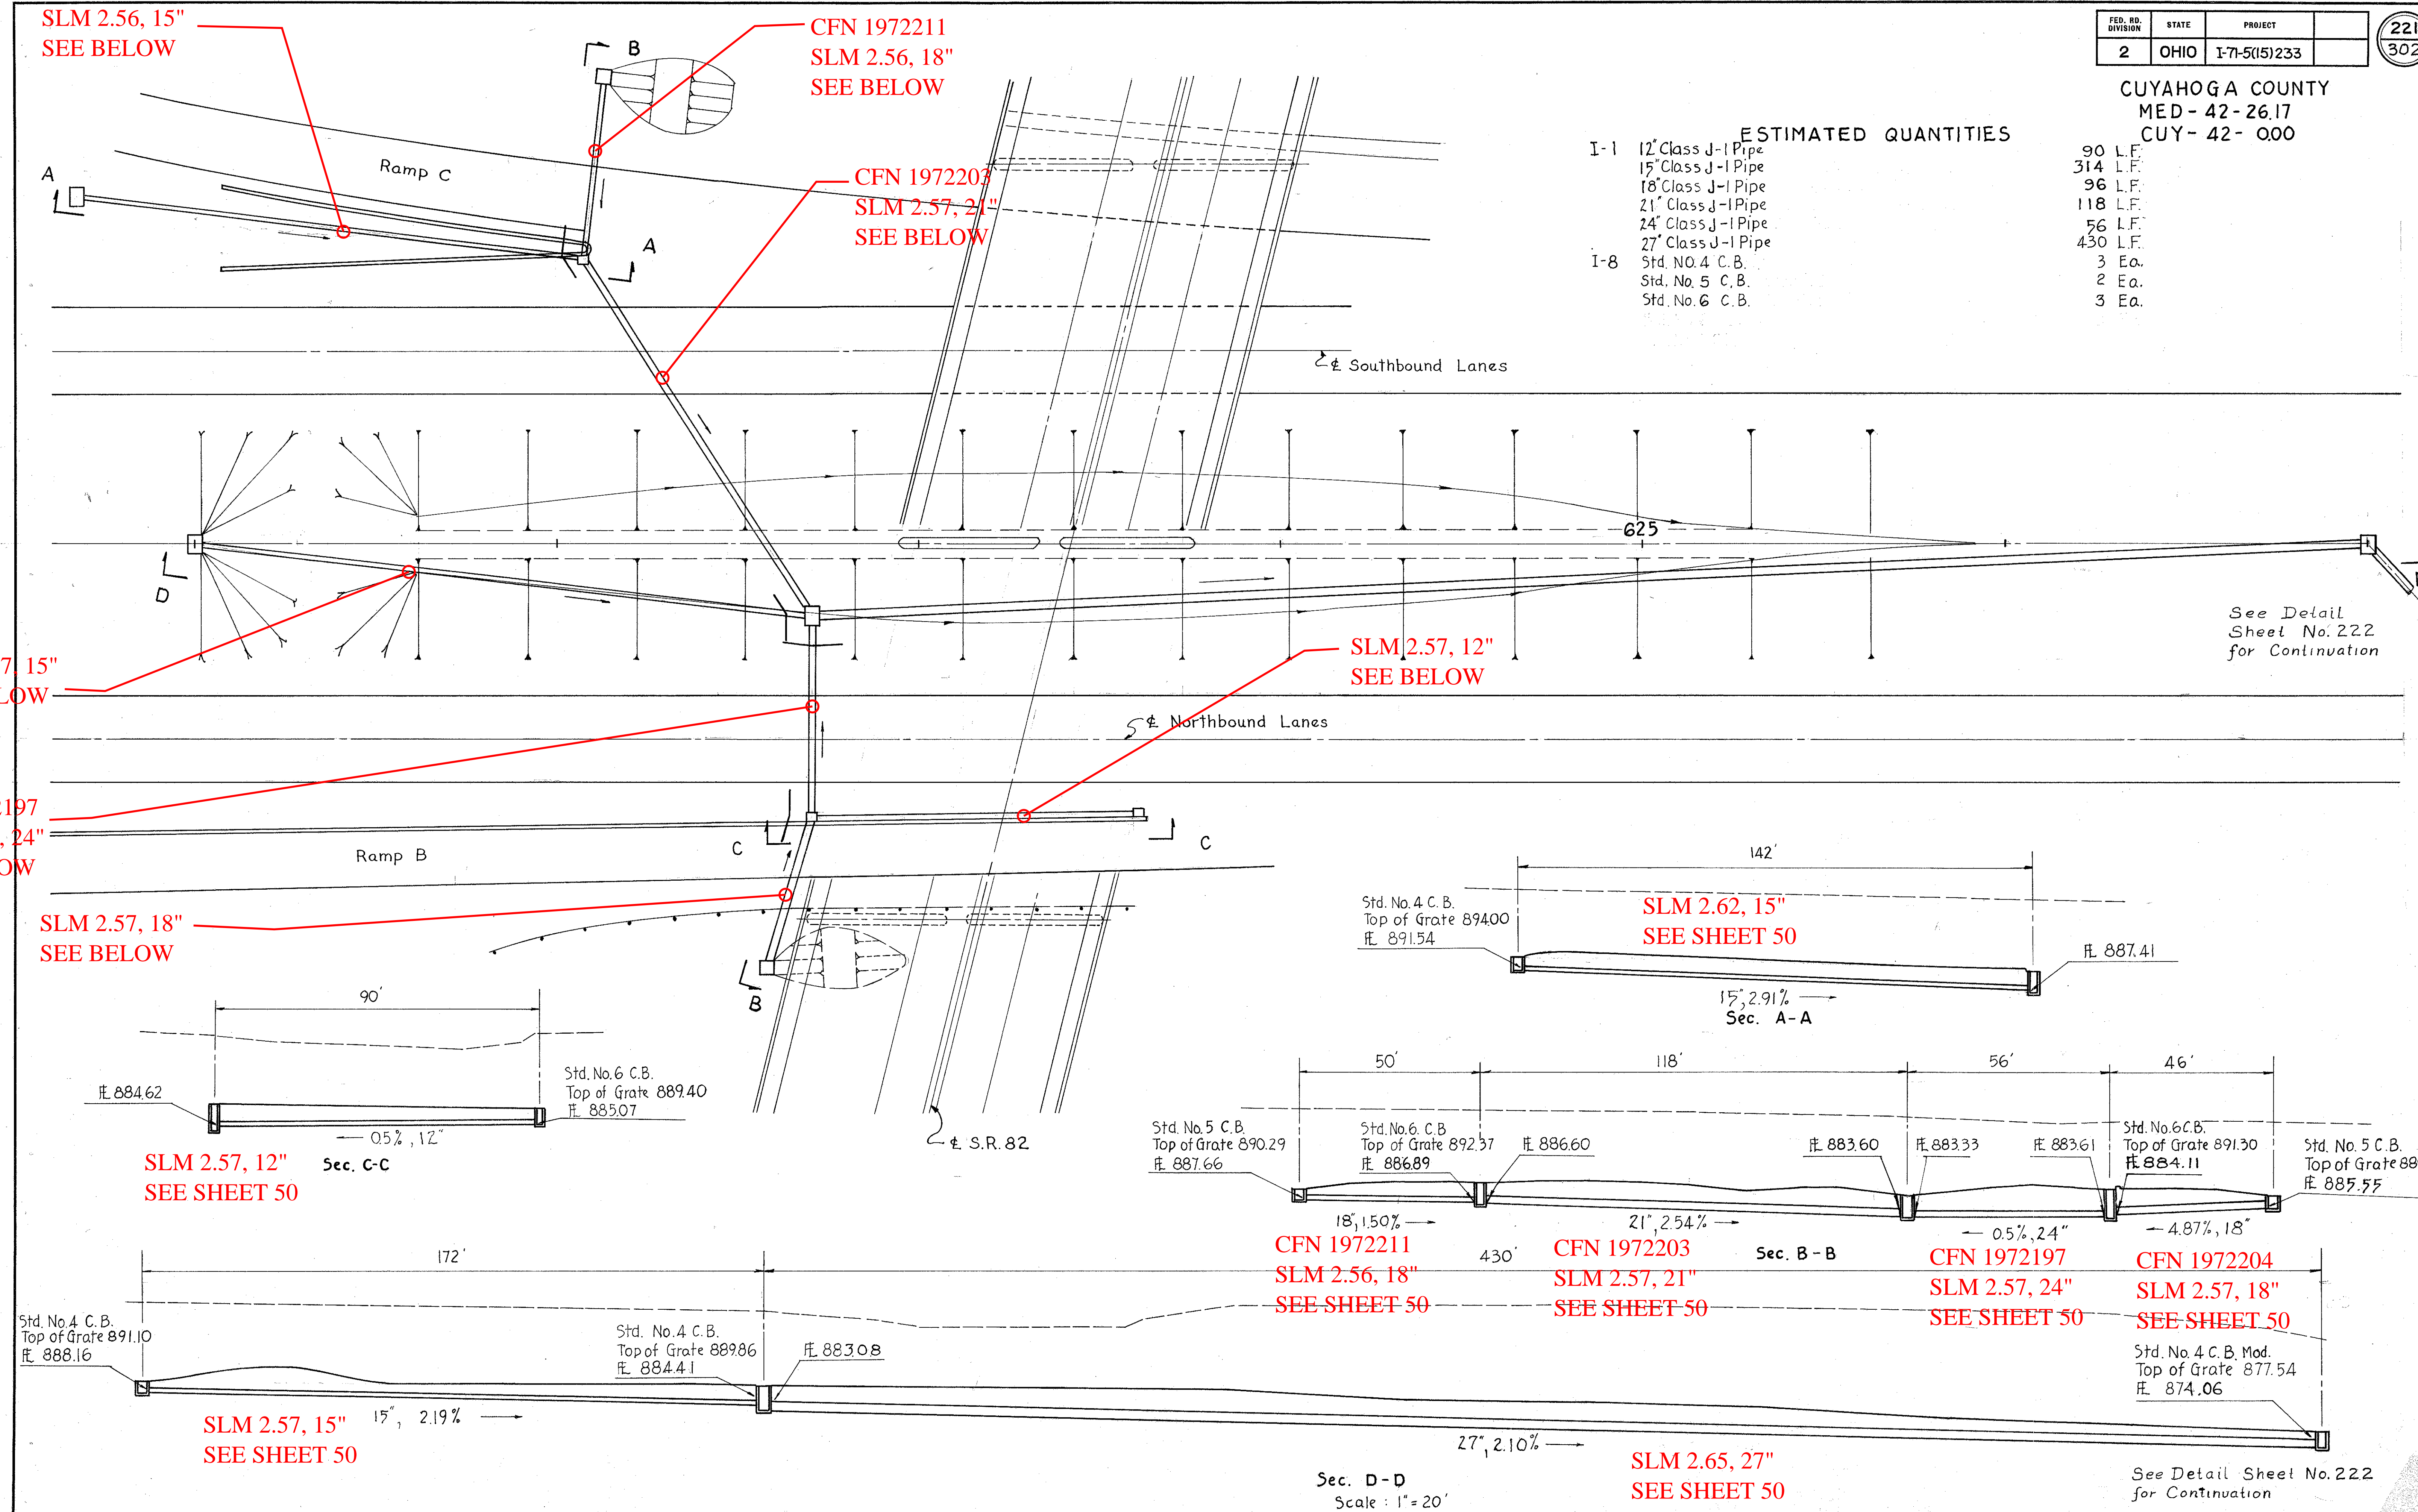

See Detail Sheet No. 222 for Continuation

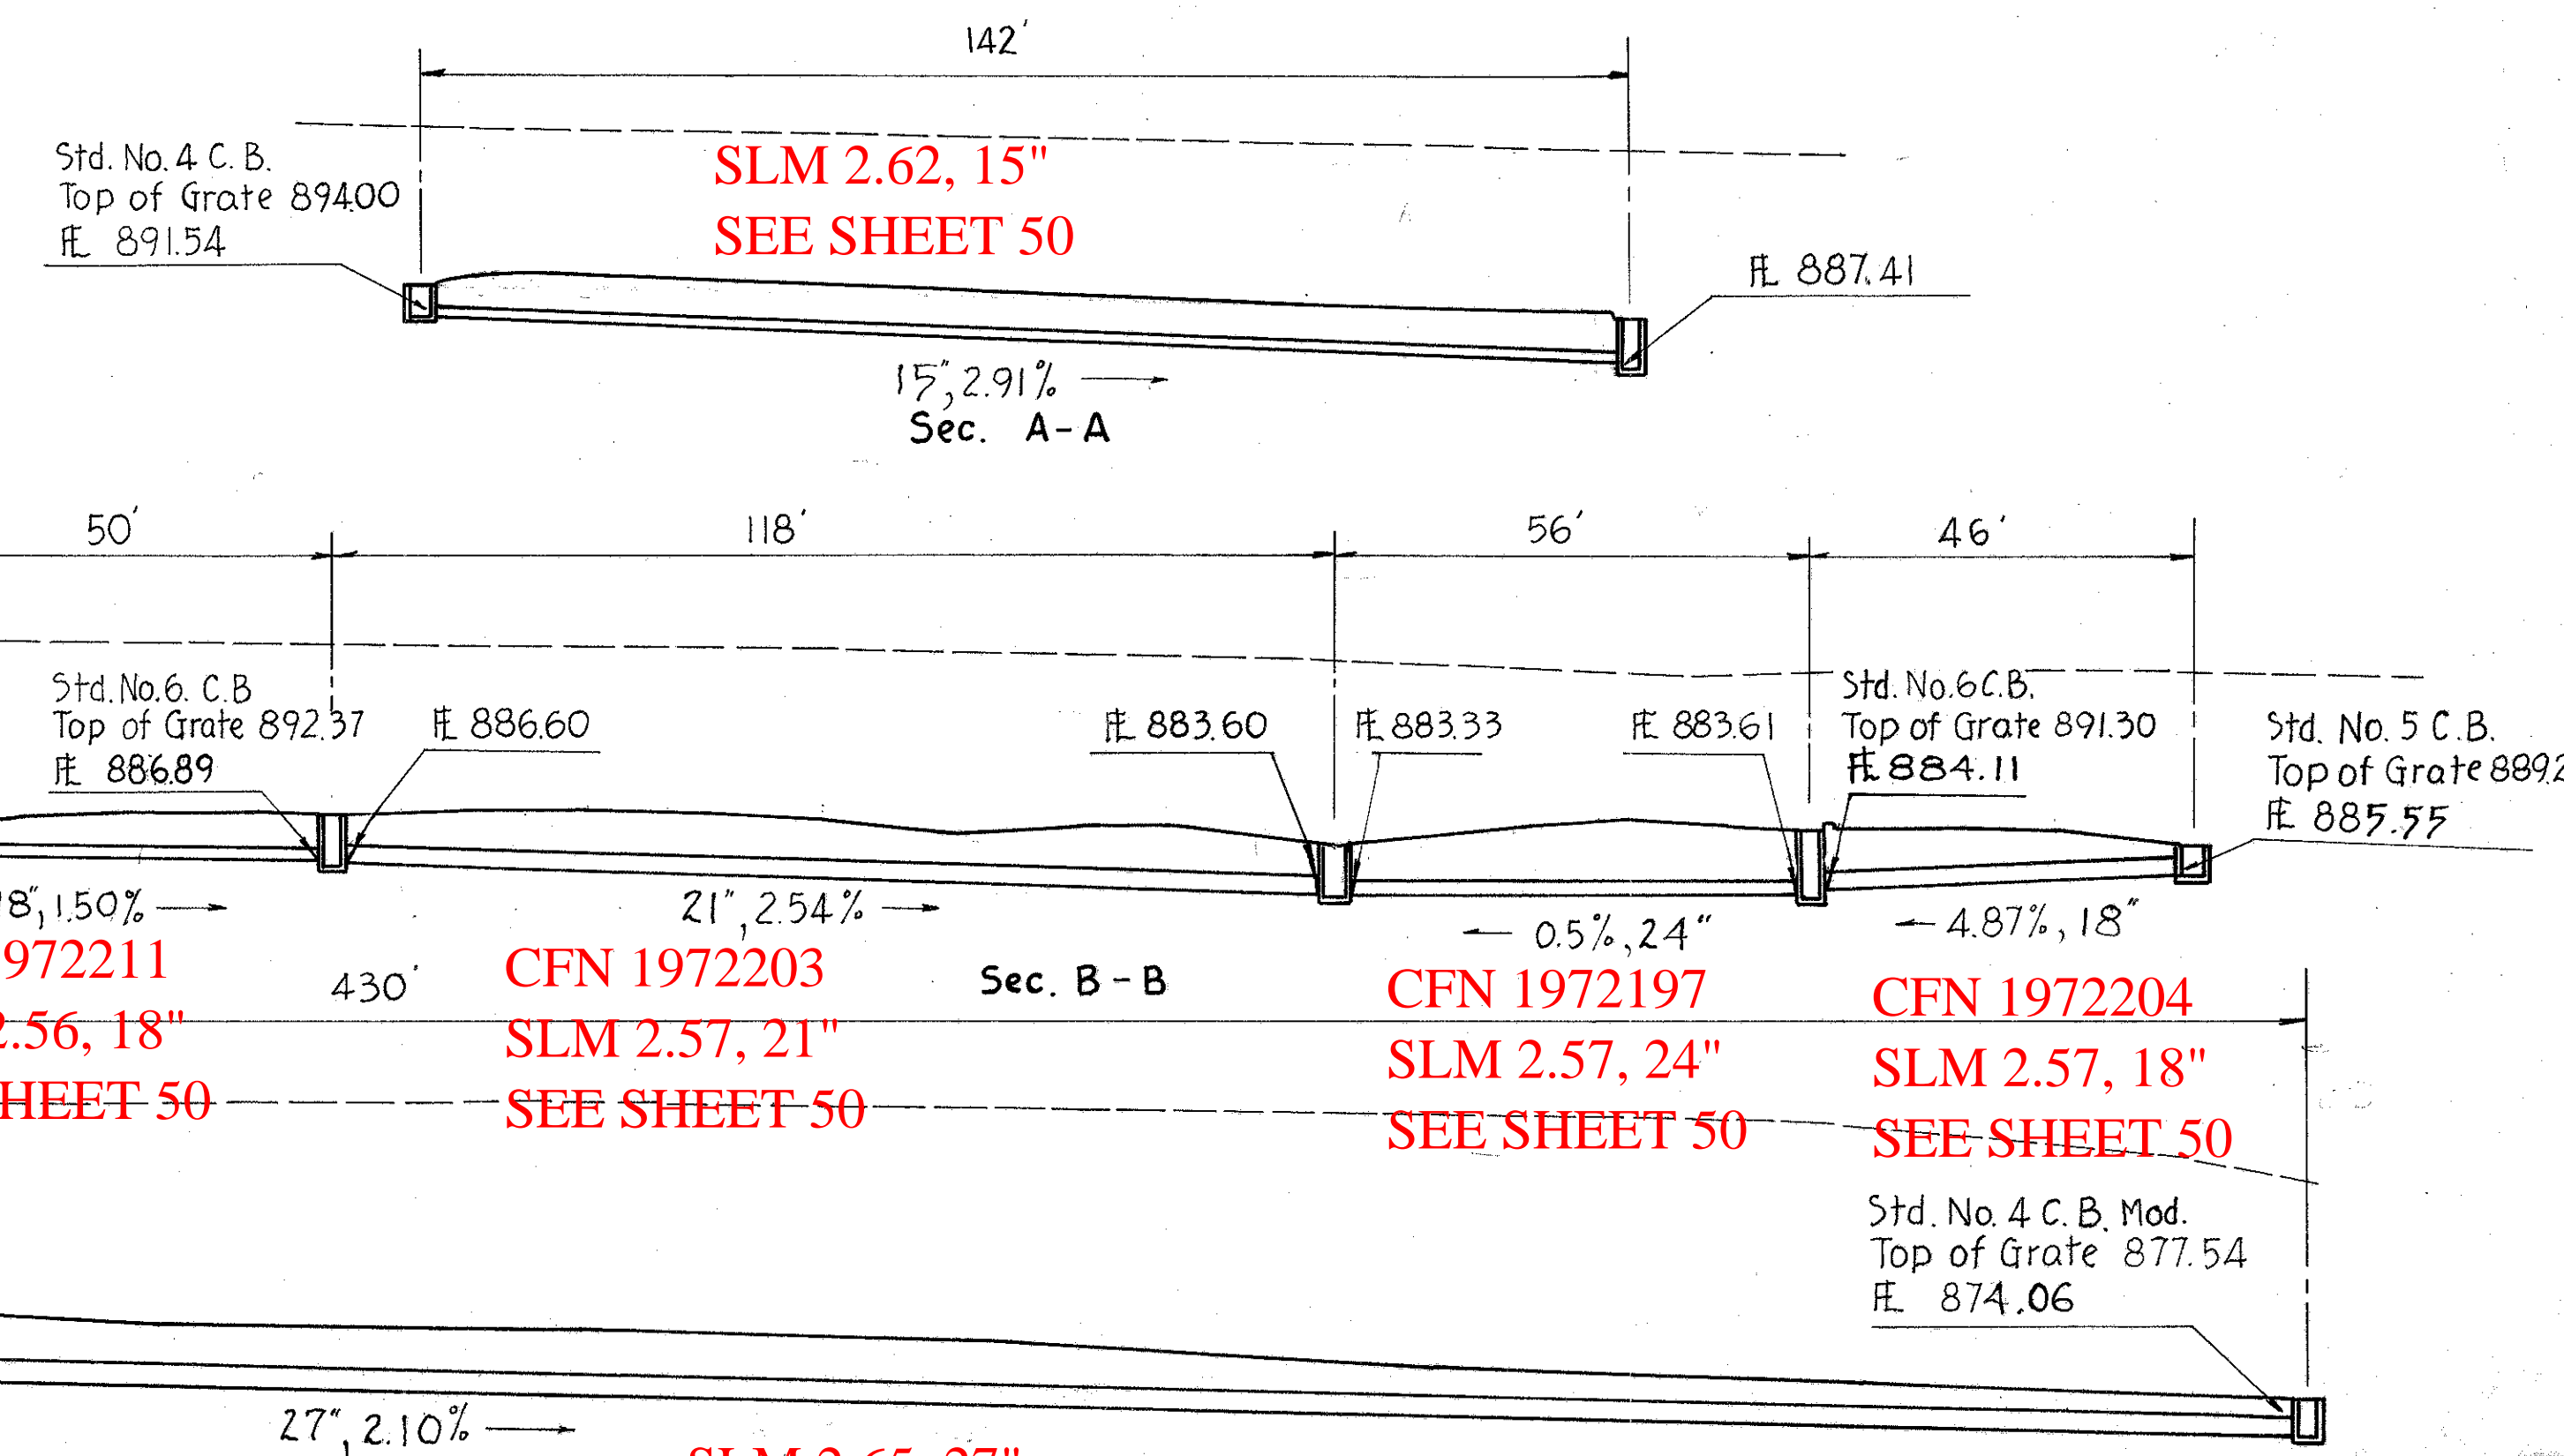

See Detail Sheet No. 222 for Continuation

Scale: 1" = 20'