

CFN 1972255
SLM 6.55, 12"
SEE SHEET 184


CFN 1972264
SLM 6.55, 12"
SEE SHEET 184

CFN 1972258
SLM 6.61, 12"
SEE SHEET 184

FED. RD. DIVISION 2	STATE OHIO	PROJECT	FISCAL YEAR
------------------------	---------------	---------	-------------

28
353

CUYAHOGA COUNTY
CUY-71-5.72

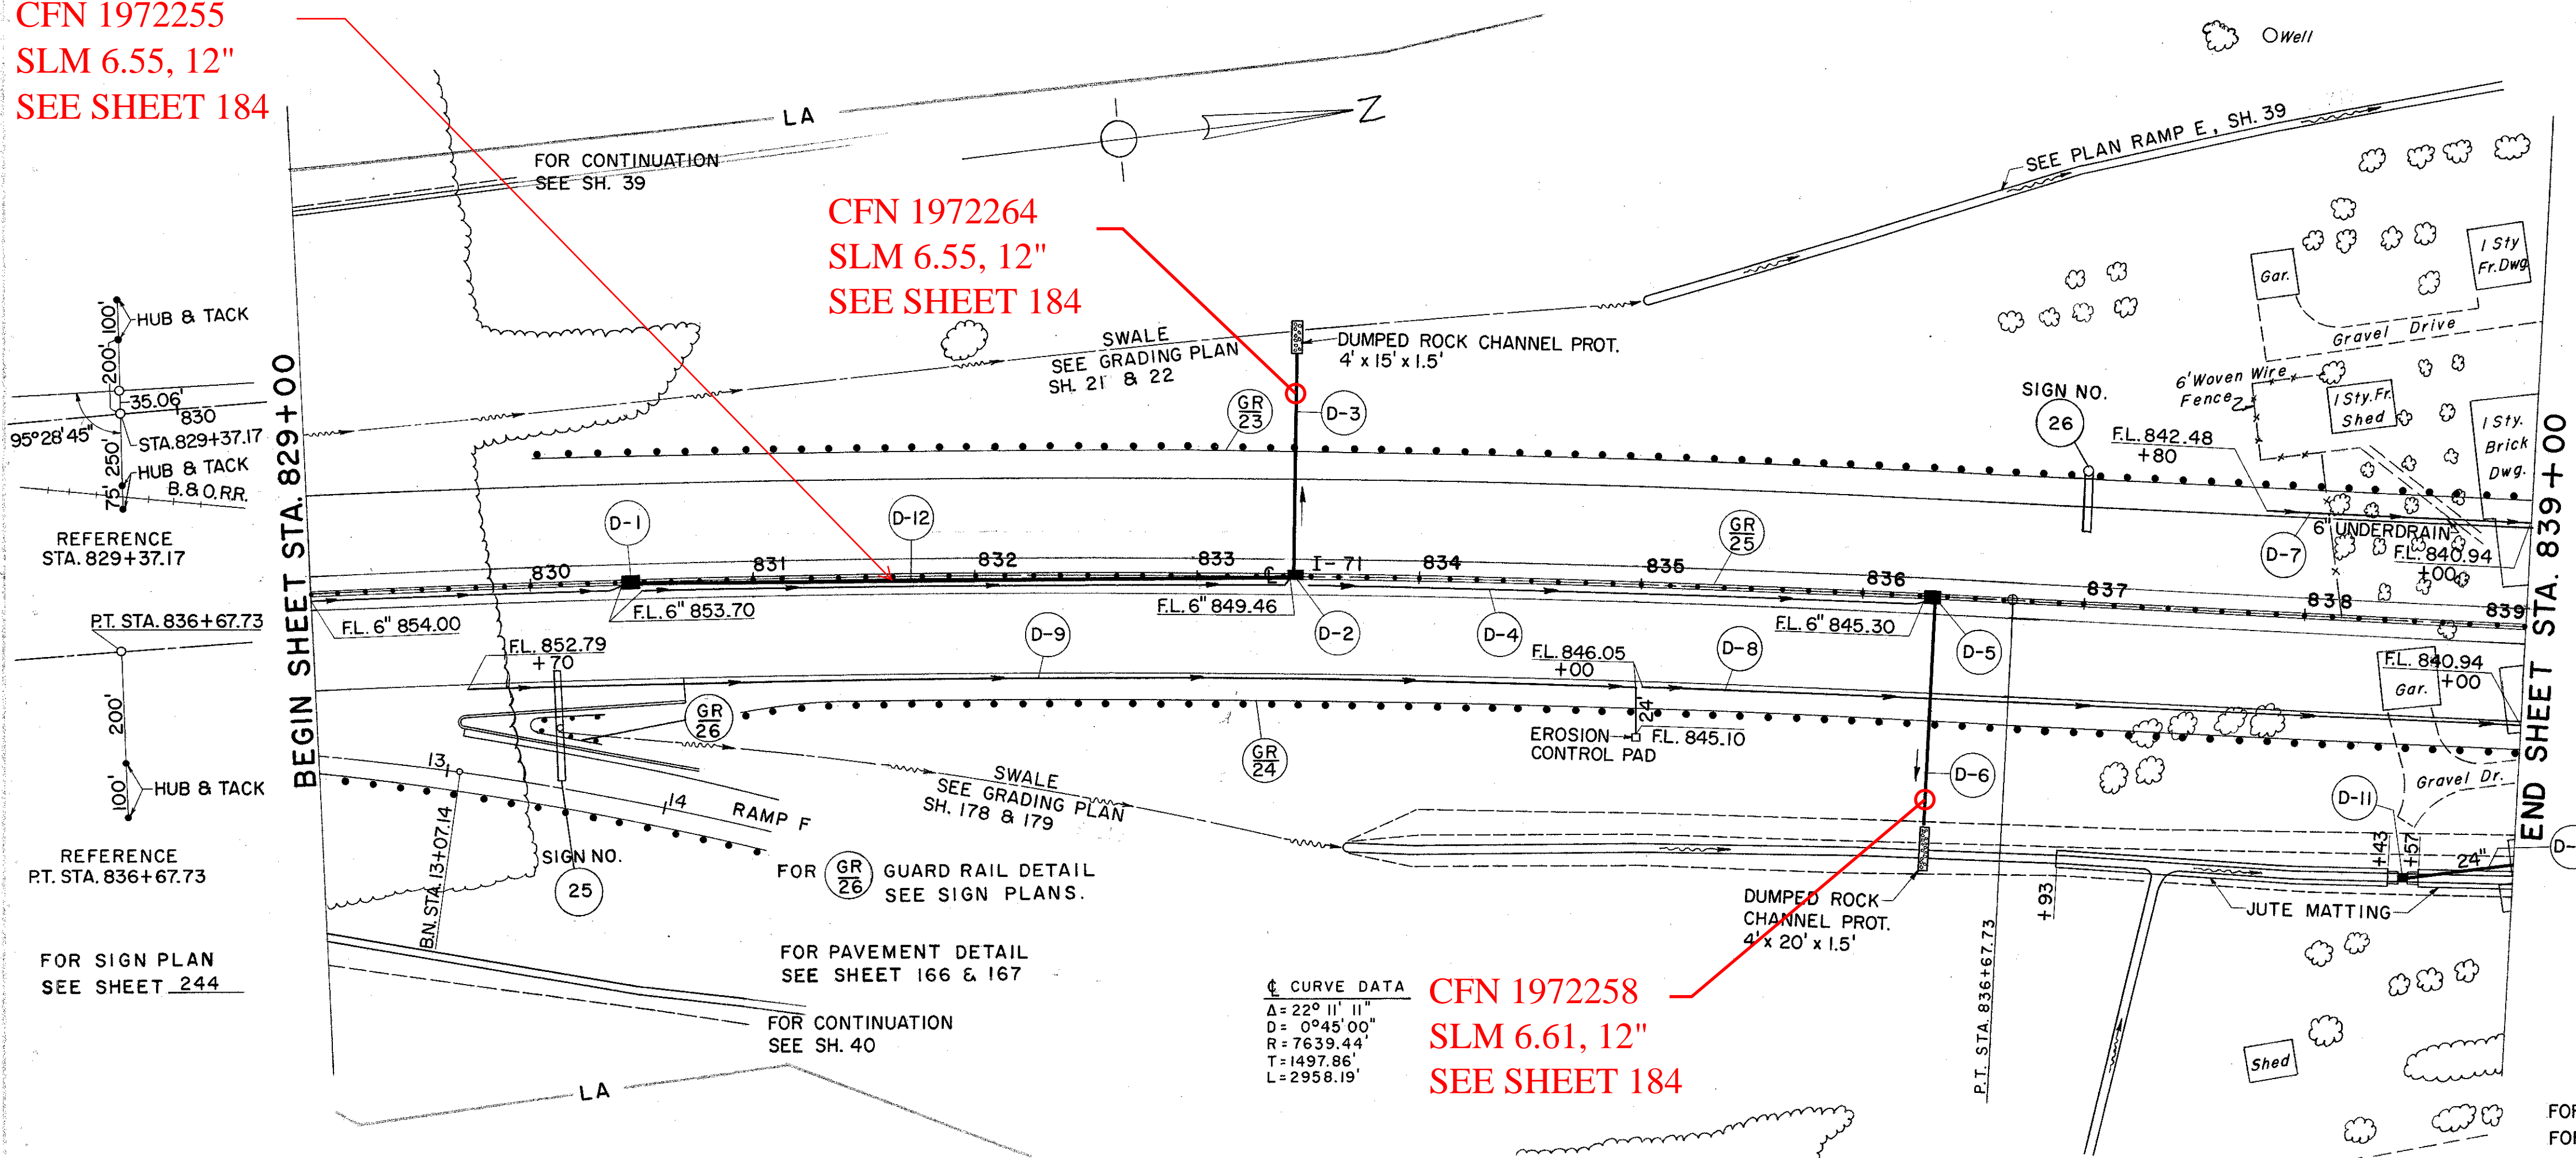

D DRAINAGE


REF. NO.	STATION	FROM	TO	ITEM I-1																					
				6" PIPE, CLASS J-1 SEC. 1, 2, 3 (D) (M) (6.8) OR W-6.5 (D) SHALLOW	6" PIPE, CLASS I-3 SHALLOW	6" PIPE, CLASS F-4 SHALLOW	12" PIPE, CLASS J-1	12" PIPE, CLASS F-4	24" PIPE, CLASS E-1	MASONRY	12" PIPE, CLASS E-1	6"-90° BENDS CLASS I-3	12"-25° BENDS CLASS F-4	STD. NO. 5 CATCH BASIN	STD. 2-A-8 PAVED SHOULDER INLET	MOD. 2-A-8 PAVED SHOULDER INLET	DUMPED ROCK CHANNEL PROTECTION	SODDING	JUTE MATTING						
				L.F.	L.F.	L.F.	L.F.	L.F.	L.F.	C.Y.	L.F.	EA.	EA.	EA.	EA.	EA.	C.Y.	S.Y.	S.Y.						
D-1	830+45																								
D-2	833+45																								
D-3	833+45	DITCH	LT.																						
D-4	829+00	836+45				729			60	38	0.3														
D-5	836+45																								
D-6	836+45	DITCH	RT.						60	43	0.3														
D-7	837+80	839+00	LT.			120																			
D-8	835+00	839+00	RT.			390	10																		
D-9	829+70	835+00	RT.			100	444	10																	
D-10	838+50	839+00	RT.																						
D-11	838+50	118' RT.																	153						
D-12	830+45	833+45																							
TOTALS						100	1683	20	120	81	50	0.6					300	1	4	1	1	2	7.9	3.0	153

ROADWAY

REF. NO.	STATION	FROM	TO	ITEM I-15	GUARD RAIL LIN. FT.		
					STEEL BEAM (DEEP)	STANDARD # BARRIER	
GR-23	830+04	839+00	LT.		902		
GR-24	830+98.5	839+00	RT.		797.5		
GR-25	829+00	839+00	M			1000	
GR-26	830+03	830+28	RT.		50		
TOTAL					1699.0	50	1000

* AS PER PLAN

FOR DETAILS OF D-3 AND D-6 SEE SH. 184
FOR DETAILS OF D-10 SEE SH. 193

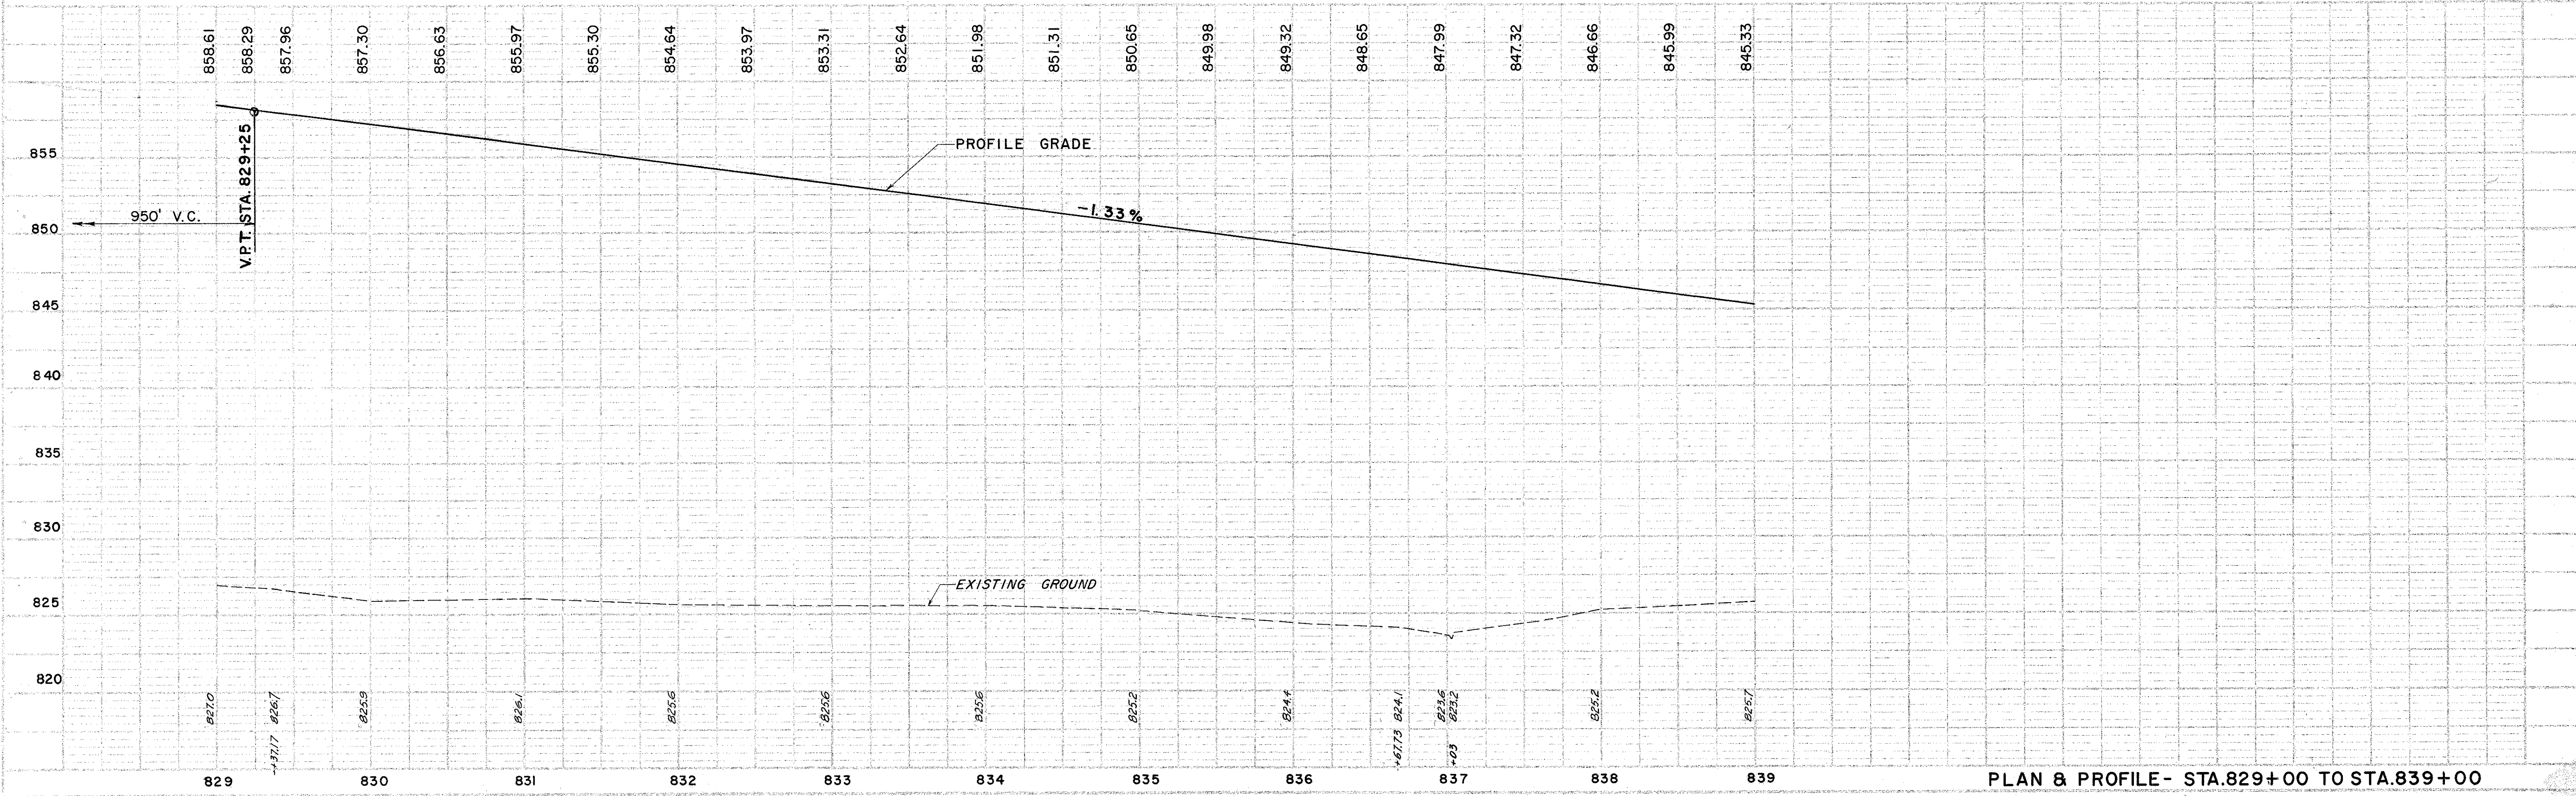

PLAN & PROFILE - STA. 829+00 TO STA. 839+00