FED. RD. DIVISION	STATE	PROJECT	
2	OHIO		

183
353
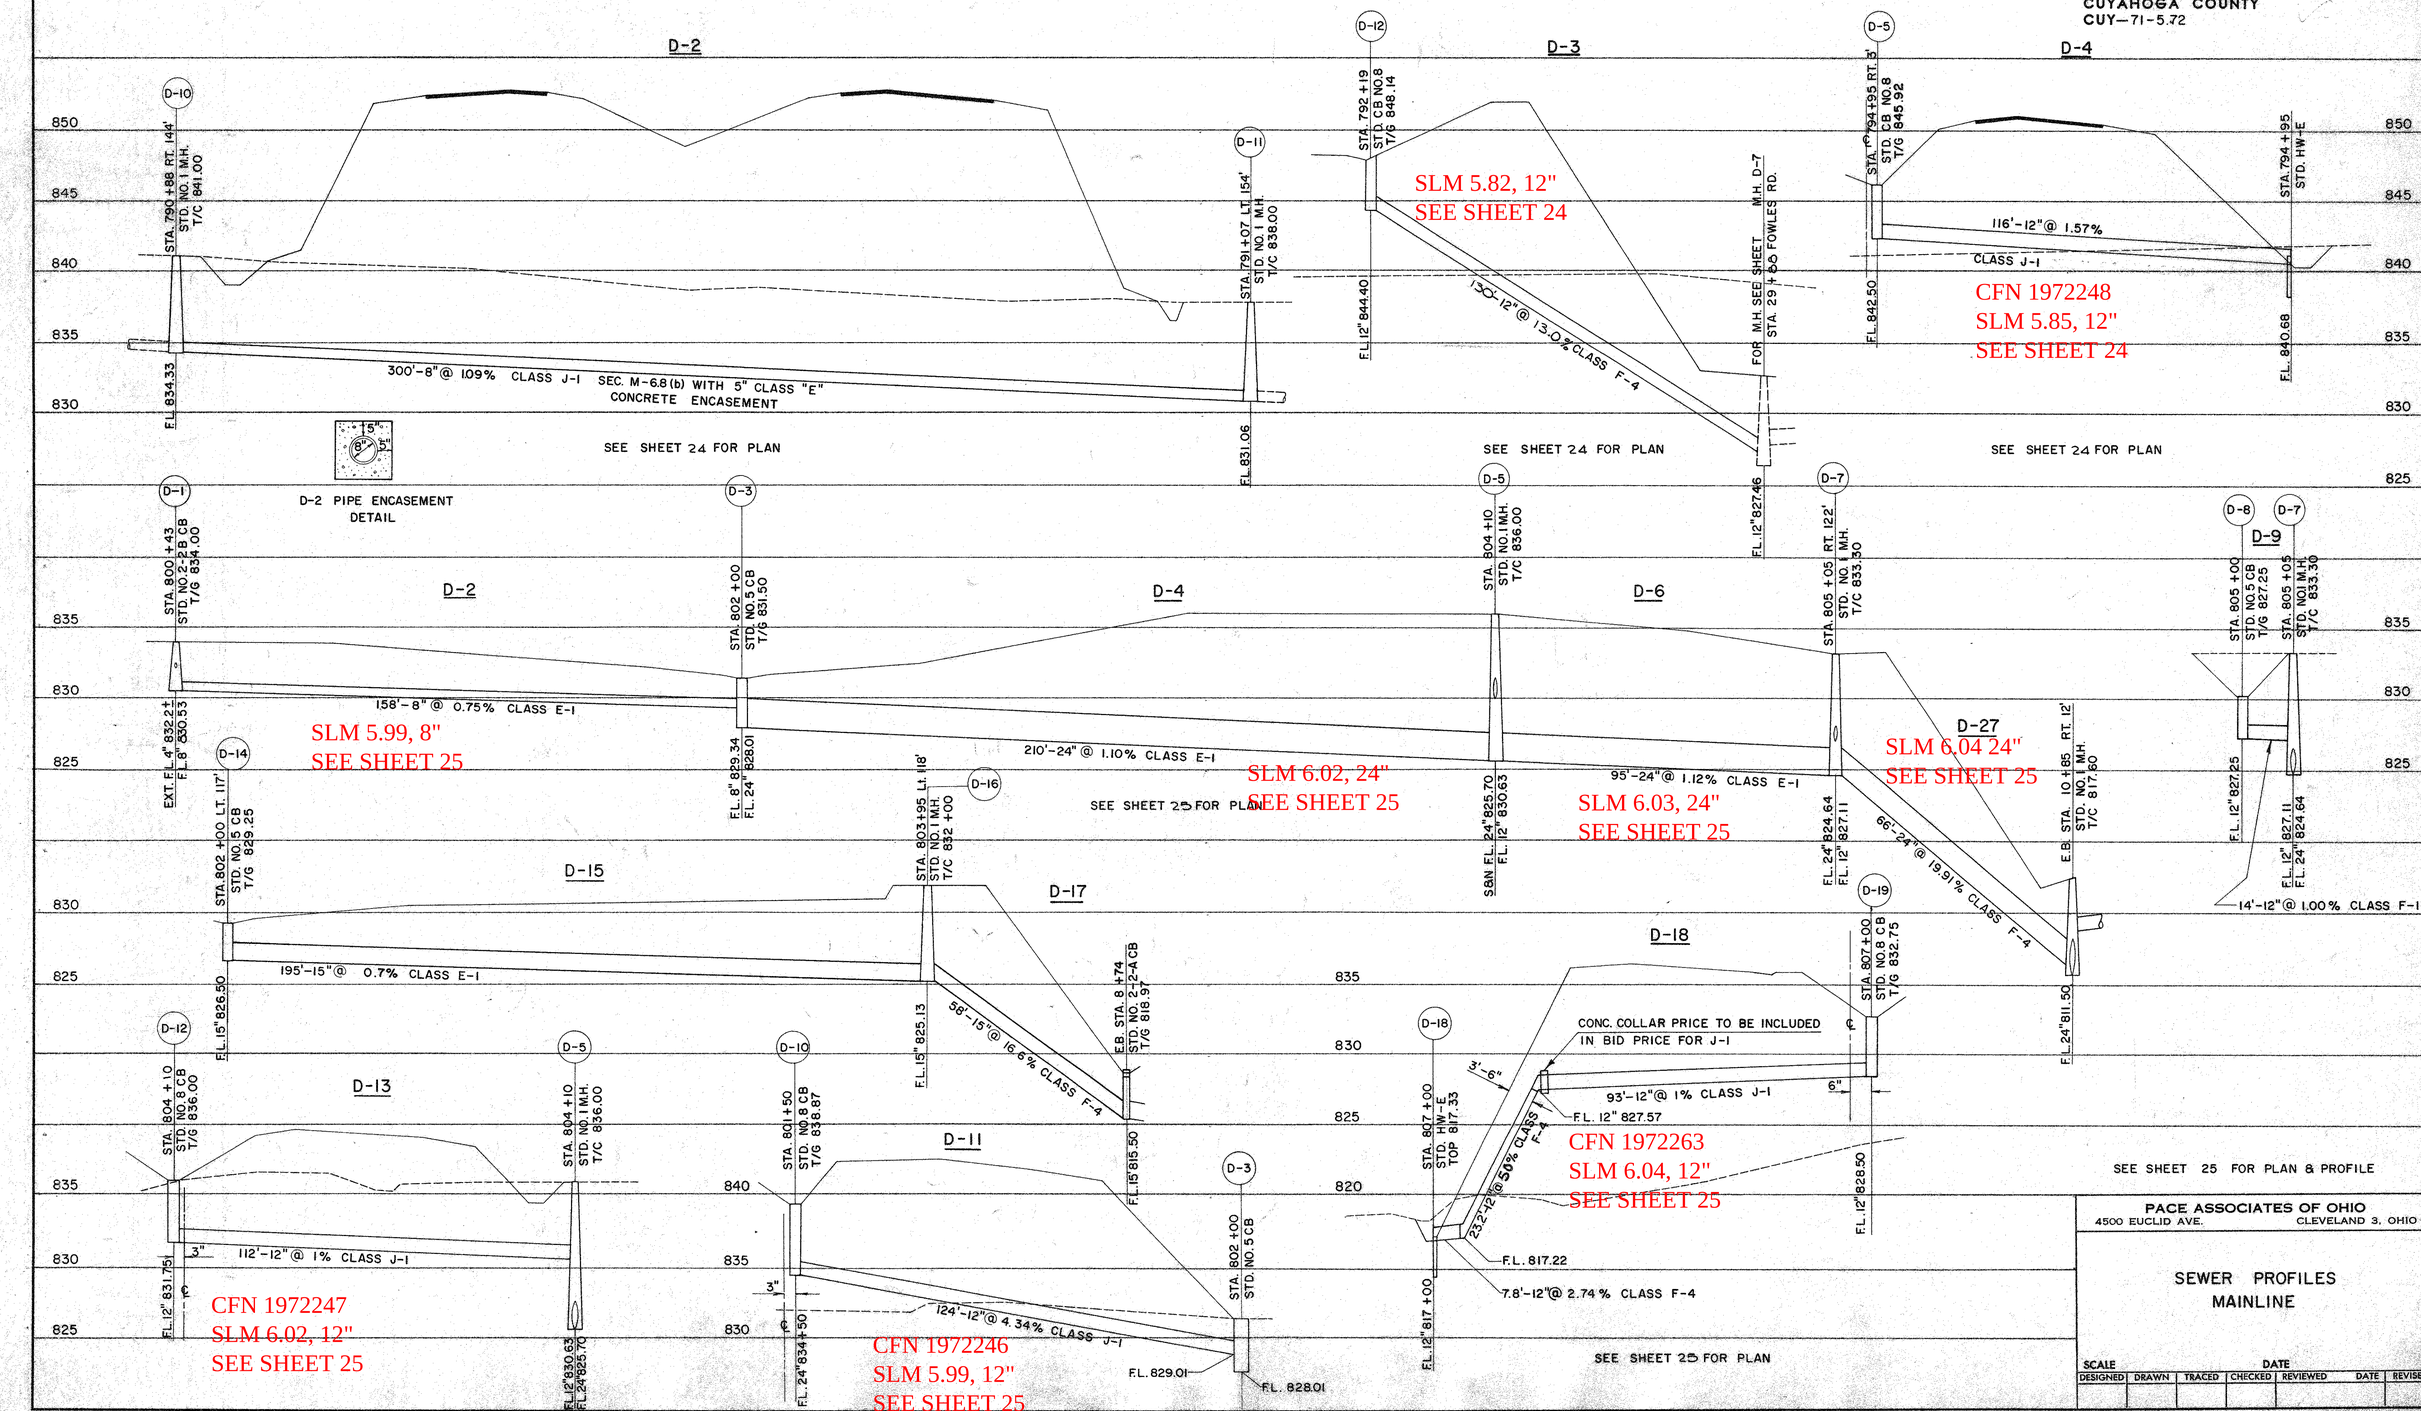
CUYAHOGA COUNTY
CUY—71-5.72