FED. RD. DIVISION	STATE	PROJECT	
2	OHIO		

321
665

CUYAHOGA COUNTY
CUY-71-10.44
CO. RD. No. 189

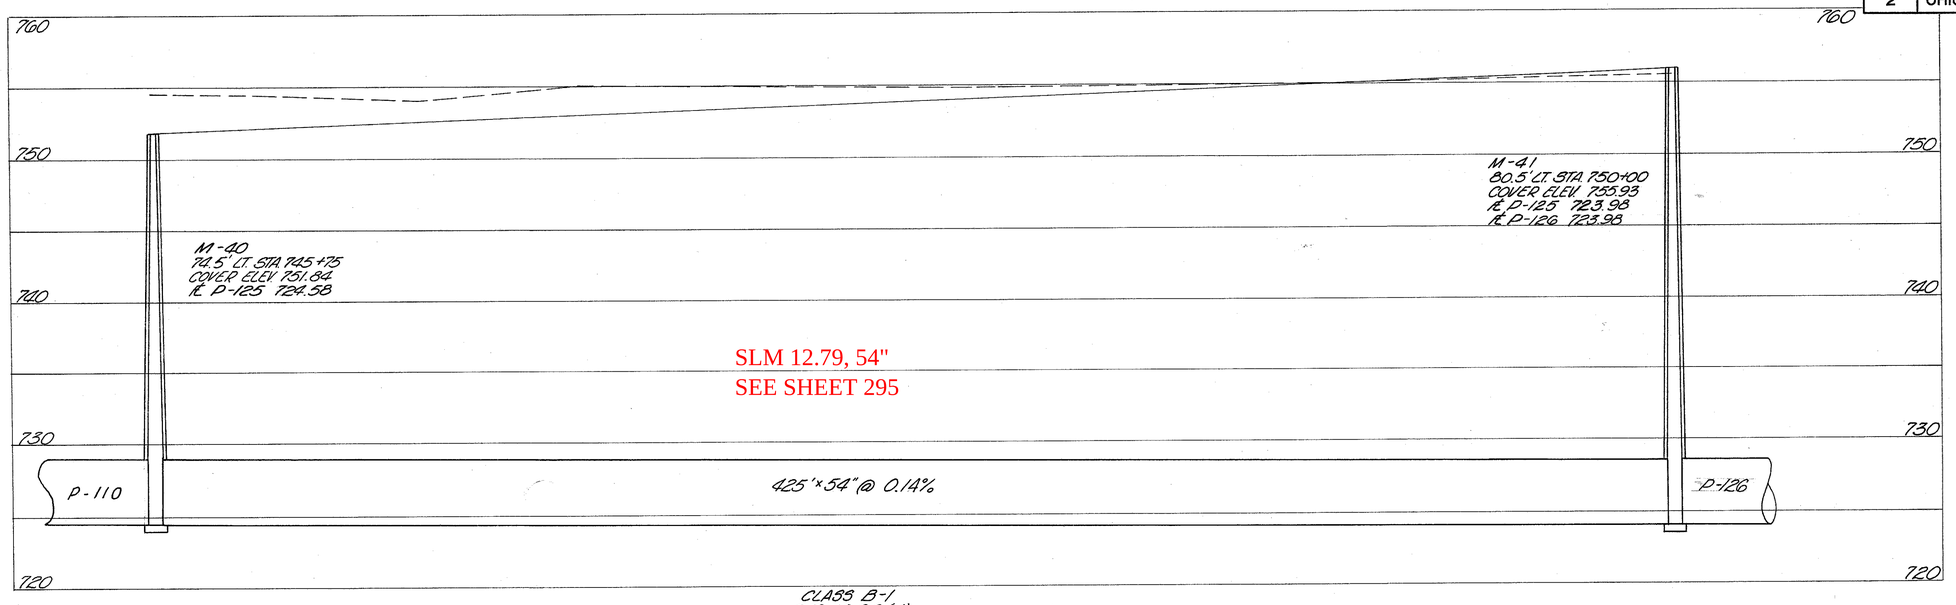

CLASS B-1
SEC. M-6.6(d)
P-125

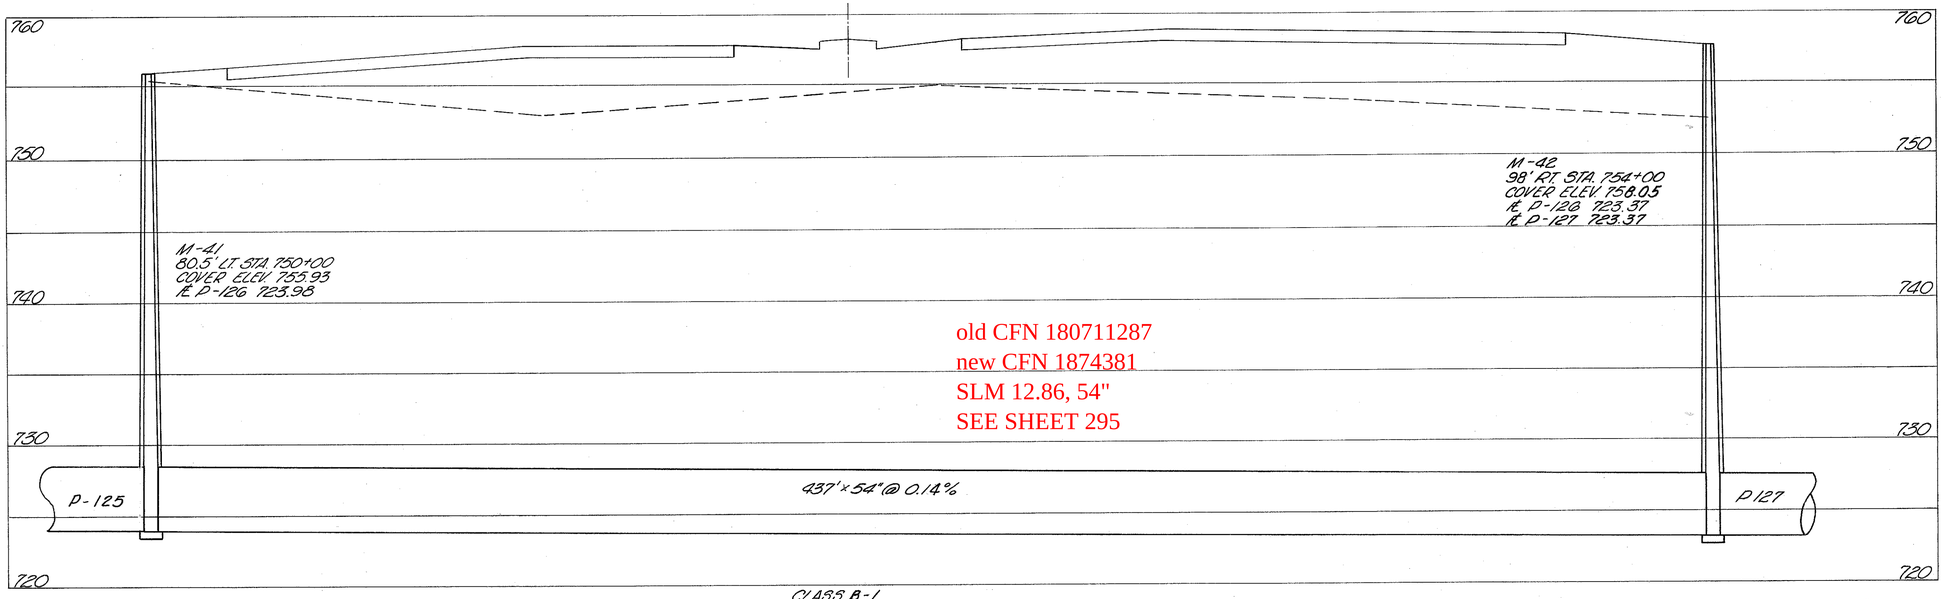

CLASS B-1
SEC. M-6.6(d)
P-126

FOR DRAINAGE PLAN-
SEE SHEET NO. 295.

ESTIMATED QUANTITIES

PIPE REFERENCE	STRUCTURES INCLUDED		I-1 CLASS B-1 SEC. M-6.6(d) 54" L.F.		I-8 STD. N°2 M.H. EA.		SEE SHEET NO.
P-125	M-40		425		1		
P-126	M-41		437		1		
			862		2		

DESCRIPTION	PLOTTED BY	DATE	INKED BY	DATE	CHECKED BY	DATE
TOPOGRAPHY						
PAVEMENT						
DRAINAGE						
R. O. W.						
QUANTITIES						

DRAINAGE PROFILES P-125 & P-126