
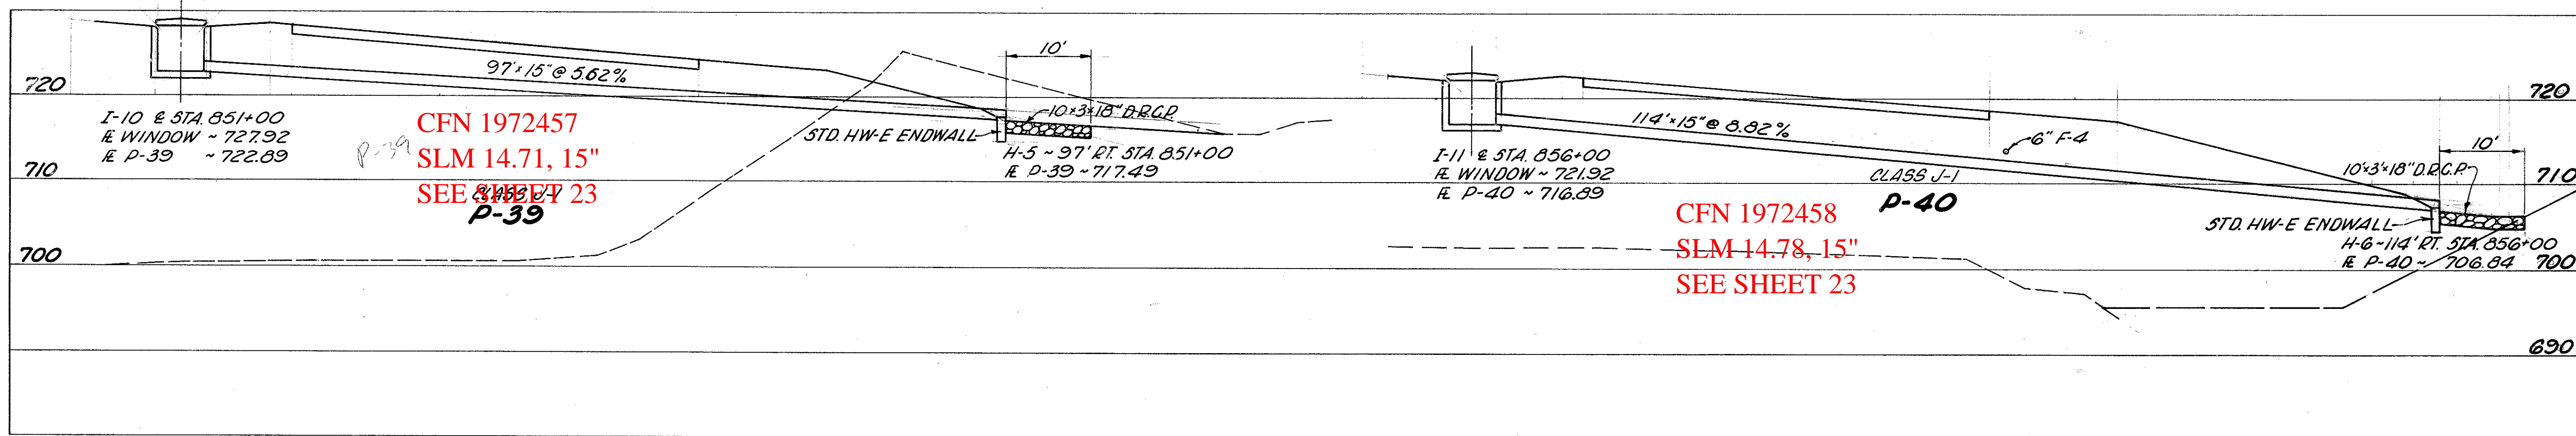


CUYAHOGA COUNTY
CUY-71-13.68

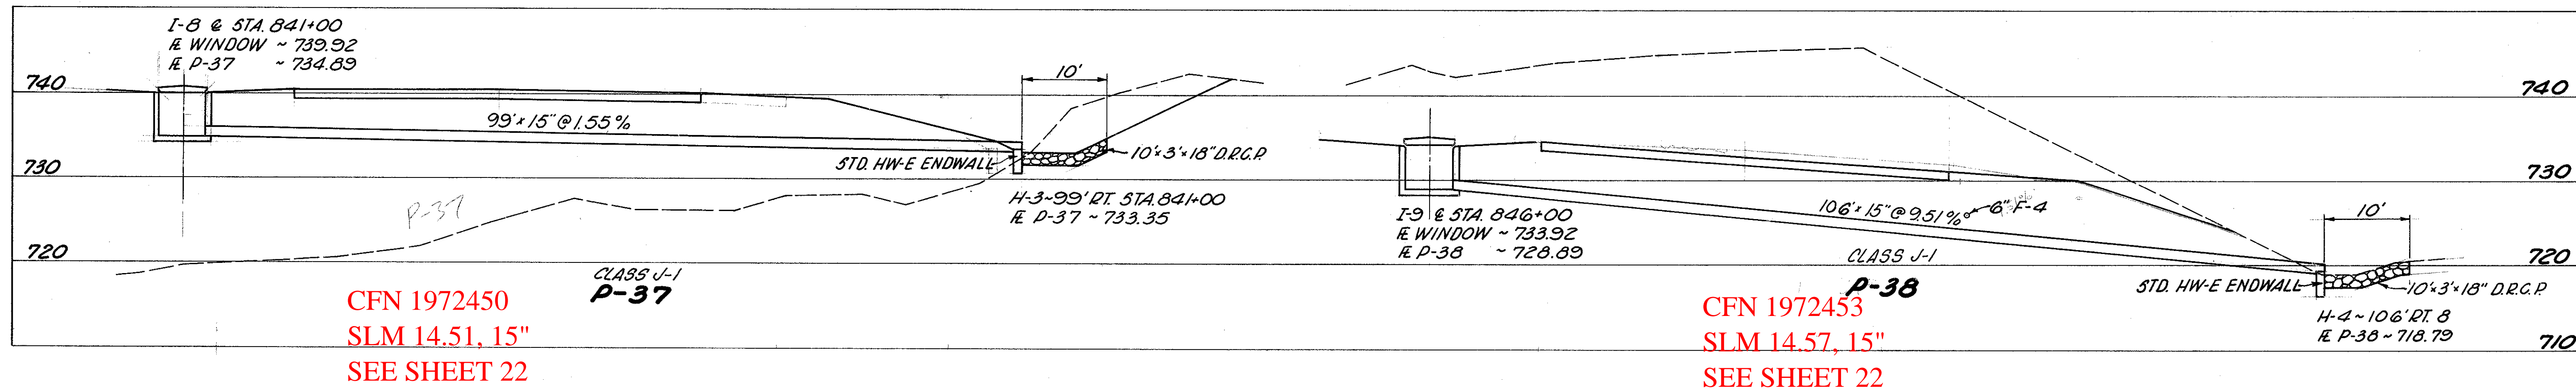

ESTIMATED QUANTITIES

PIPE REFERENCE	STRUCTURES INCLUDED	I-1	I-2	I-8		I-10	SEE SHEET NO.
		CLASS J-1 15"	MASONRY	SPECIAL INLET 2-8	SPECIAL INLET 2-10	DUMPED ROCK CHANNEL PROT. CULVDS.	
		LIN. FT.	CY. YDS.	EACH			
P-37	I-8, H-3	99	0.26	1		2	
P-38	I-9, H-4	106	0.26		1	2	
P-39	I-10, H-5	97	0.26		1	2	
P-40	I-11, H-6	114	0.26		1	2	
TOTALS		416	1.04	1	3	8	

CHECKED BY: _____ DATE: _____
 PLOTTED BY: _____ DATE: _____
 DESCRIPTION: _____
 TOPOGRAPHY: _____
 DRAWING: _____
 QUANTITY: _____