


FED. RD. DIVISION	STATE	PROJECT
2	OHIO	

114  
241

18  
28

CUYAHOGA COUNTY  
CUY-71-17.18

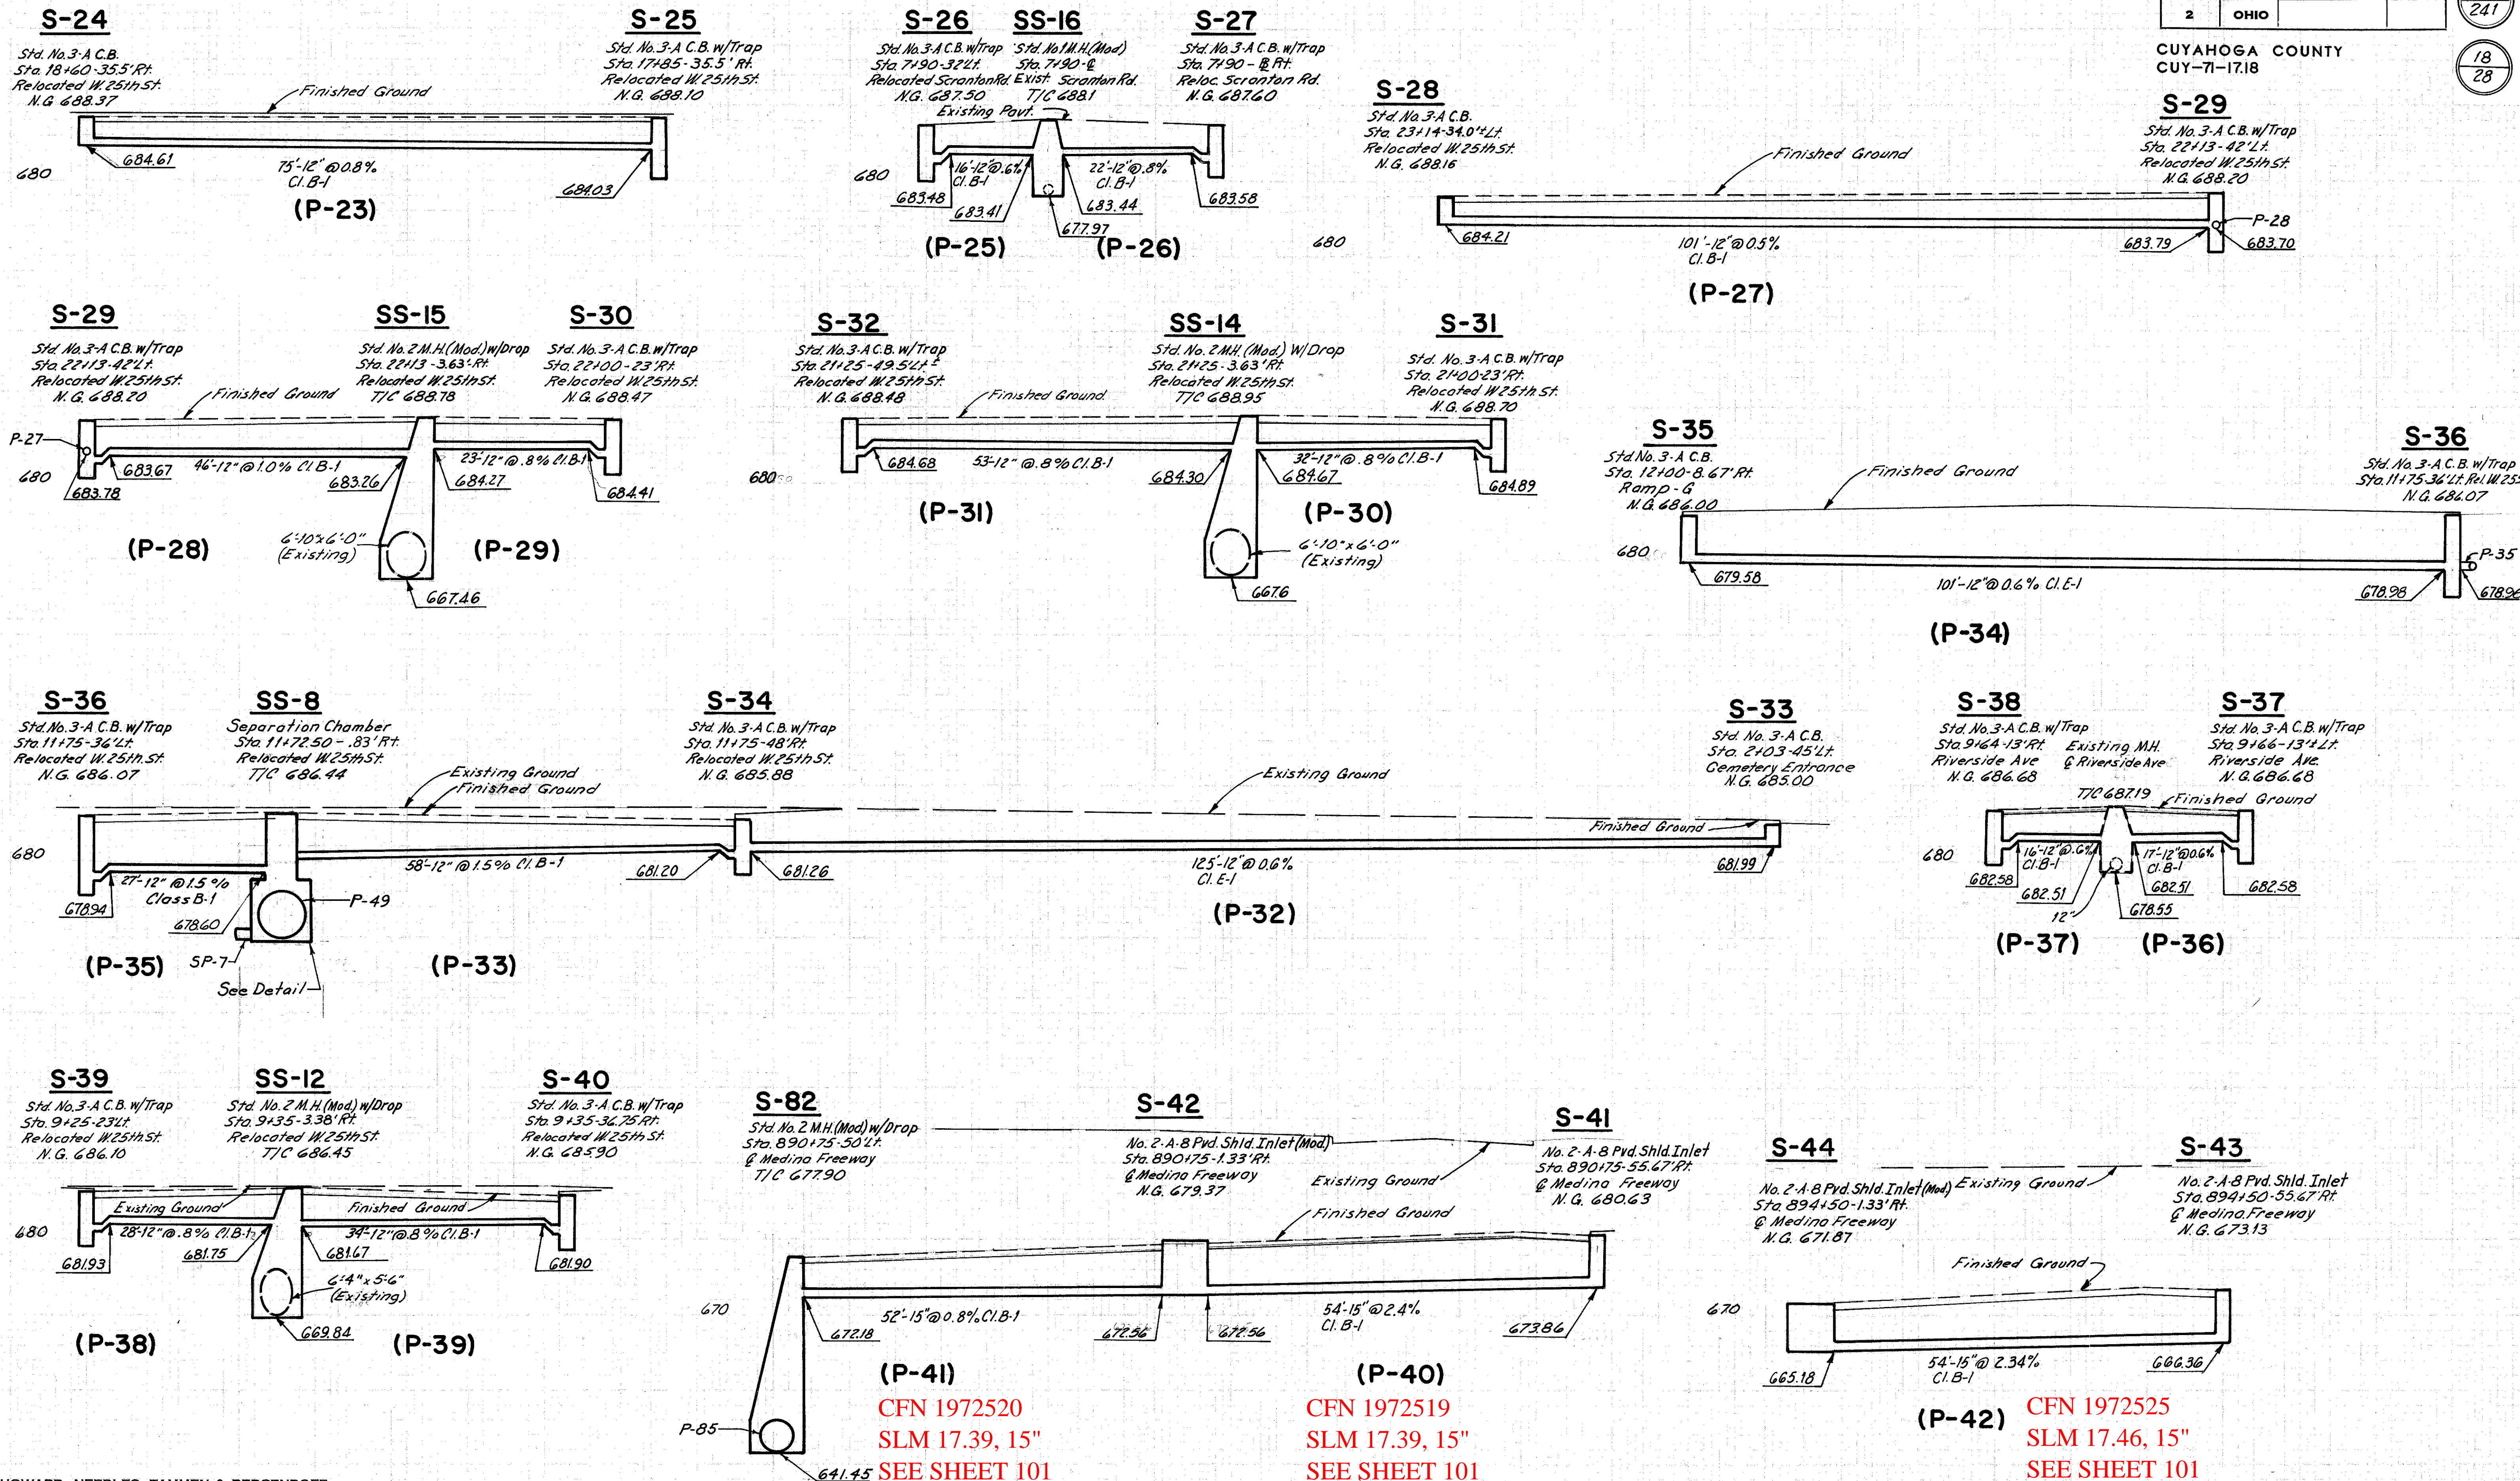

(P-41)  
CFN 1972520  
SLM 17.39, 15"  
SEE SHEET 101

(P-40)  
CFN 1972519  
SLM 17.39, 15"  
SEE SHEET 101

(P-42)  
CFN 1972525  
SLM 17.46, 15"  
SEE SHEET 101