FED. RD. DIVISION	STATE	PROJECT	
2	OHIO		

286/646

35/54

CUYAHOGA COUNTY
CUY-71-17.83
CUY-176-12.76

R.D.J. 9-23-64
J.Ma. 10-12-64

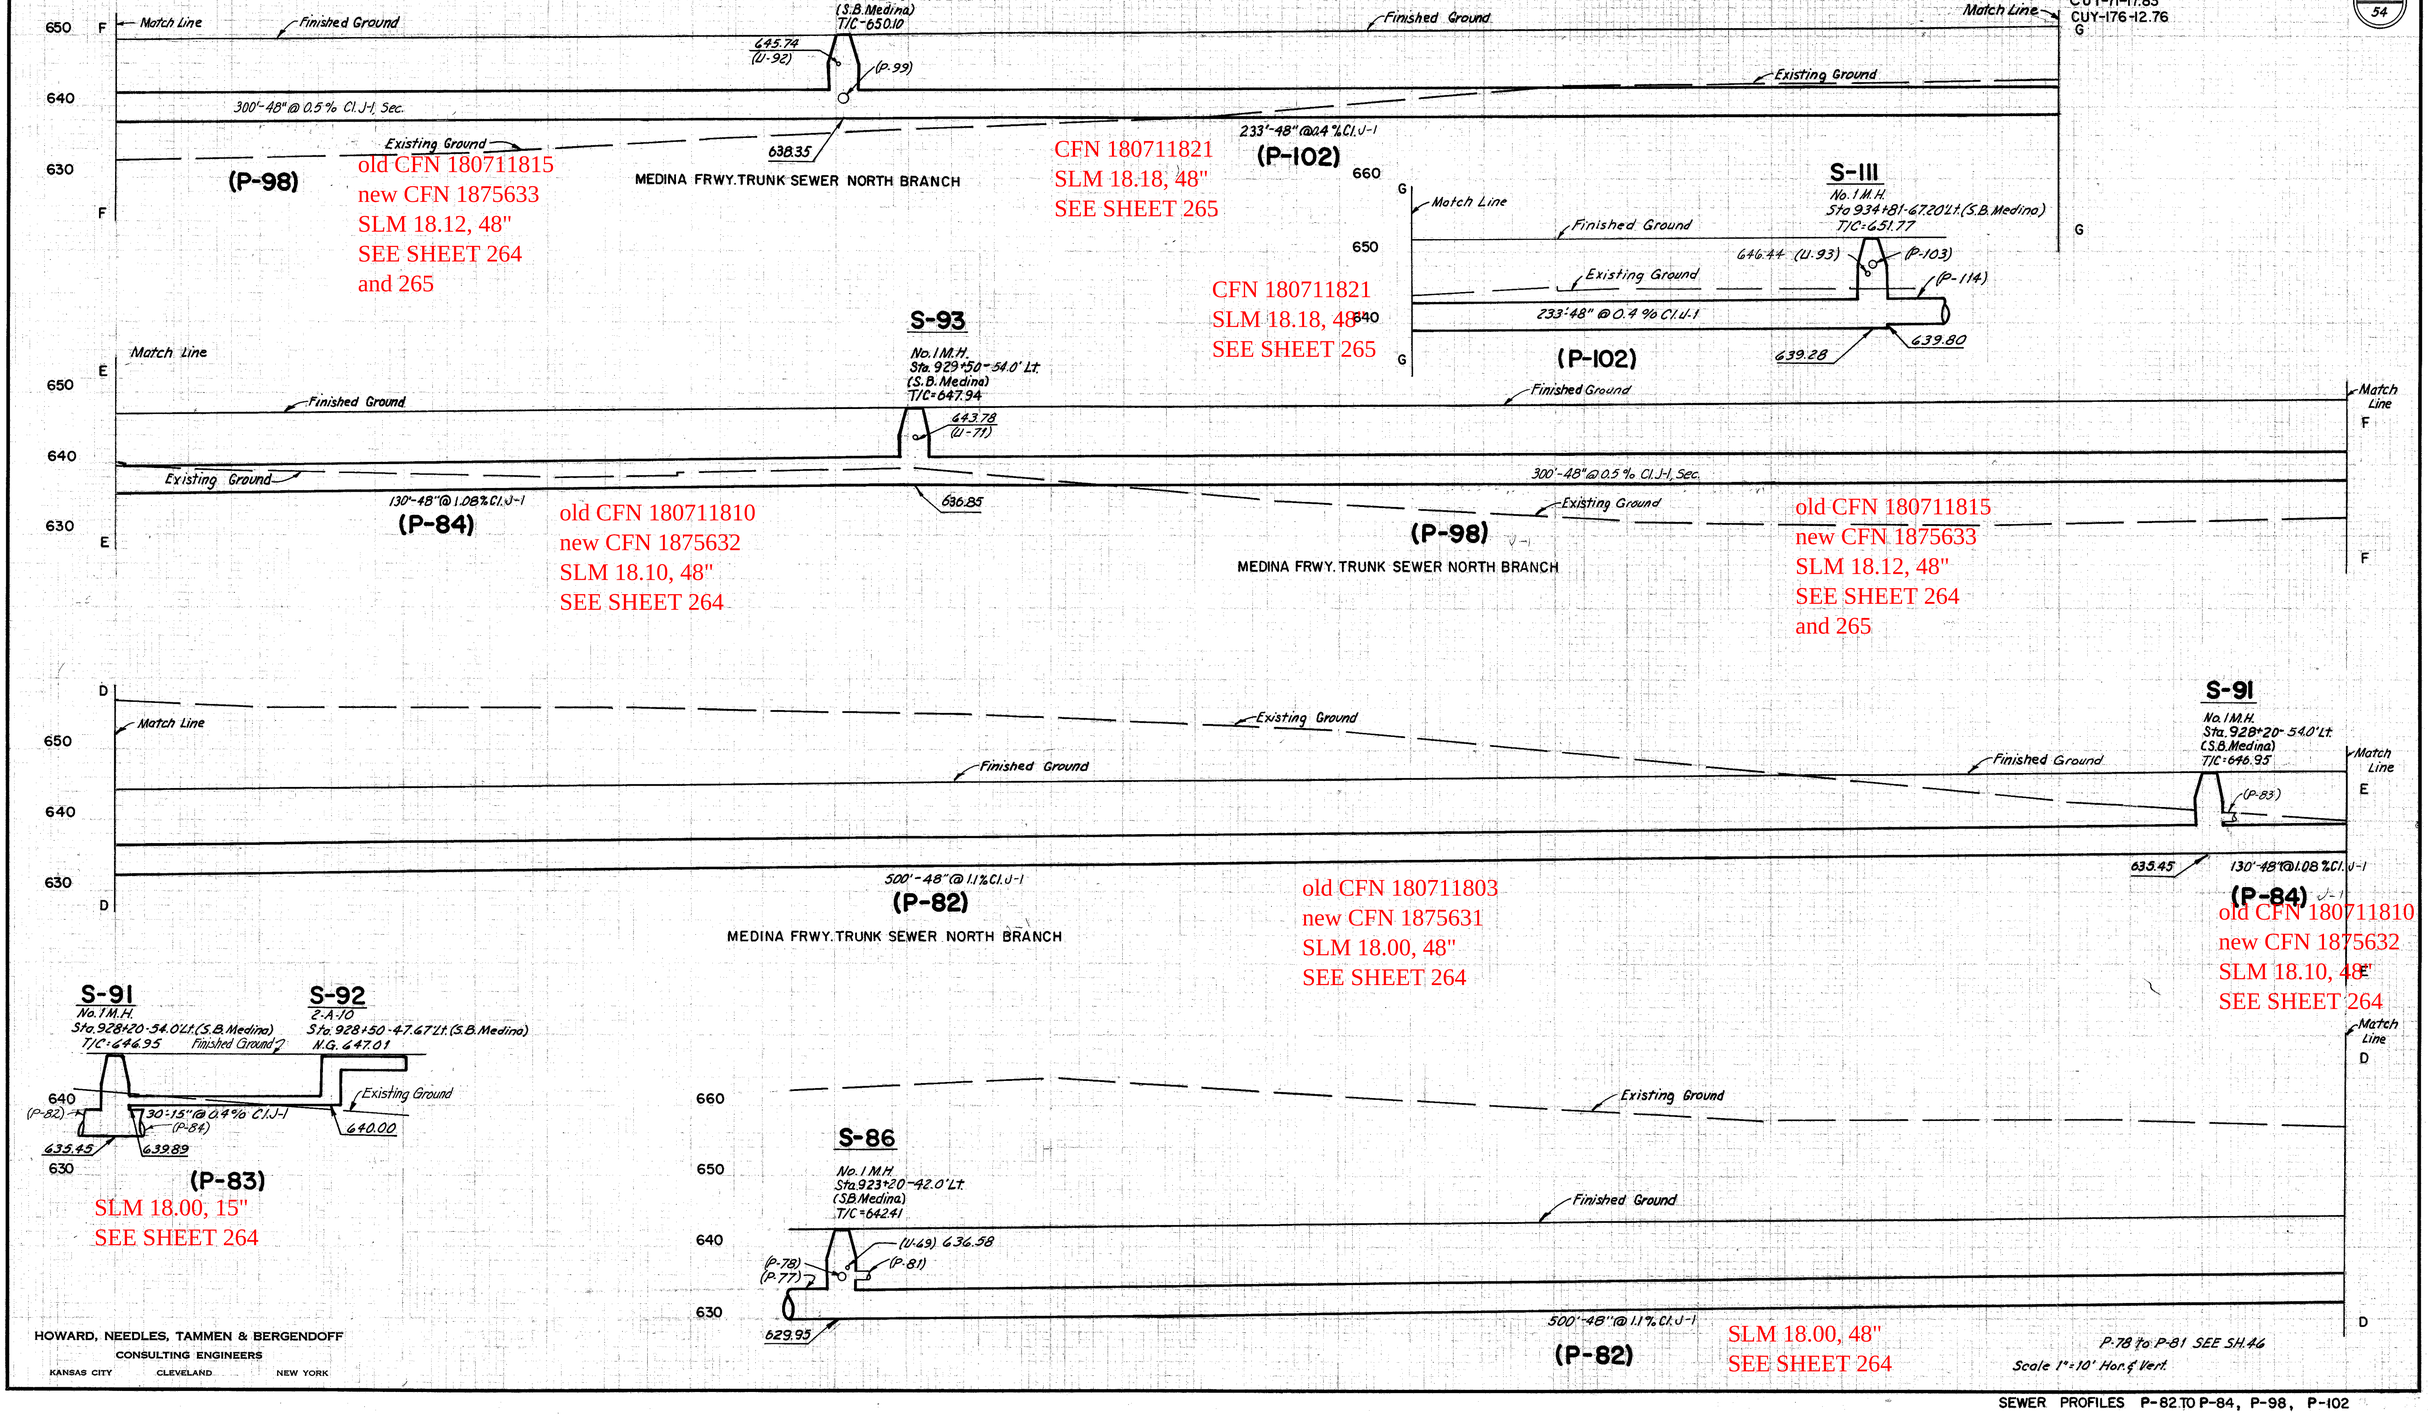

HOWARD, NEEDLES, TAMMEN & BERGENDOFF
CONSULTING ENGINEERS
KANSAS CITY CLEVELAND NEW YORK

SEWER PROFILES P-82 TO P-84, P-98, P-102