

SLM 7.22, 15"  
SEE SHEET 460


SLM 7.29, 15"  
SEE BELOW

SLM 7.29, 15"  
SEE SHEET 461

old CFN 180770730  
new CFN 1840151  
SLM 7.30, 108"  
SEE SHEET 462


SLM 7.22, 15"  
SEE BELOW

SLM 7.29, 18"  
SEE SHEET 461

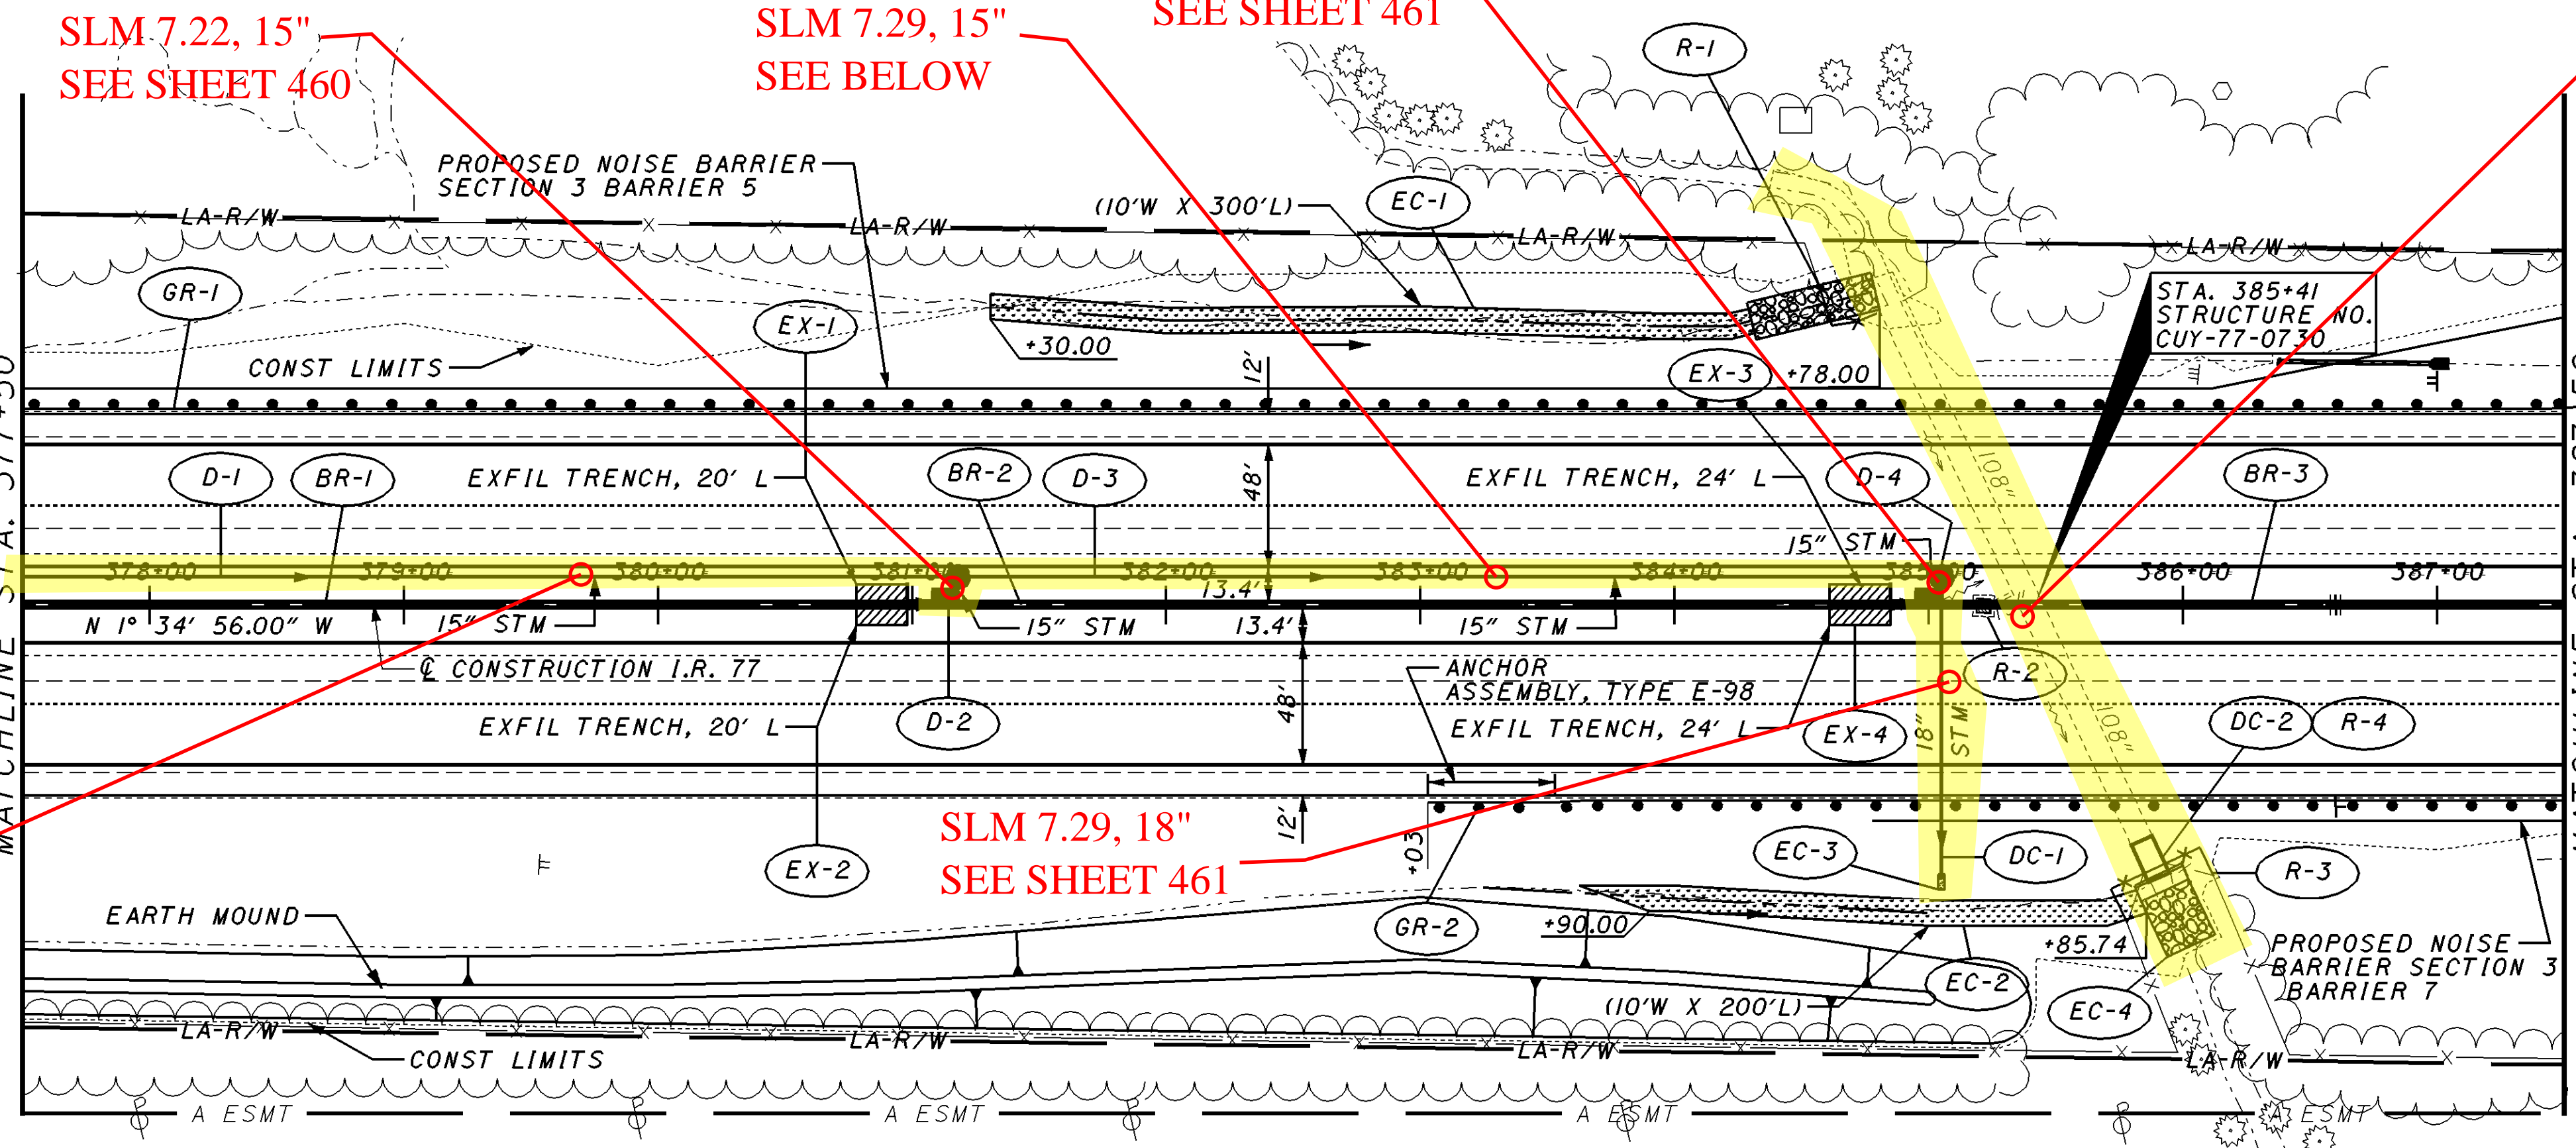


SEE 1977 CUY-77-6.35 PLANS  
FOR THE ORIGINAL CONSTRUCTION  
OF CULVERTS AND STORM SEWERS

SOUTH BOUND PROFILE

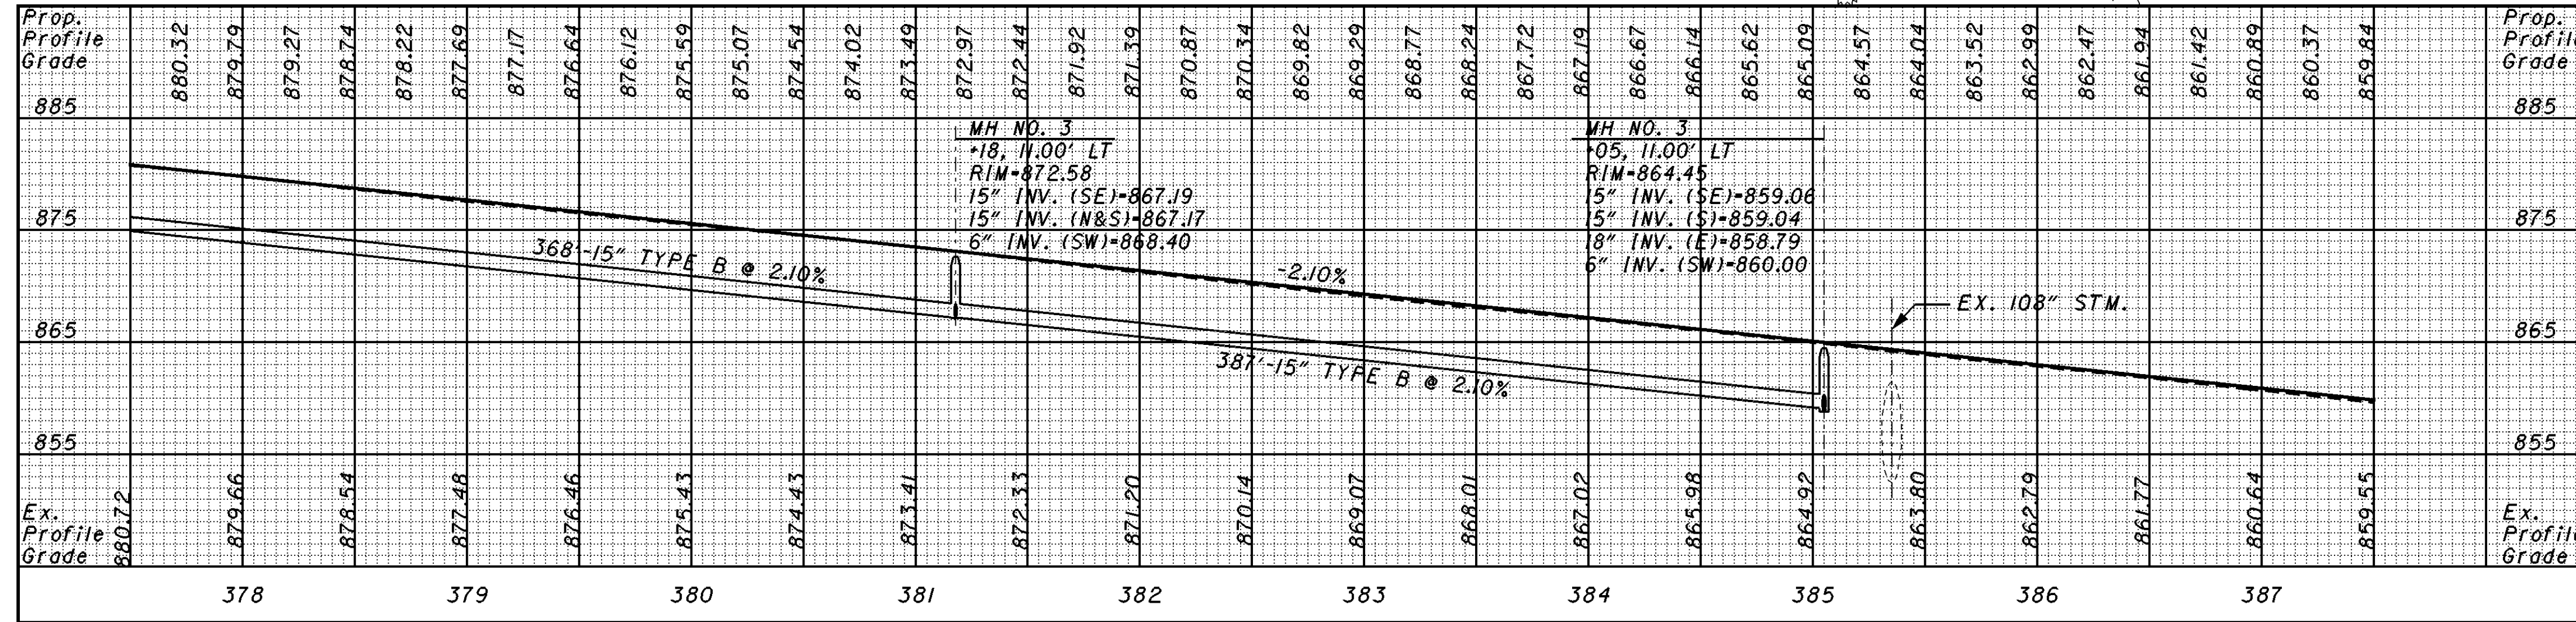

NORTH BOUND PROFILE

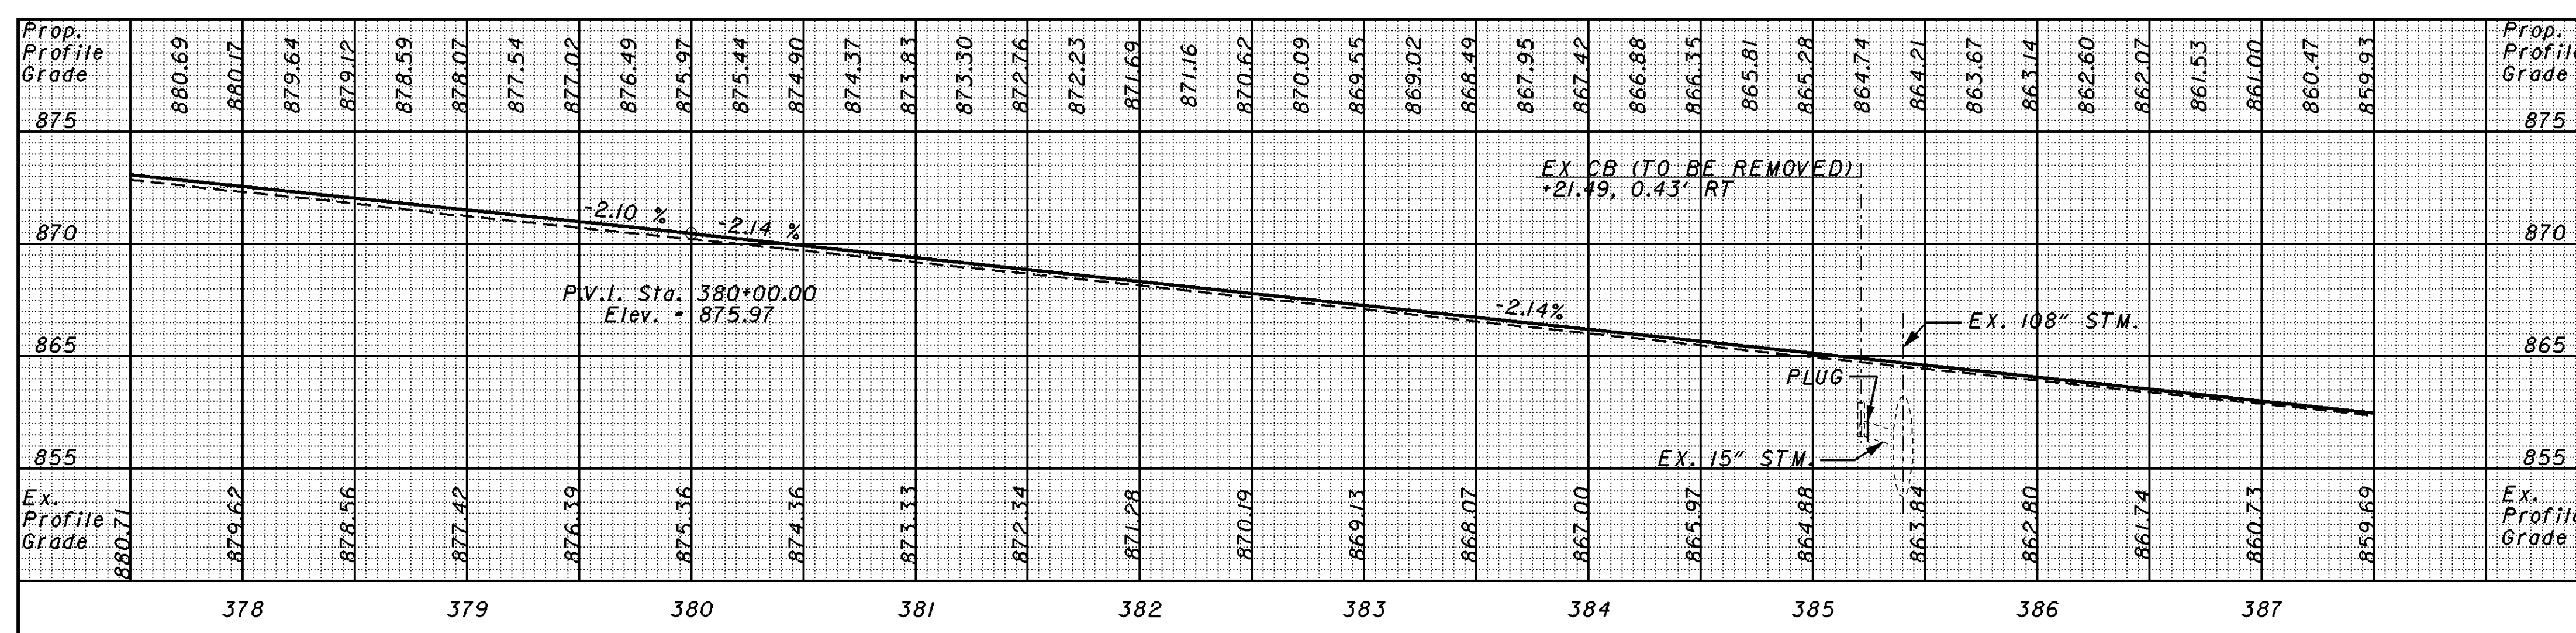

FOR REFERENCE TIES SEE SHEET 7  
FOR GEOMETRIC LAYOUT SEE SHEETS 8 TO 13  
FOR TYPICAL SECTIONS SEE SHEETS 14 TO 30  
FOR CROSS SECTIONS SEE SHEETS 349 TO 489  
FOR UNDERDRAIN PLAN SEE SHEETS 643 TO 658  
FOR CALCULATIONS AND QUANTITIES SEE SHEETS 223 TO 285  
FOR MAINTENANCE OF TRAFFIC PLANS SEE SHEETS 43 TO 217  
FOR SIGNING AND PAVEMENT MARKING PLANS SEE SHEETS 735 TO 768  
FOR LANDSCAPING PLANS SEE SHEETS 946 TO 949  
FOR NOISE BARRIER PLANS SEE SHEETS 985 TO 1010

**LEGEND**

- ROCK CHANNEL PROTECTION
- DITCH EROSION PROTECTION

**PLAN AND PROFILE**

**STA. 377+50.00 TO STA. 387+50.00**

**CUY-77-1.89**

337  
1386

I:\PROJECTS\PI\22222\dgn\TSC\_2008-03-10\22222-0337.dgn 11-MAR-2008 8:51AM ekenzig