


CUYAHOGA COUNTY
 Sec. CUY-42R-18.81
 CUY-322-(1.08-1.39)

old CFN 180901713
 new CFN 1882311
 SLM 17.12, 36"
 SEE BELOW


old CFN 180901737
 new CFN 1882324
 SLM 17.35, 42"
 SEE BELOW

Item No	Station	MONUMENT BOX ASSEMBLY TYPE	
		A	B
I-M	26+00	1	
TOTAL		1	

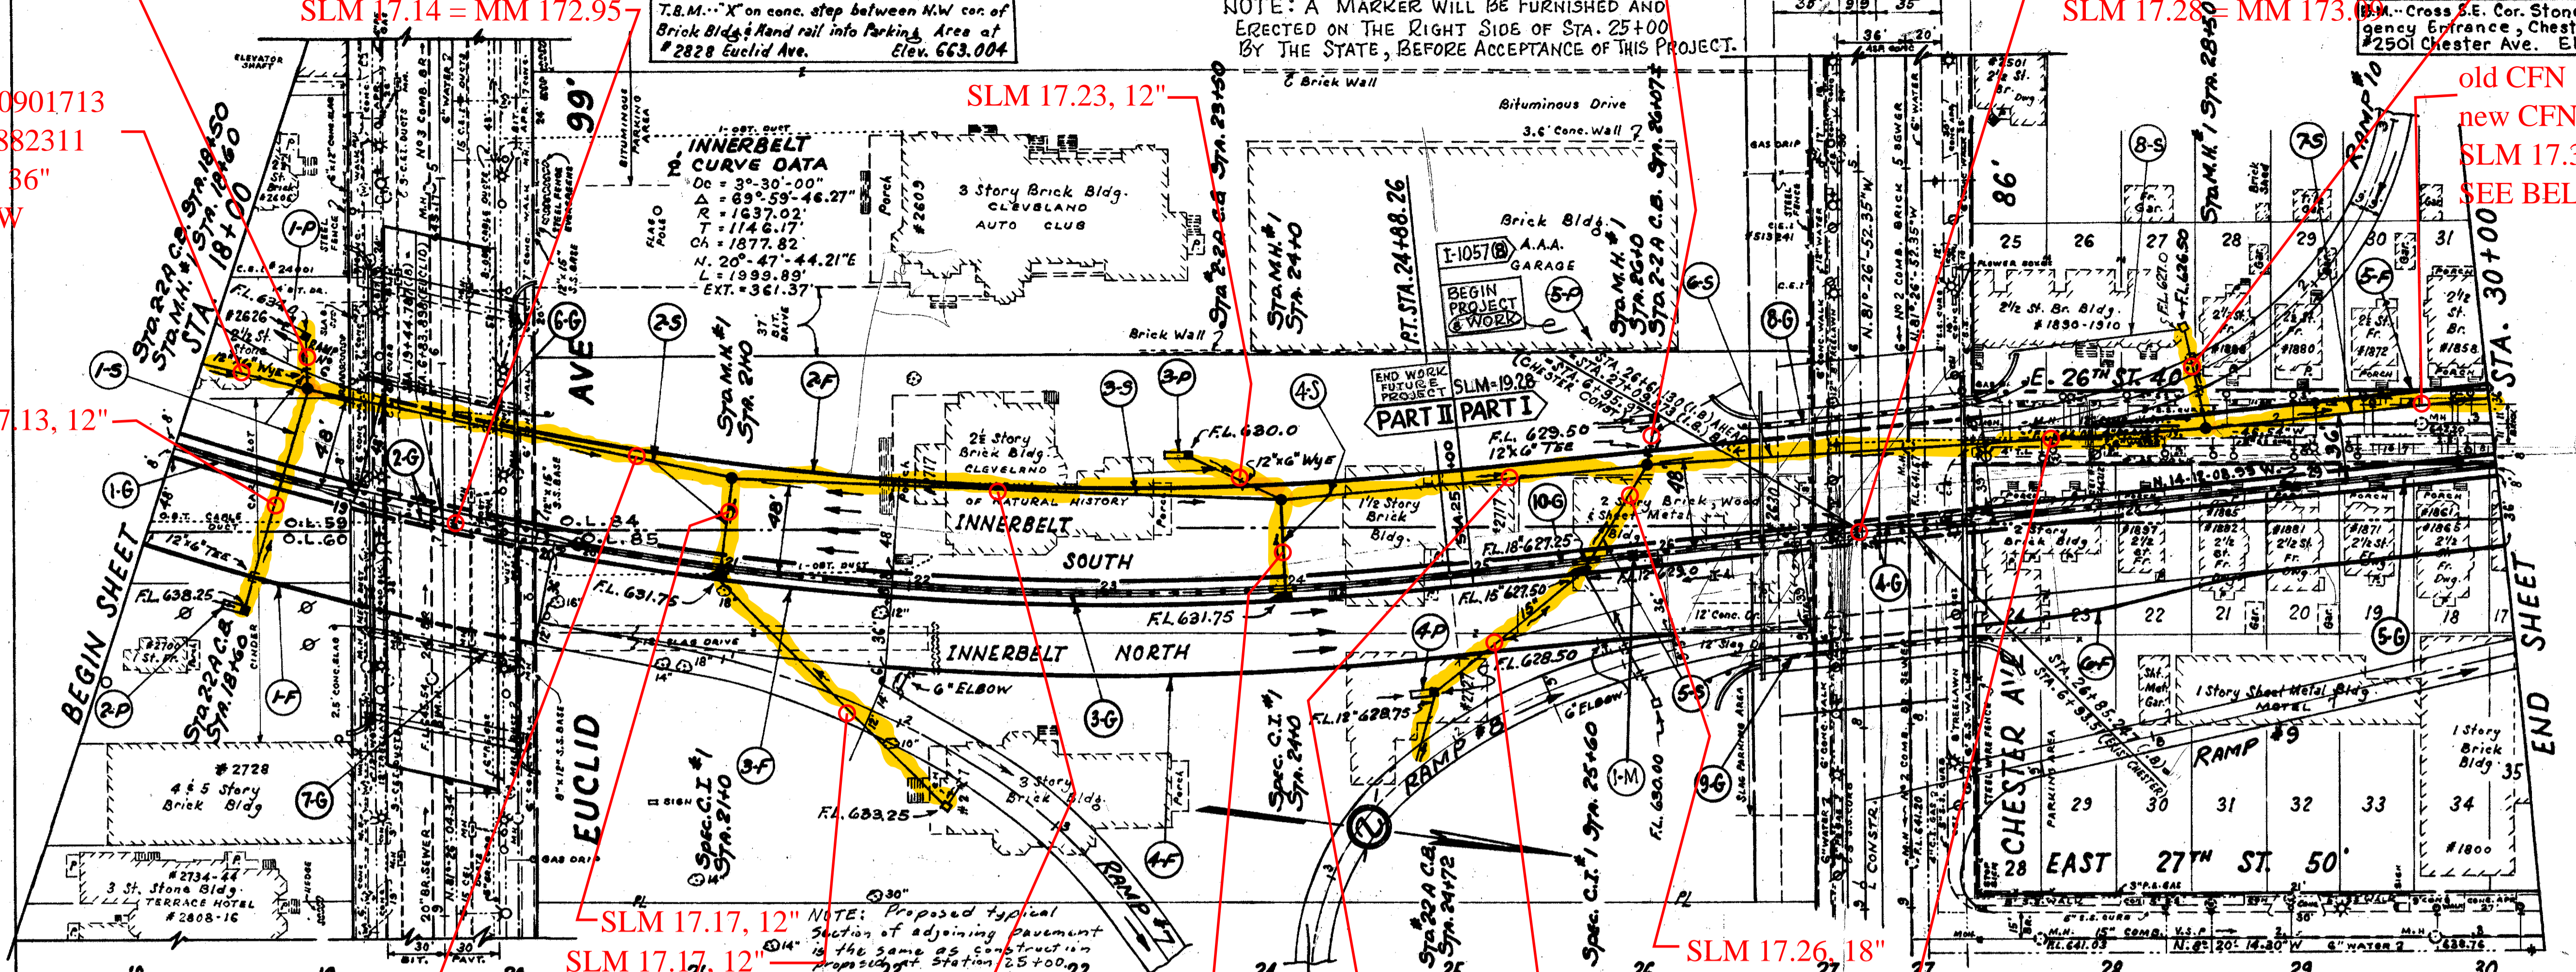

SLM 17.13, 12"

NOTE: Proposed typical section of adjoining pavement is the same as construction throughout station 25+00.23

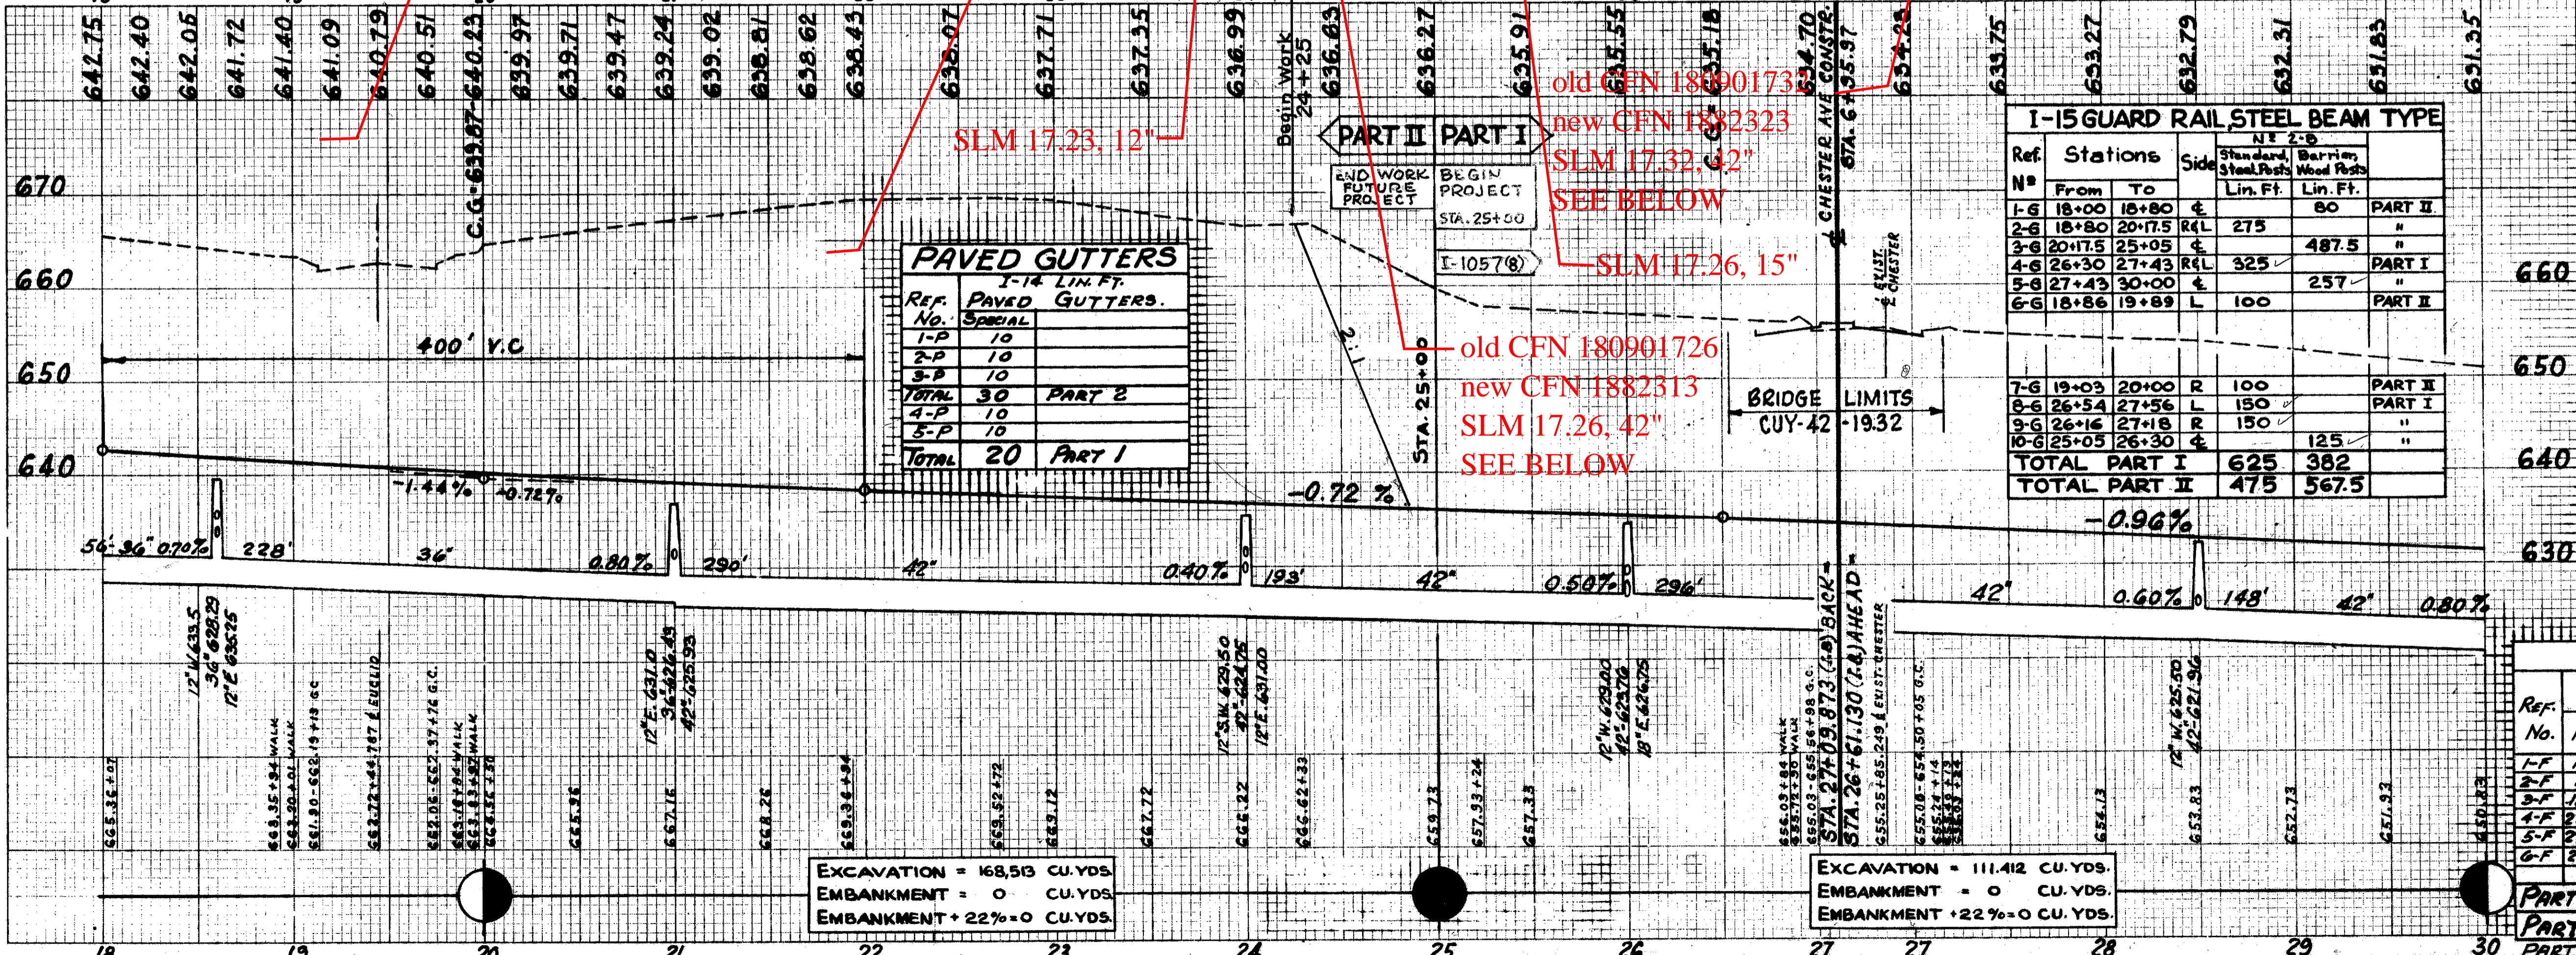

REF. NO.	PAVED GUTTERS	1-14 LIN. FT.
1-P	10	
2-P	10	
3-P	10	
TOTAL	30	PART 2
4-P	10	
5-P	10	
TOTAL	20	PART 1

Ref. No.	Stations	Side	I-15 GUARD RAIL, STEEL BEAM TYPE	
			Standard Steel Posts Lin. Ft.	Barrier Wood Posts Lin. Ft.
6-G	18+86 to 19+89	L	100	
7-G	19+03 to 20+00	R	100	
8-G	26+54 to 27+56	L	150	
9-G	26+16 to 27+18	R	150	
10-G	25+05 to 26+30	R		125
TOTAL PART I			625	382
TOTAL PART II			475	567.5


REF. NO.	STATION	FROM	TO	SIDE	6" UNDERDRAINS	
					I-4 LIN. FT.	I-5 EACH
1-F	18+00	20+10	RT.	210		
2-F	19+00	27+30	LT.	856		
3-F	18+00	26+50	RT.		840	
4-F	22+00	26+60	RT.	364	2	
5-F	27+50	30+00	LT.	20	150	
6-F	26+75	30+00	RT.	374		
PART 2-TOTALS				1093	796	
PART 1-TOTALS				20	50	

 EMBANKMENT = 0 CU. YDS.
 EMBANKMENT + 22% = 0 CU. YDS.

 EMBANKMENT = 0 CU. YDS.
 EMBANKMENT + 22% = 0 CU. YDS.

PLAN & PROFILE: INNERBELT STA. 18+00 to STA. 30+00