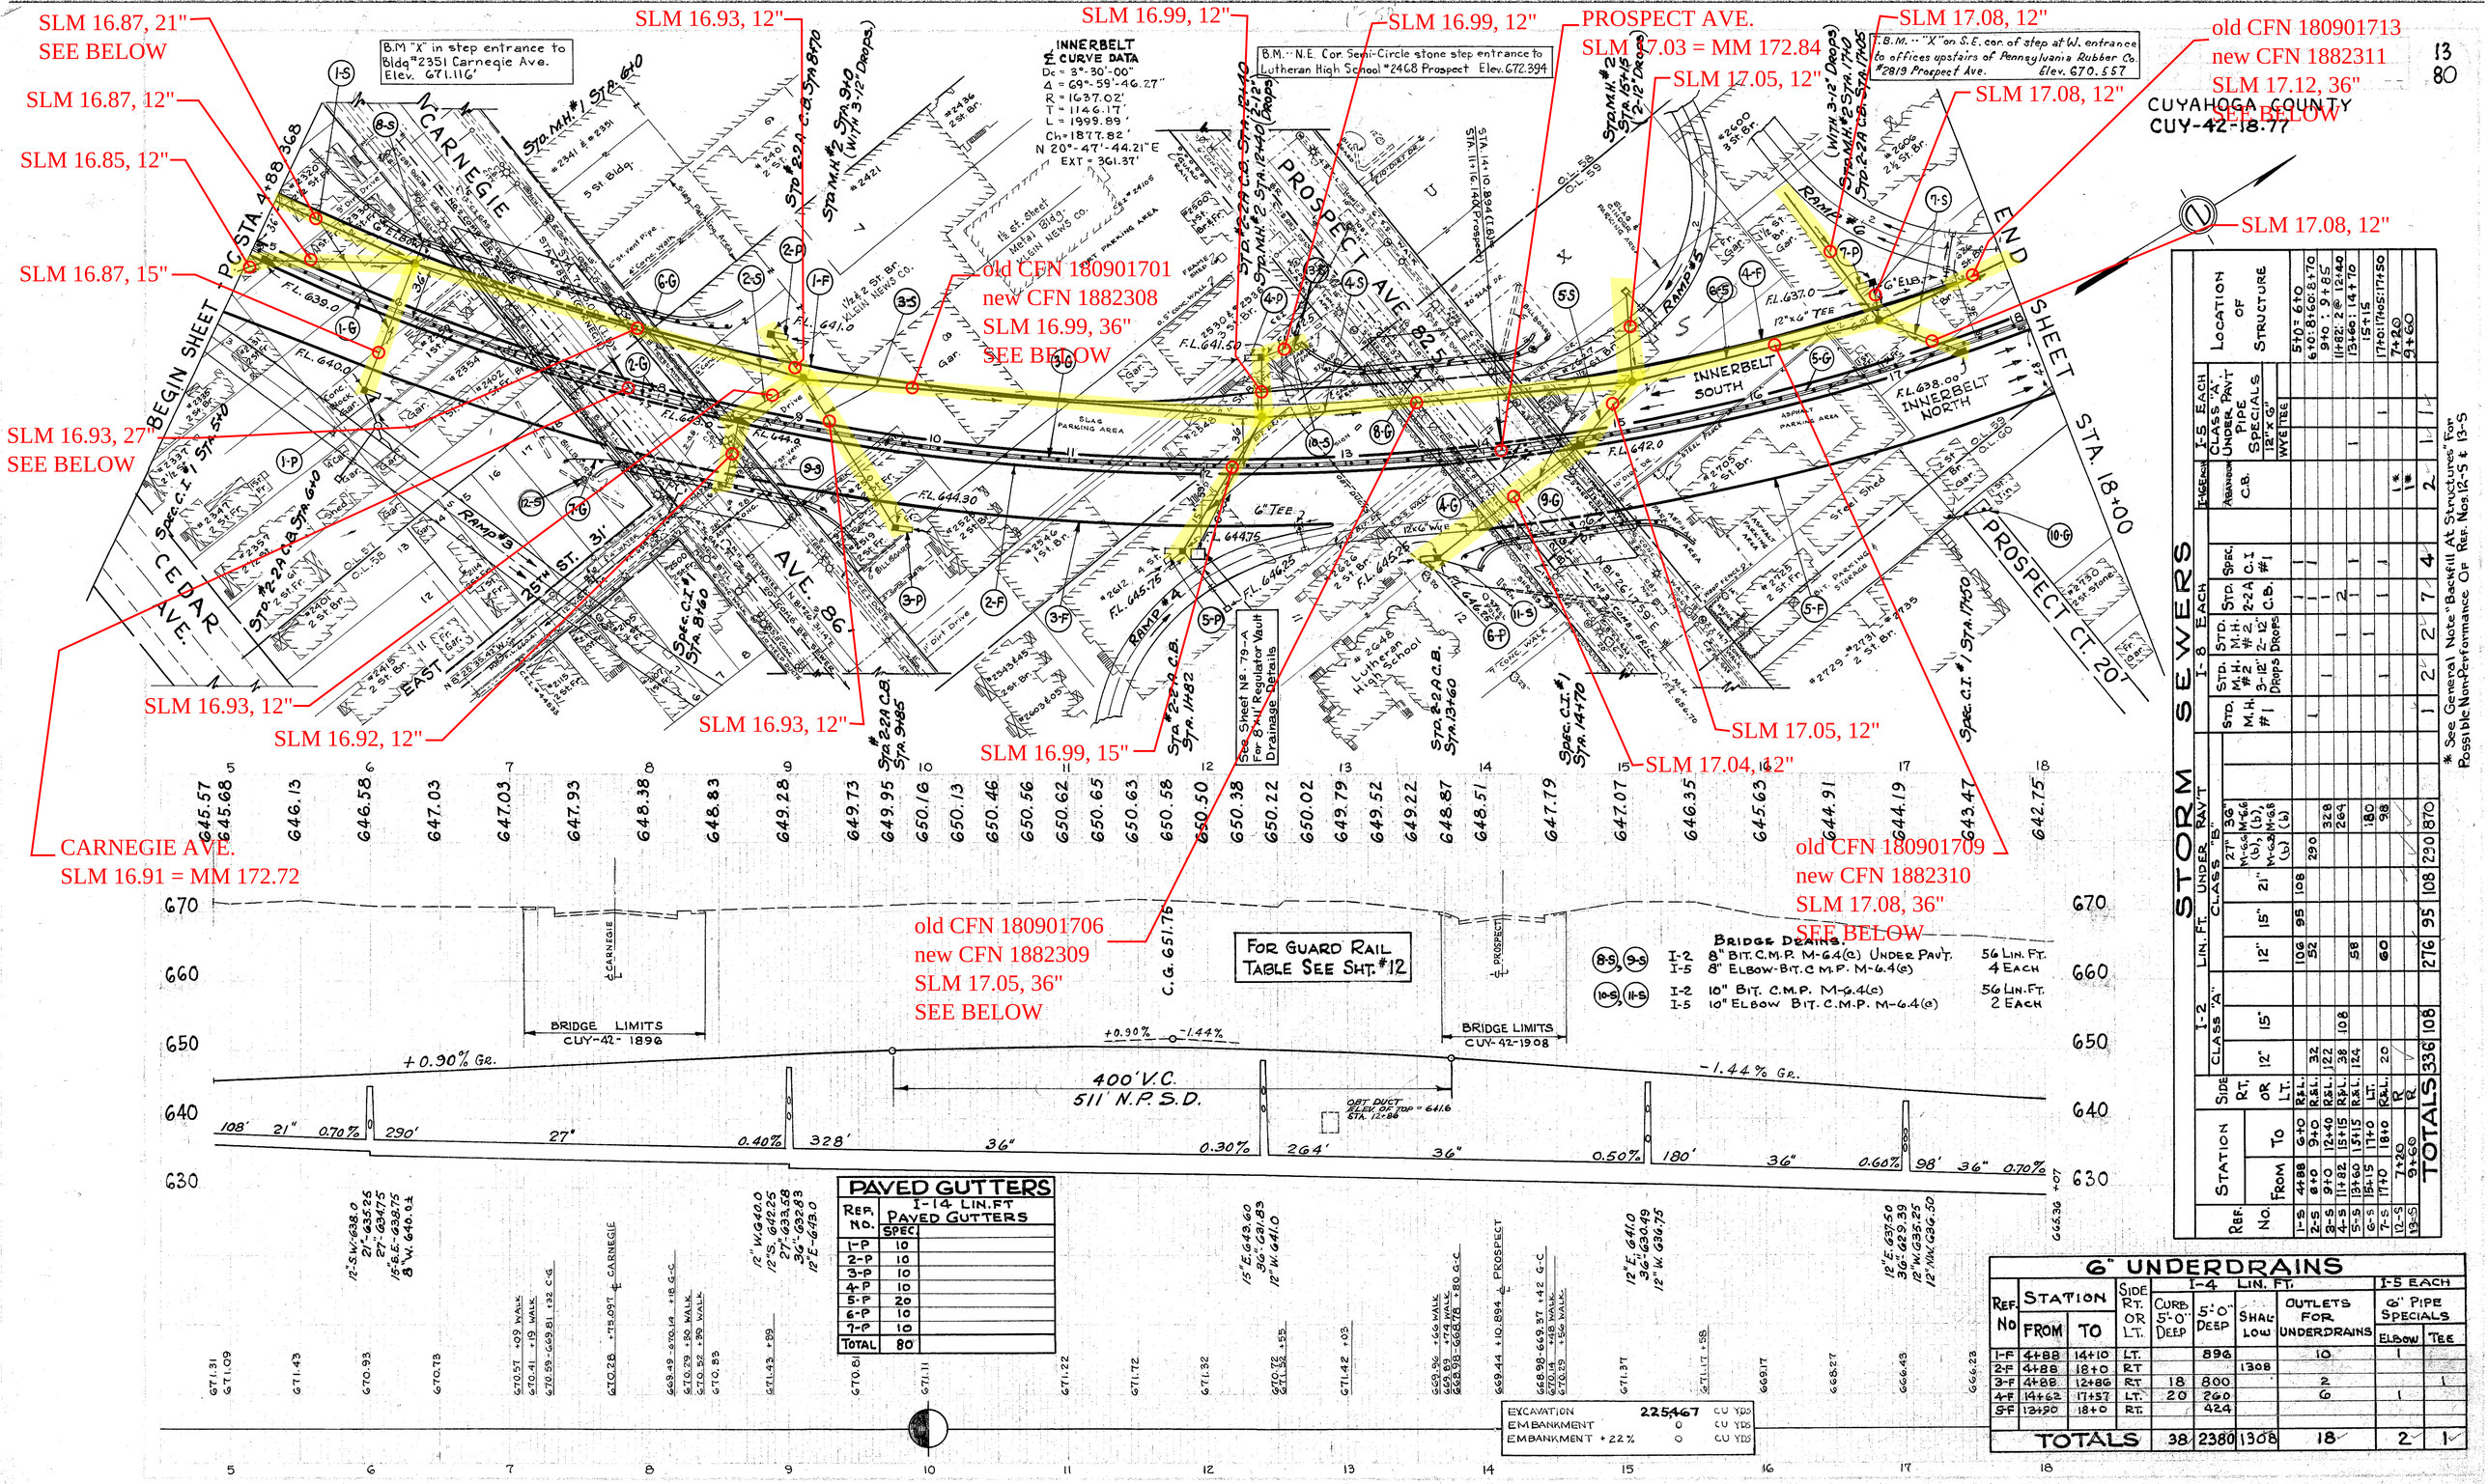

13
80

STORM SEWERS

Ref. No.	Station From	Station To	Side Rt. or Lt.	I-2 Class "A" 12"	I-2 Class "A" 15"	I-2 Class "B" 12"	I-2 Class "B" 15"	I-2 Class "B" 21"	I-2 Class "B" 27" M-64 (b), (c)	I-2 Class "B" 36" M-64 (b), (c)	I-8 Each Std. M.H. #1	I-8 Each Std. M.H. #2 3-12" Drops	I-8 Each Std. M.H. #2 2-12" Drops	I-8 Each Std. Spec. 2-2A C.B.	I-8 Each Std. Spec. C.I. #1	I-5 Each Class "A" Under Pav't Pipe Specials 12" x 6" Wye & Tee	I-5 Each Class "A" Under Pav't Pipe Specials C.B.	I-5 Each Class "A" Under Pav't Pipe Specials	Location of Structure
1-S	4+88	6+0	R.&L.			106	95	108											5+0 = 6+0
2-S	8+0	9+0	R.&L.	32		52													6+0, 8+50, 8+70
8-S	9+0	12+40	R.&L.	122					290										9+0 : 9+65
4-S	11+82	15+15	R.&L.	38	108		58			328			1	1	1				11+82 : 2 @ 12+40
5-S	13+60	13+15	R.&L.	124						264		1							13+60 : 14+70
6-S	13+15	17+0	LT.				60										1		15+15
7-S	17+0	18+0	R.&L.	20						180									17+0 : 17+05 : 17+50
12-S	7+20	9+60	R							98					1*				7+20
13-S	9+60		R												1*				9+60
TOTALS				336	108	276	95	108	290	870		2	7	4	2	1	1		

* See General Note "Backfill At Structures" For Possible Non-Performance Of Ref. Nos. 12-S & 13-S

6" UNDERDRAINS

Ref. No	Station From	Station To	Side Rt. or Lt.	I-4 Lin. Ft. Curb 5'-0" Deep	I-4 Lin. Ft. 5'-0" Deep	I-4 Lin. Ft. Shallow	I-4 Lin. Ft. Outlets for Underdrains	I-5 Each 6" Pipe Specials Elbow	I-5 Each 6" Pipe Specials Tee
1-F	4+88	14+10	LT.		896		10	1	
2-F	4+88	18+0	RT			1308			
3-F	4+88	12+86	RT	18	800		2		1
4-F	14+62	17+57	LT.	20	260		6	1	
5-F	13+90	18+0	RT.		424				
TOTALS				38	2380	1308	18	2	1

PAVED GUTTERS

Ref. No.	Spec
1-P	10
2-P	10
3-P	10
4-P	10
5-P	20
6-P	10
7-P	10
Total	80