


CUYAHOGA COUNTY  
 SEC. CUY - 525-0.00, CUY-2-28.16  
 LAKE COUNTY  
 SEC. LAK - 525-0.00

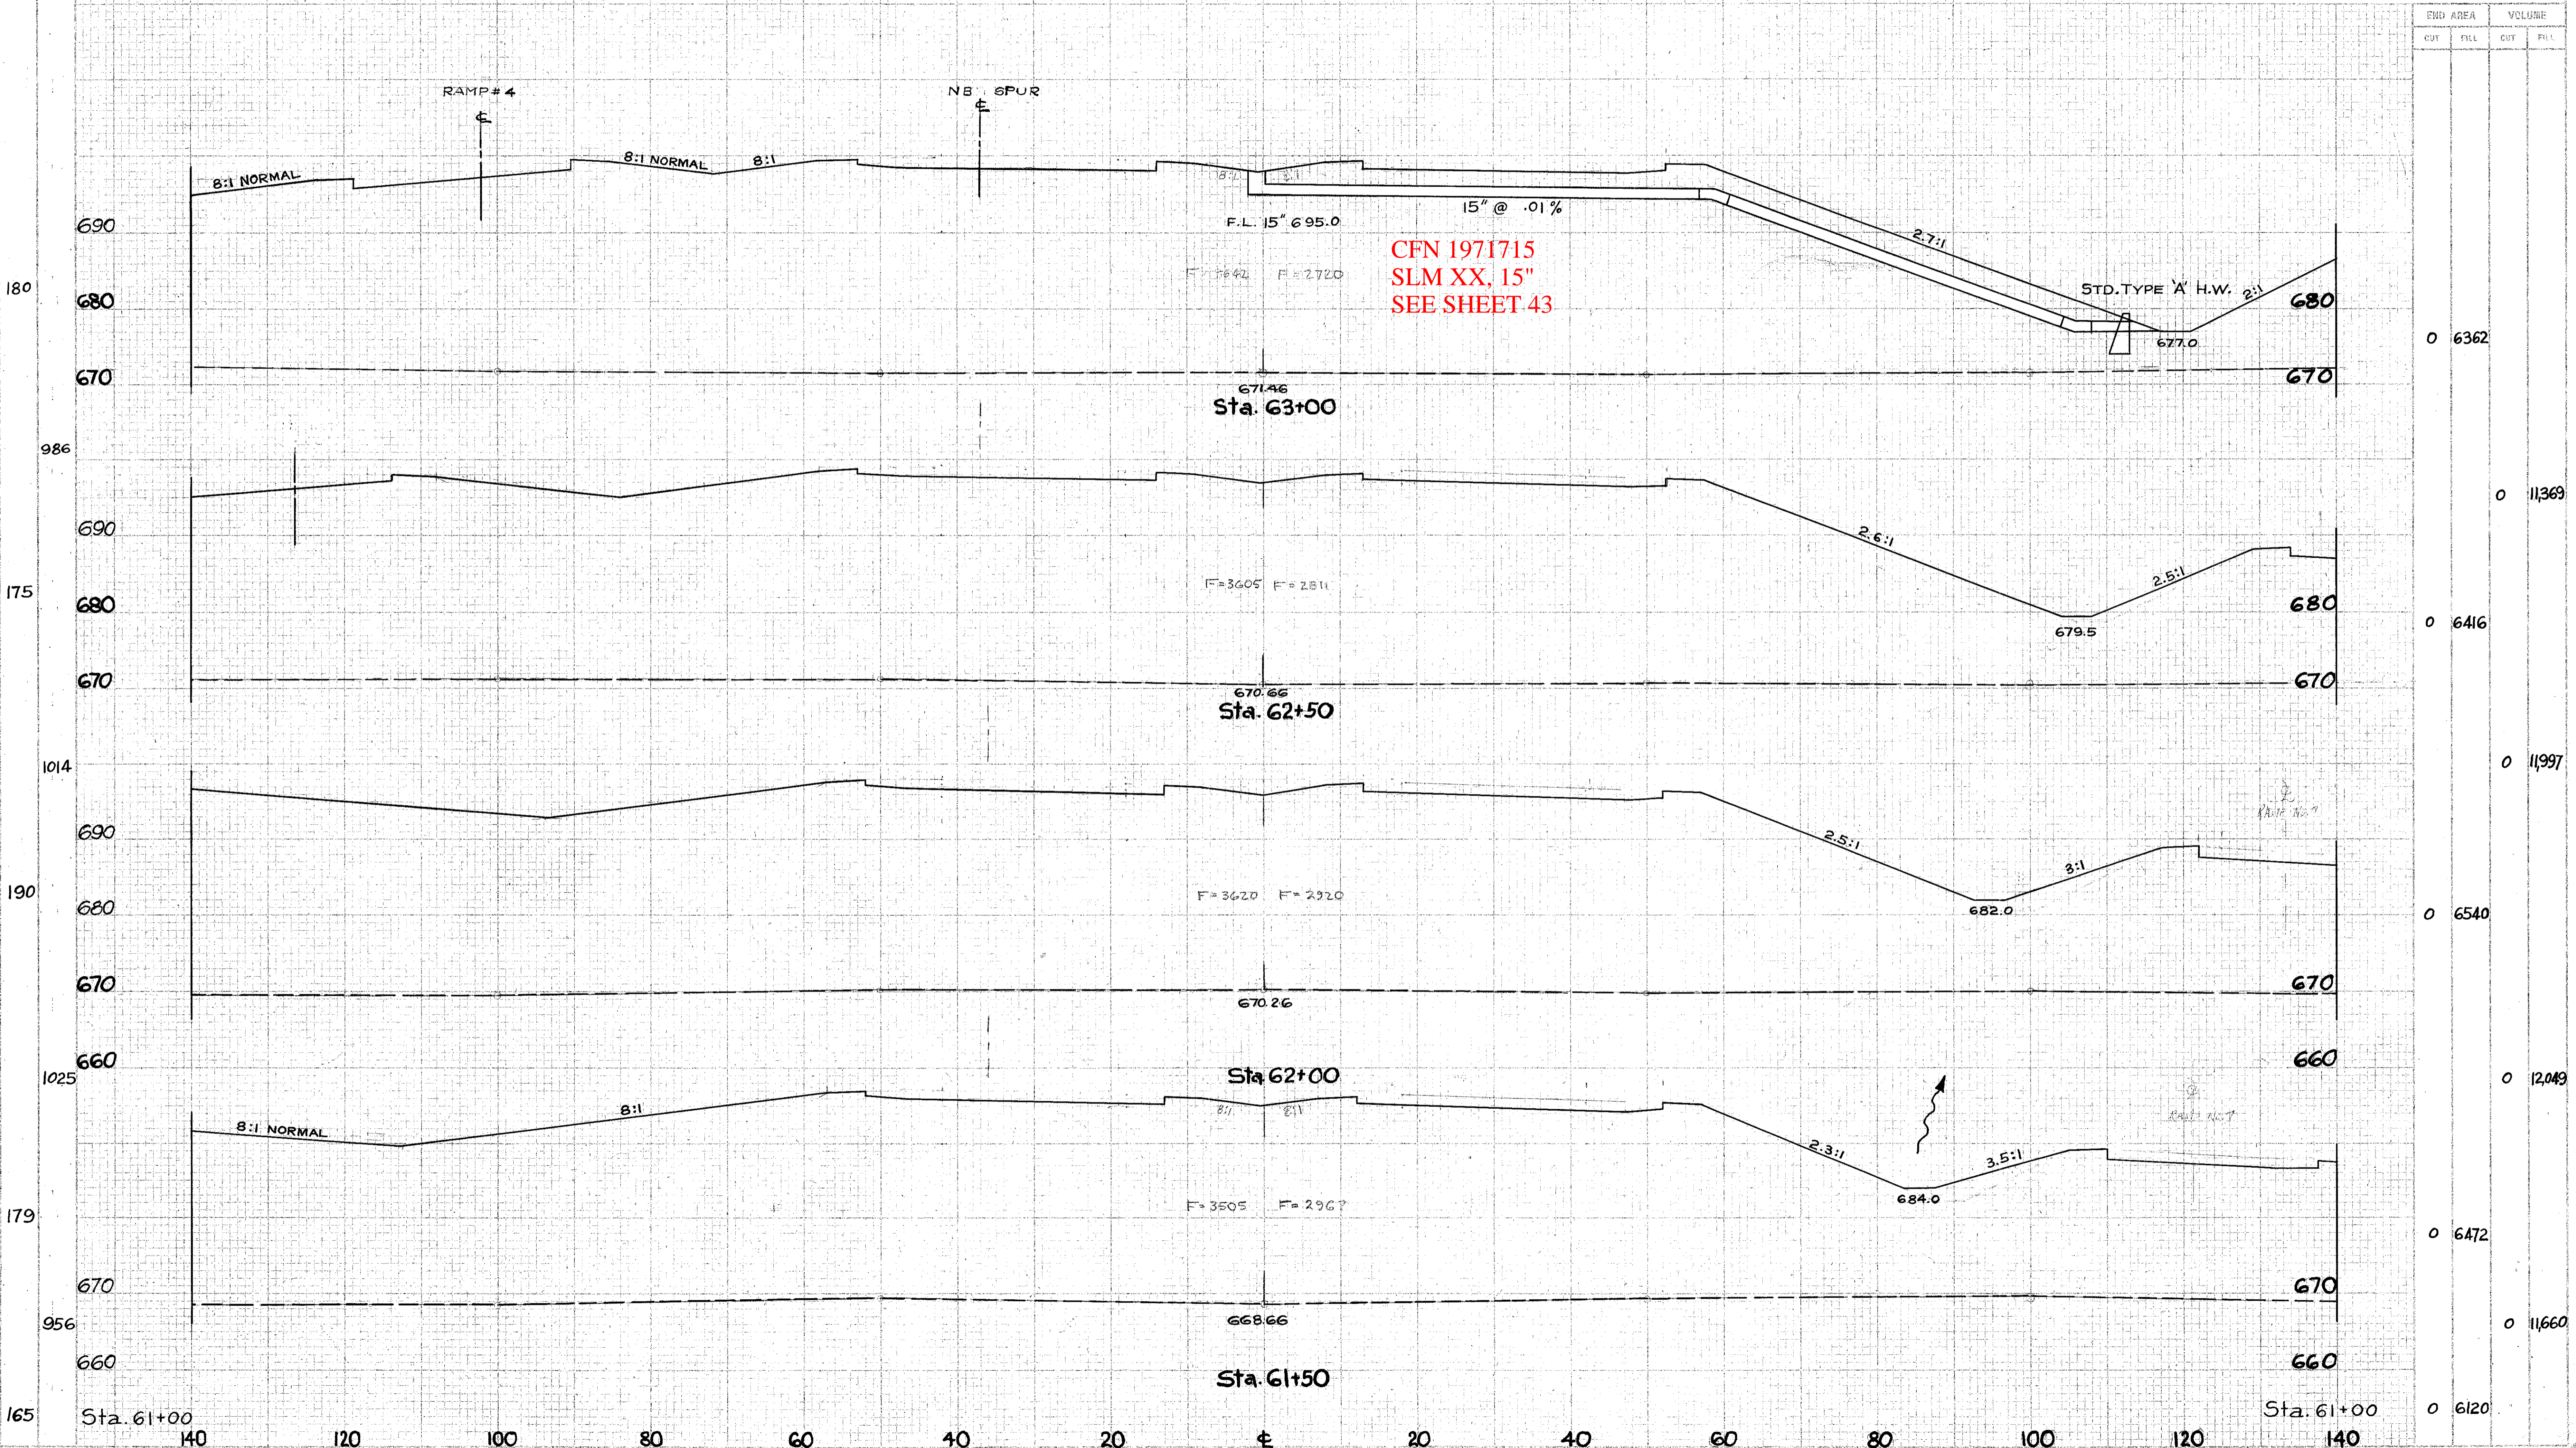

CFN 1971715  
 SLM XX, 15"  
 SEE SHEET 43

EUCLID SPUR X-SECTIONS STA. 61+50 TO STA. 63+00