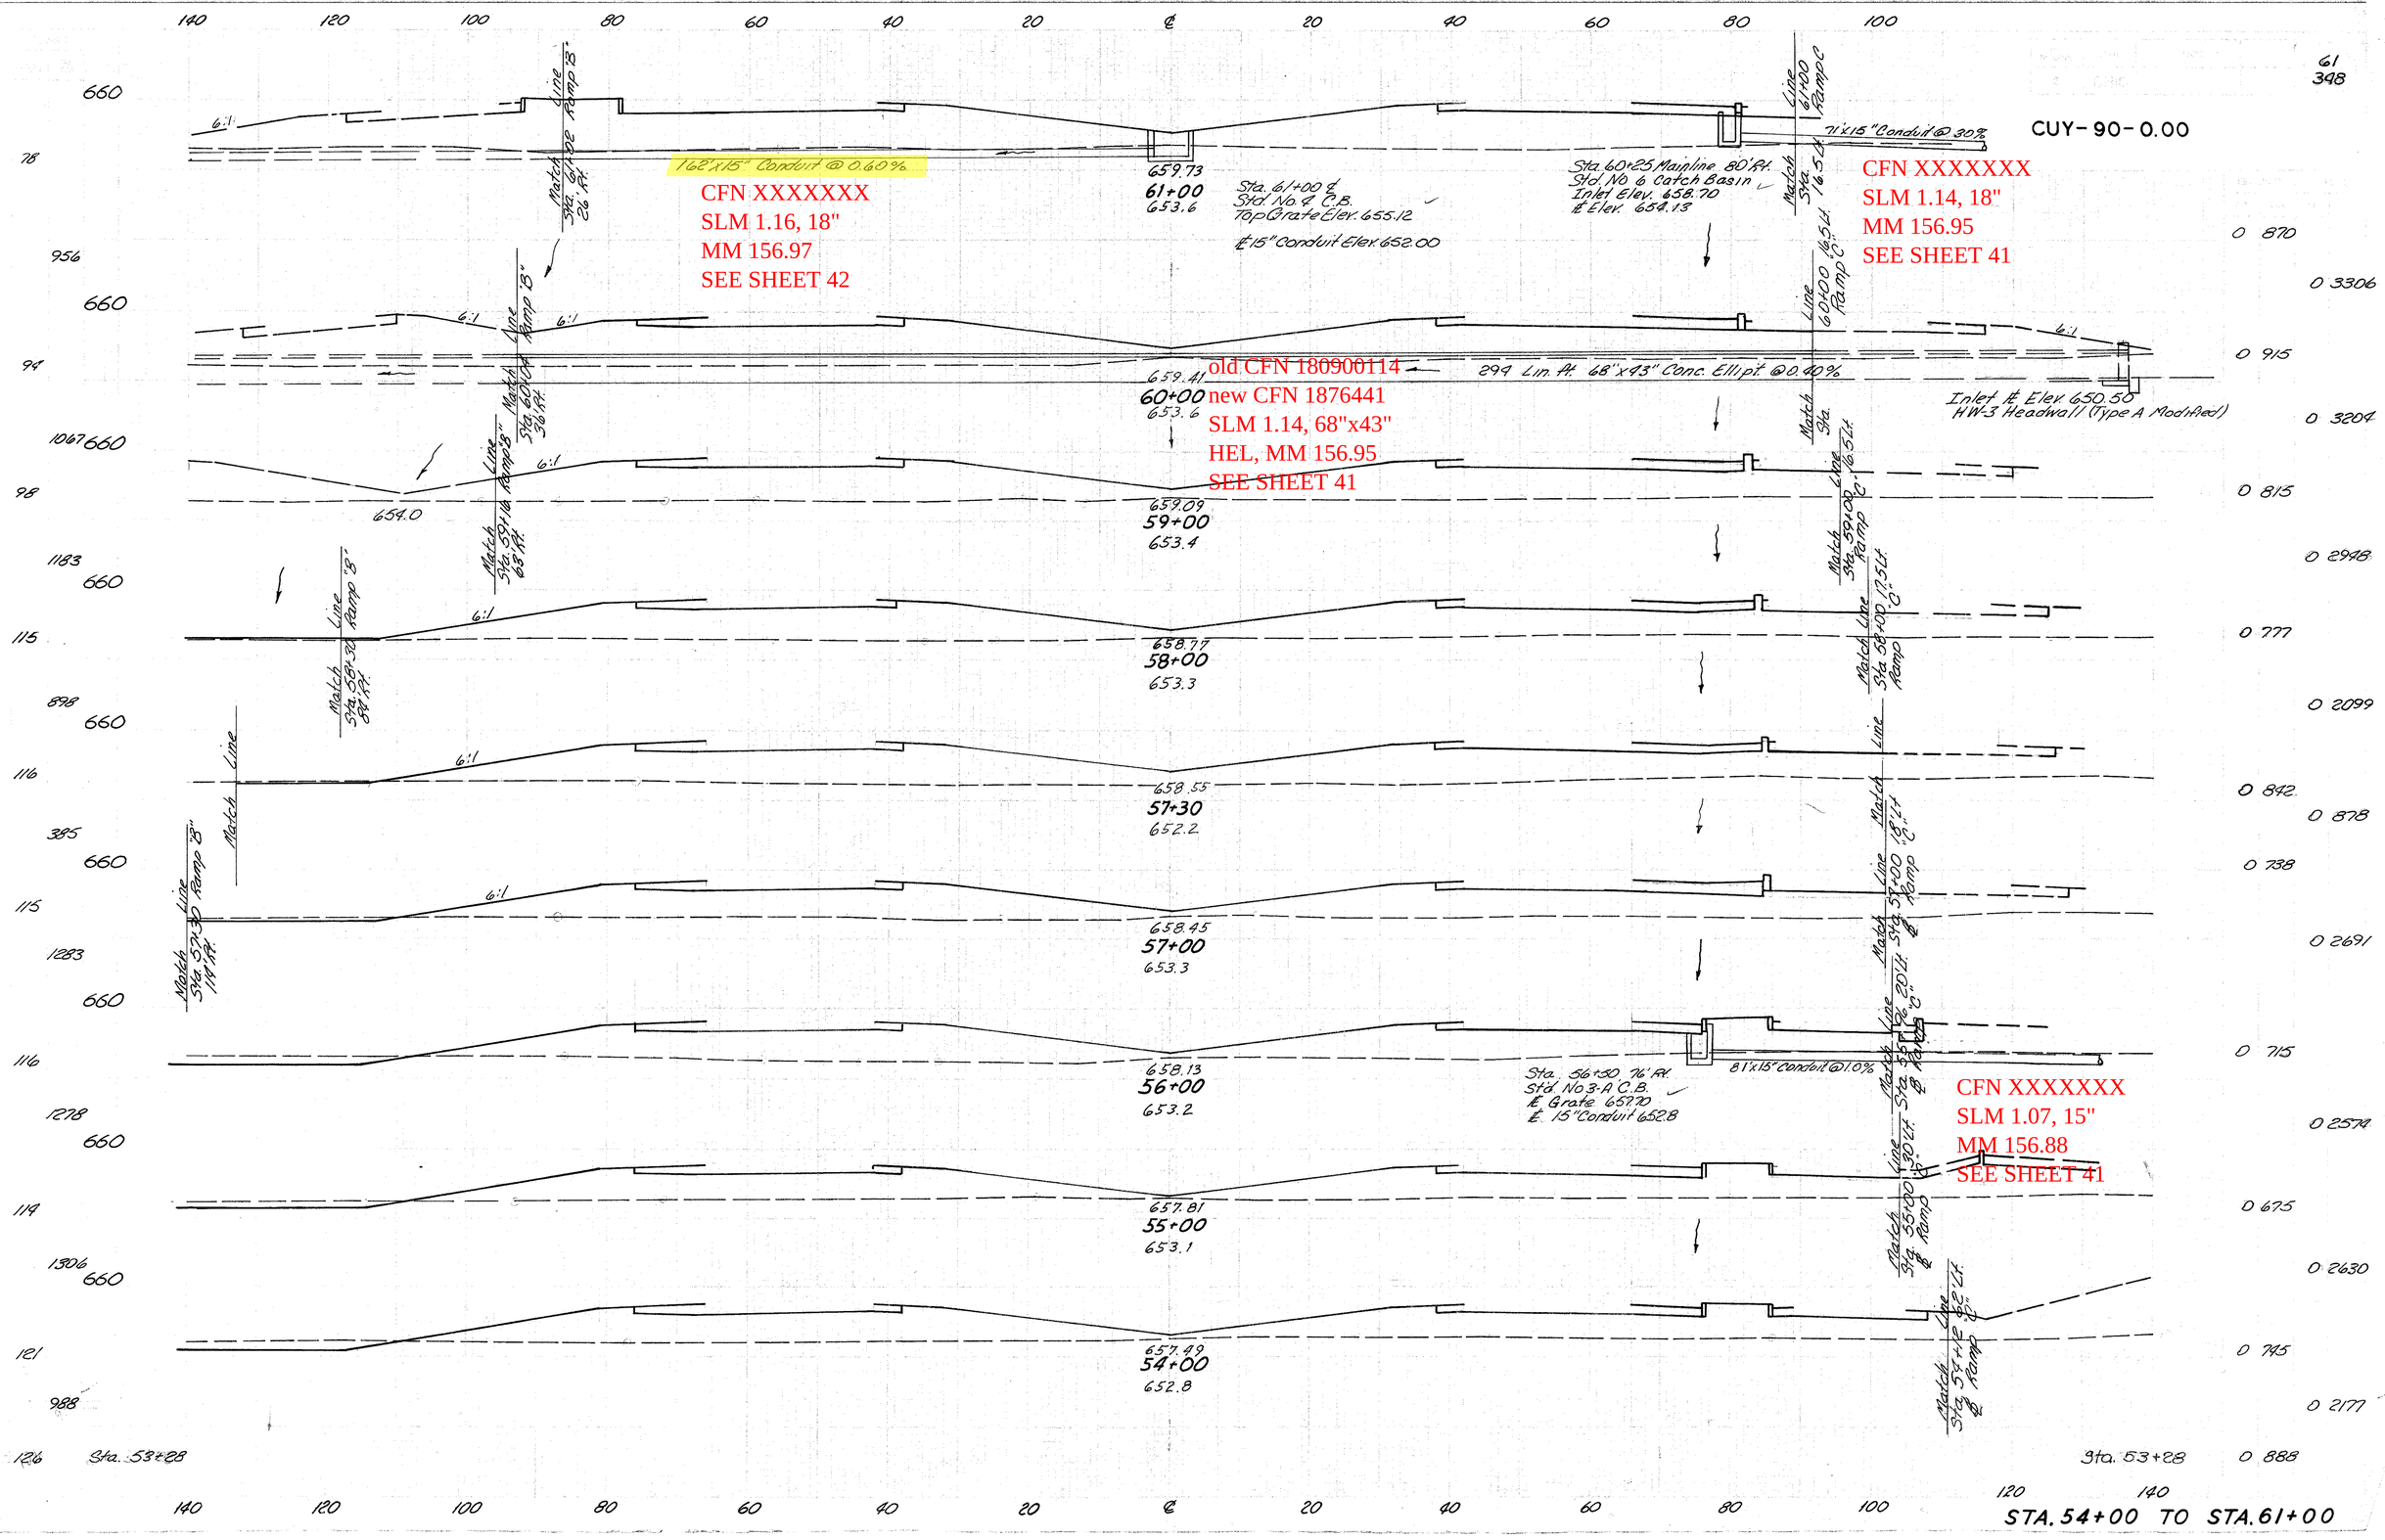
CUY-90-0.00
166'x15" Conduit @ 0.60%
CFN XXXXXXX
SLM 1.16, 18"
MM 156.97
SEE SHEET 42
71'x15" Conduit @ 30%
CFN XXXXXXX
SLM 1.14, 18"
MM 156.95
SEE SHEET 41
old CFN 180900114
new CFN 1876441
SLM 1.14, 68"x43"
HEL, MM 156.95
SEE SHEET 41
294 Lin. Ft. 68"x43" Conc. Ellipt @ 0.40%
Inlet ℄ Elev. 650.50
HW-3 Headwall (Type A Modified)
Sta. 60+25 Mainline 80' Rt.
Std. No. 6 Catch Basin
Inlet Elev. 658.70
℄ Elev. 654.13
Sta. 61+00 ℄
Std. No. 4 C.B.
Top Grate Elev. 655.12
℄ 15" Conduit Elev. 652.00
81'x15" Conduit @ 1.0%
Sta. 56+30 76' Rt.
Std. No. 3-A C.B.
℄ Grate 657.70
℄ 15" Conduit 652.8
CFN XXXXXXX
SLM 1.07, 15"
MM 156.88
SEE SHEET 41
Sta. 53+28
STA. 54+00 TO STA. 61+00