CUY-90-0.00

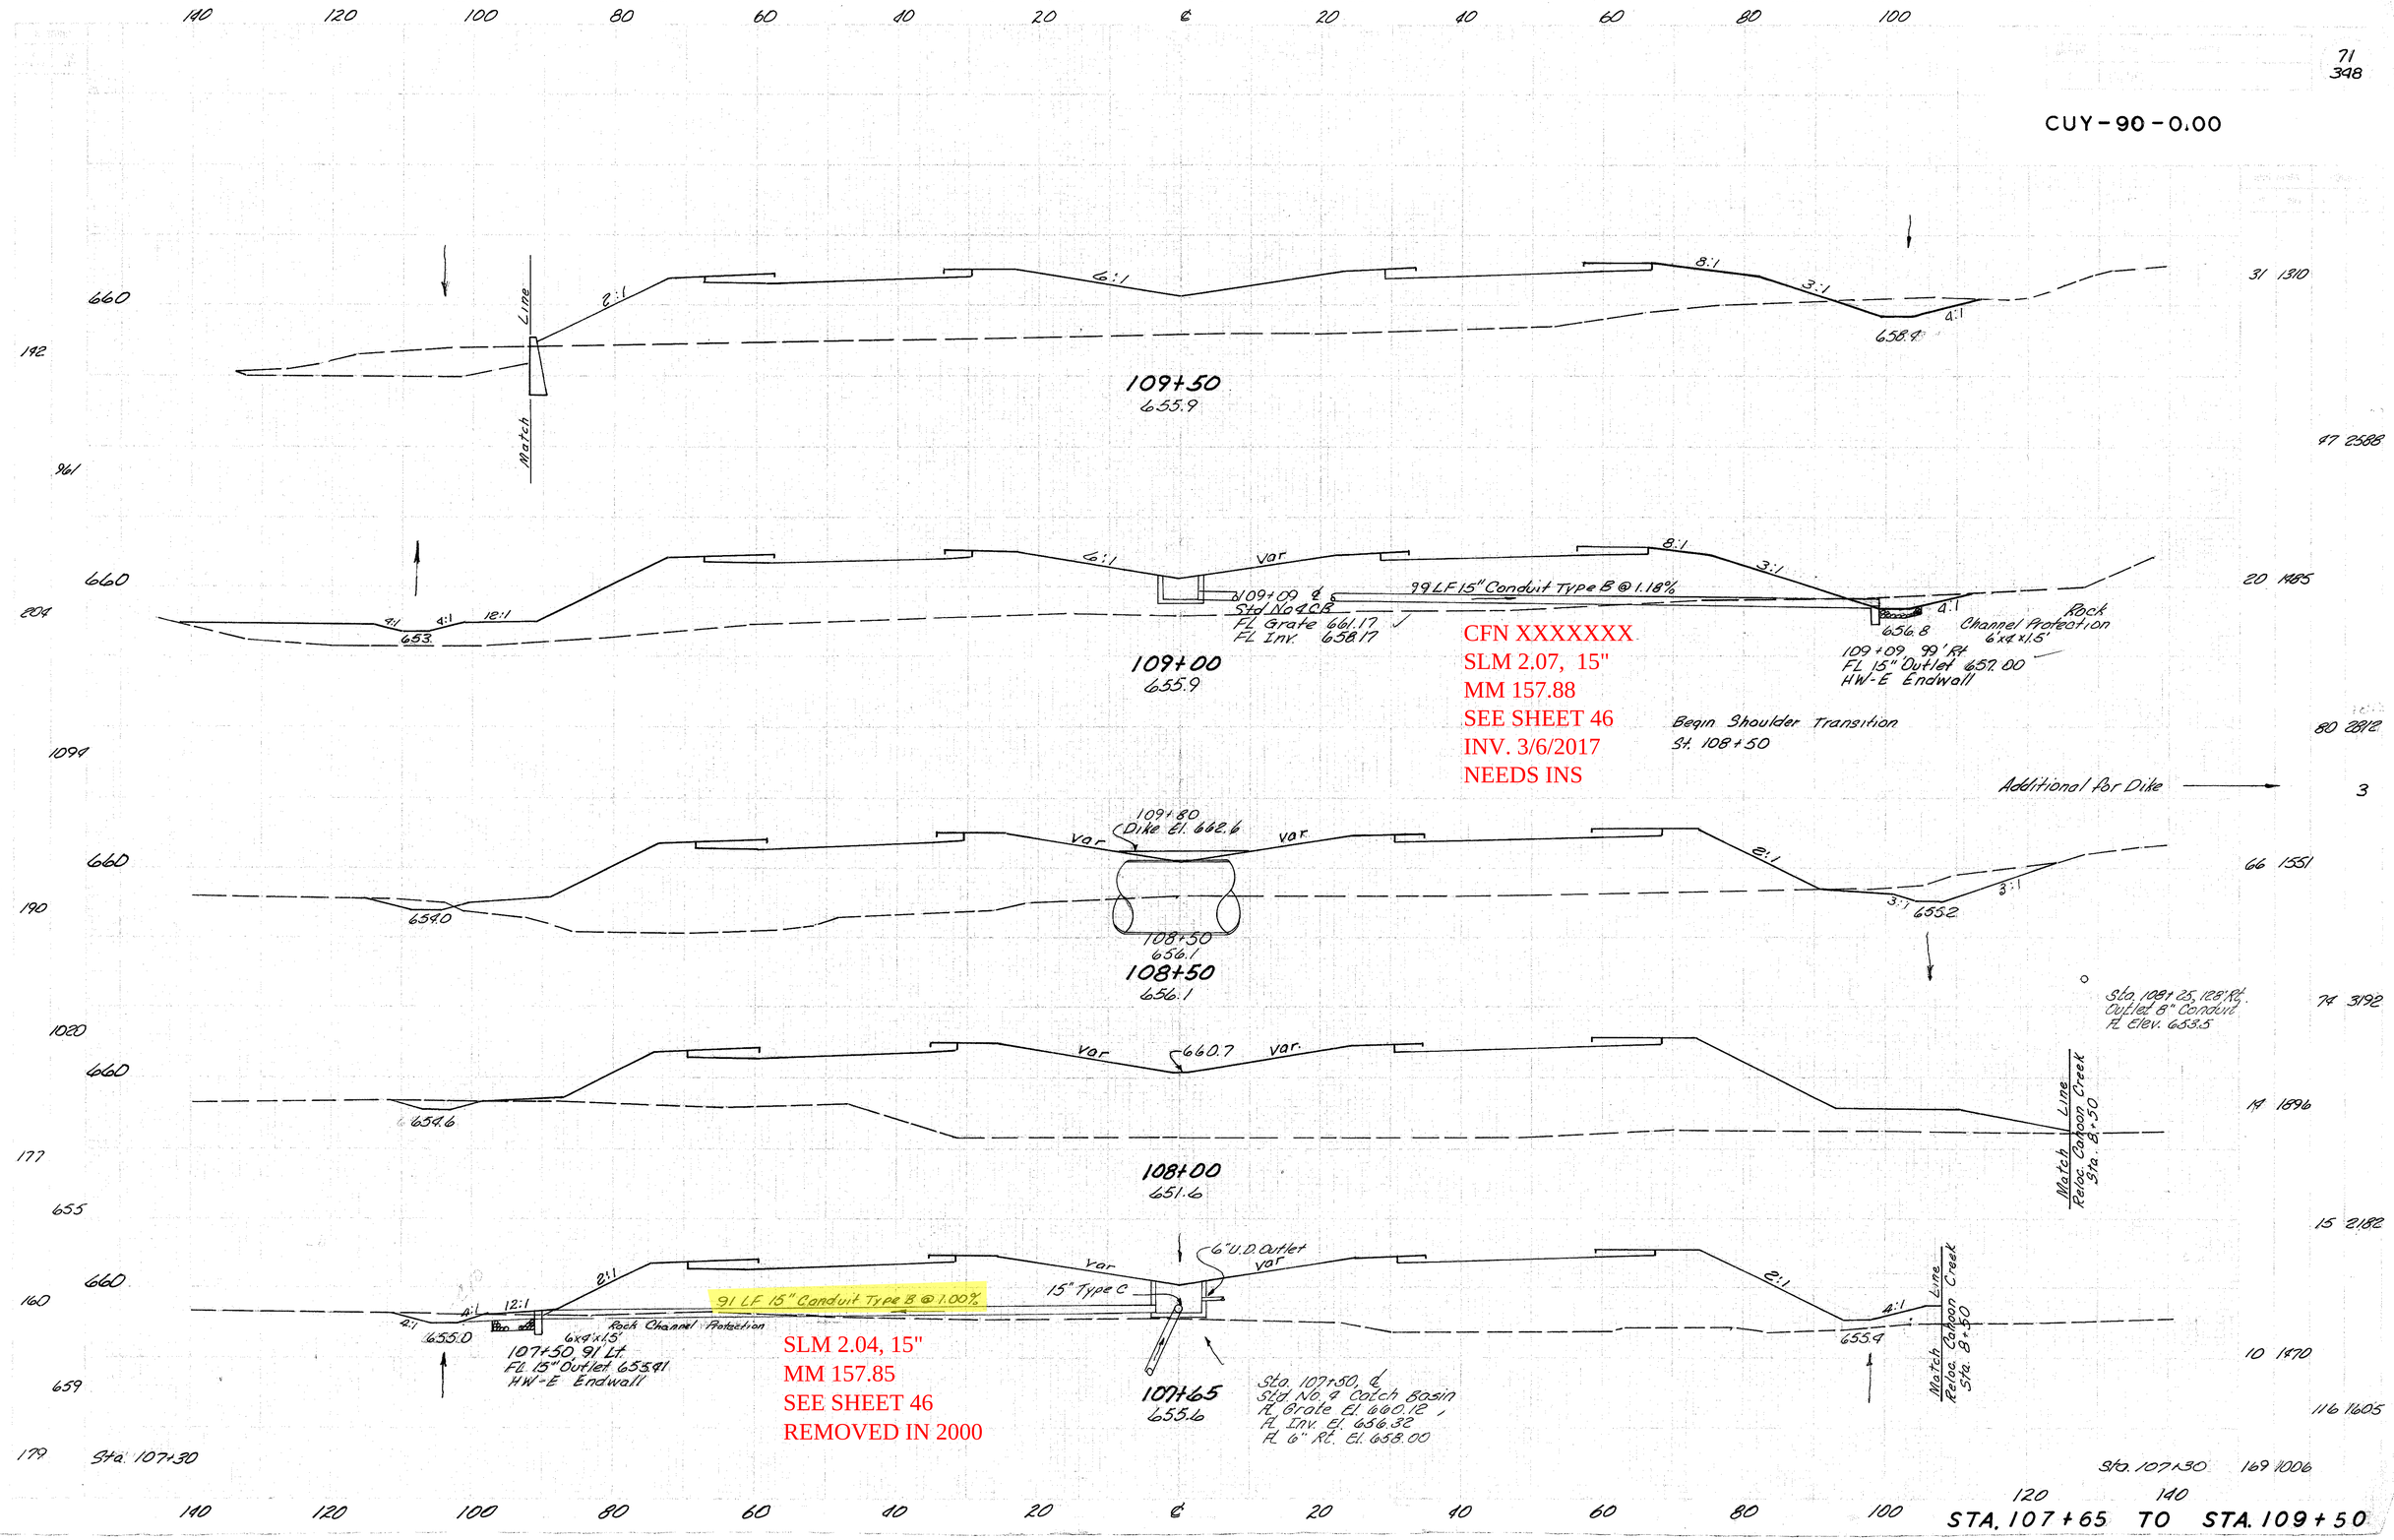

CFN XXXXXXX
SLM 2.07, 15"
MM 157.88
SEE SHEET 46
INV. 3/6/2017
NEEDS INS

SLM 2.04, 15"
MM 157.85
SEE SHEET 46
REMOVED IN 2000