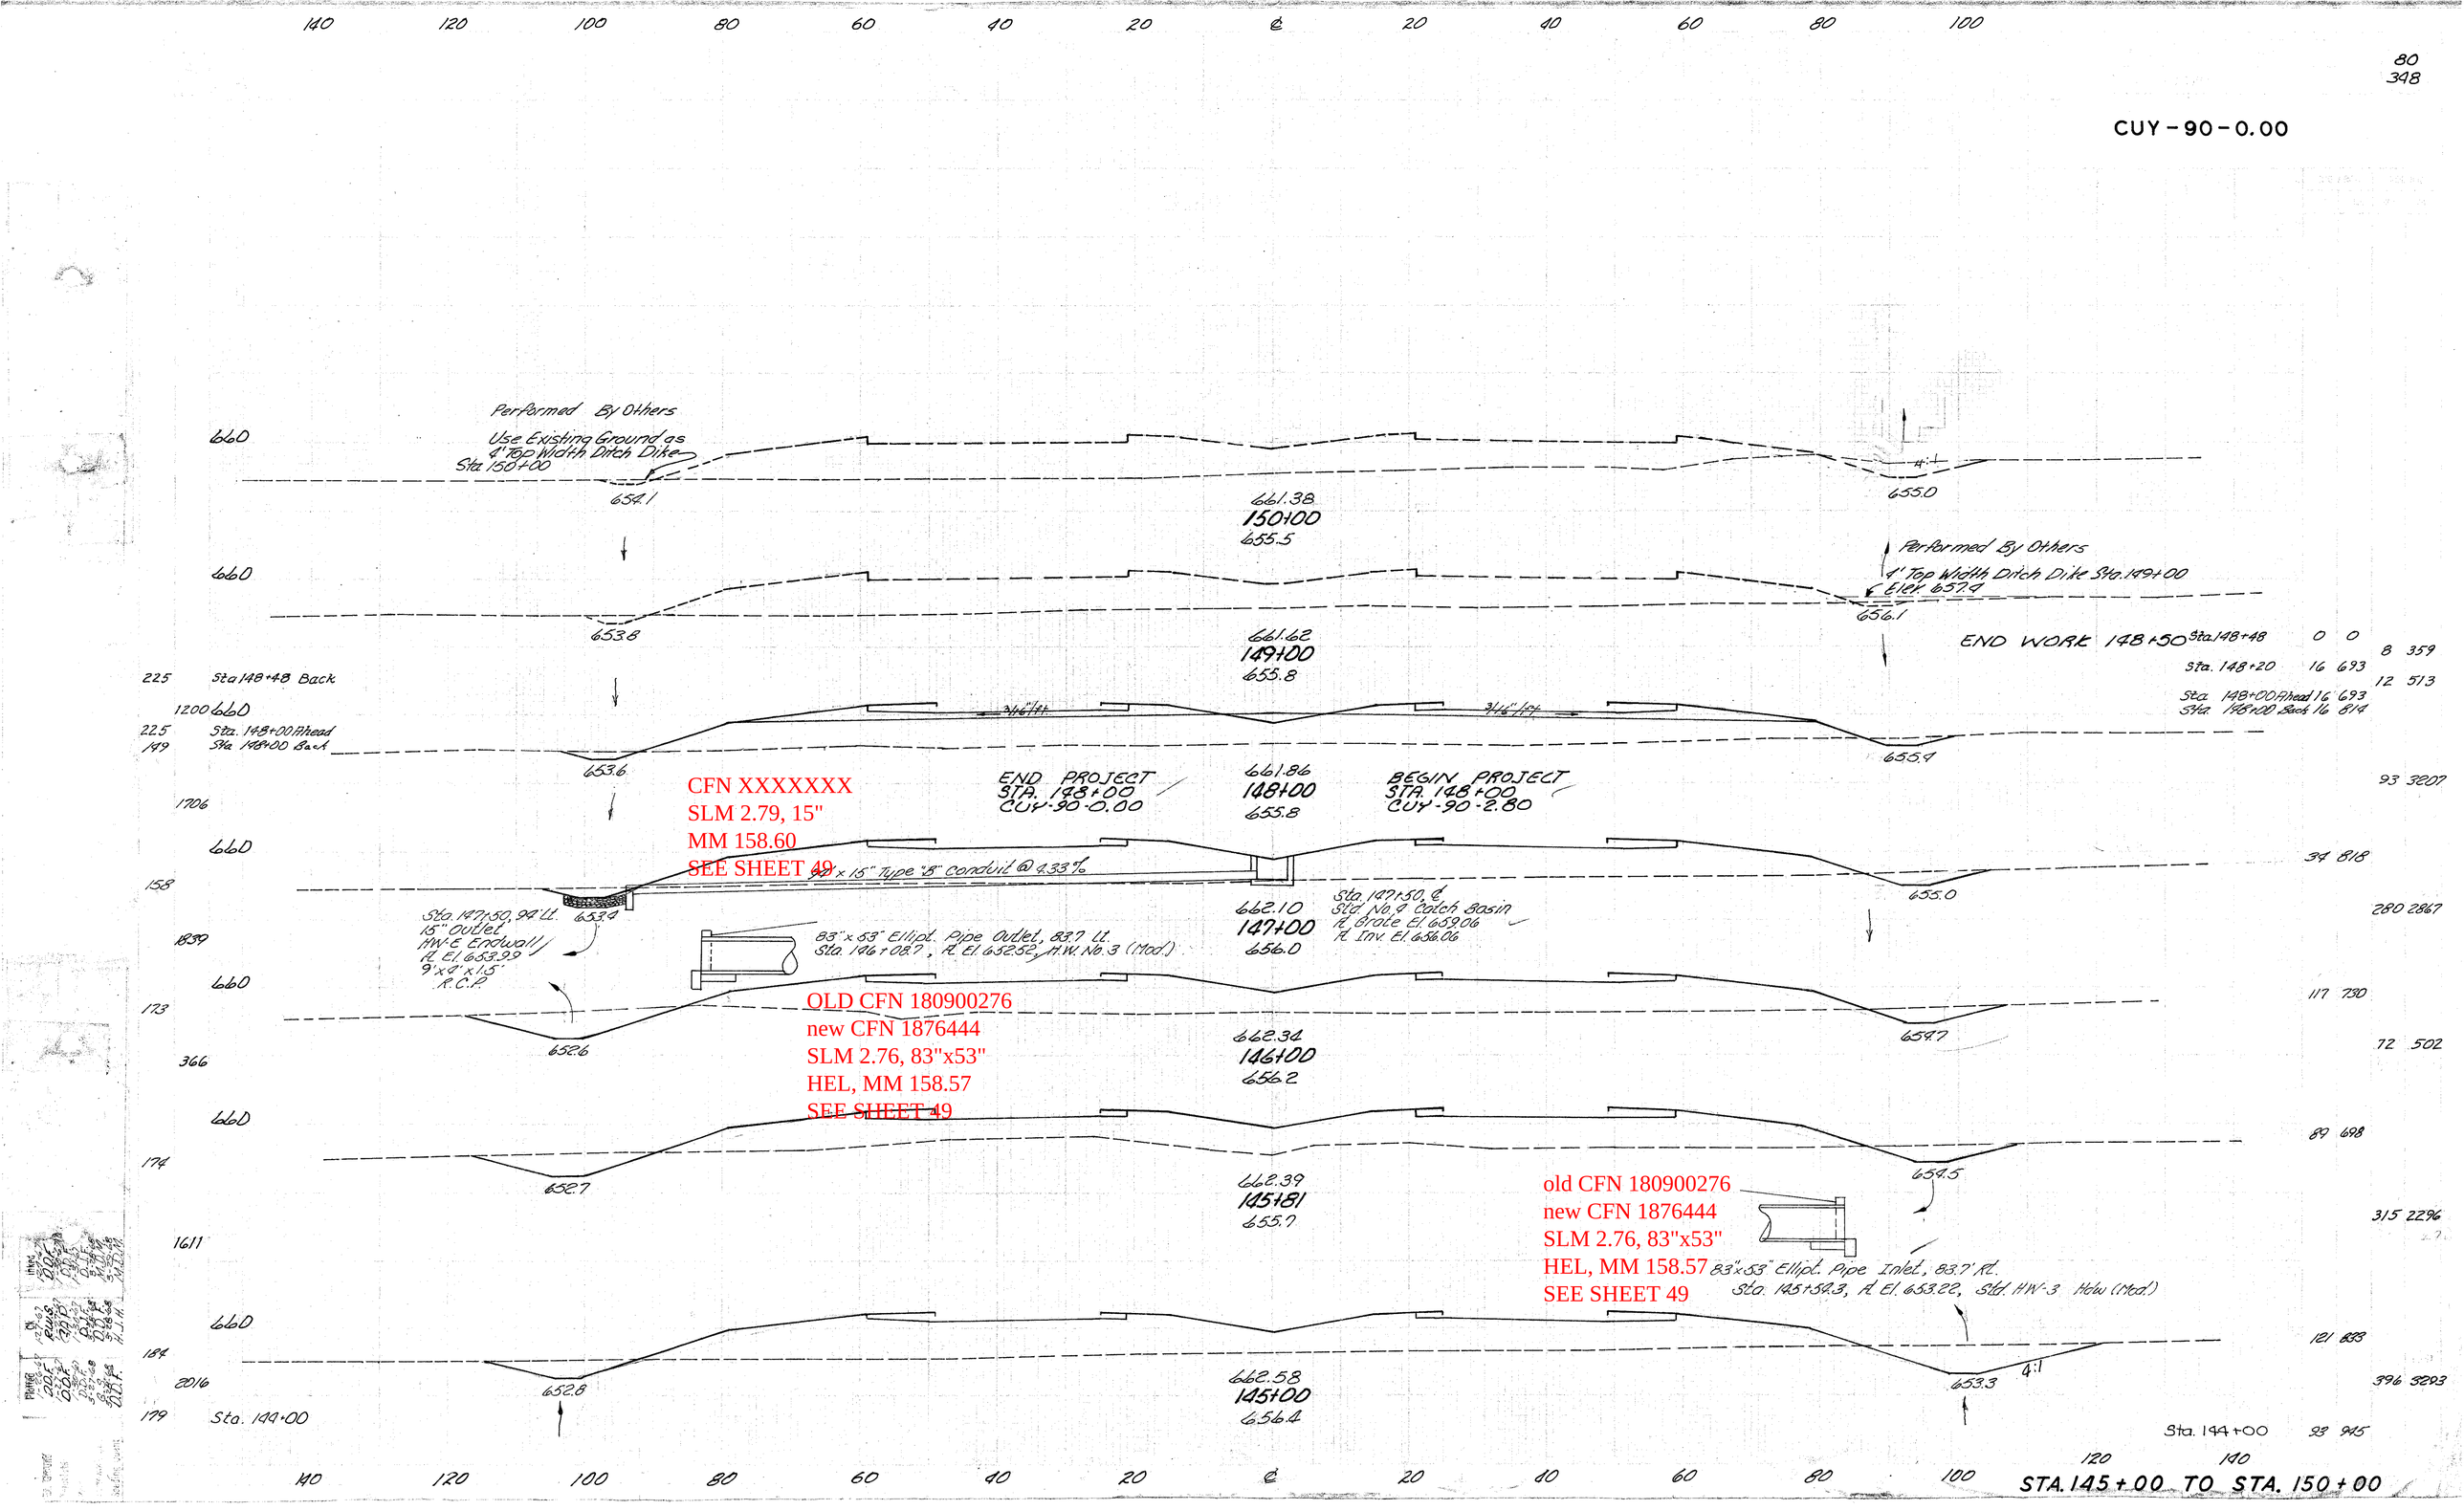

CUY-90-0.00
Performed By Others
Use Existing Ground as 4' Top Width Ditch Dike Sta 150+00
654.1
661.38
150+00
655.5
655.0
Performed By Others
4' Top Width Ditch Dike Sta. 149+00
Elev. 657.4
653.8
661.62
149+00
655.8
656.1
END WORK 148+50
Sta. 148+48 0 0
Sta. 148+20 16 693
Sta. 148+00 Ahead 16 693
Sta. 148+00 Back 16 814
Sta 148+48 Back
Sta. 148+00 Ahead
Sta 148+00 Back
653.6
655.4
END PROJECT
STA. 148+00
CUY-90-0.00
661.86
148+00
655.8
BEGIN PROJECT
STA. 148+00
CUY-90-2.80
CFN XXXXXXX
SLM 2.79, 15"
MM 158.60
SEE SHEET 49
94' x 15" Type "B" Conduit @ 4.33%
Sta. 147+50, 94' Lt.
15" Outlet
HW-E Endwall
Fl. El. 653.99
9'x4'x1.5'
R.C.P.
653.4
662.10
147+00
656.0
Sta. 147+50, ℄
Std. No. 4 Catch Basin
Fl. Grate El. 659.06
Fl. Inv. El. 656.06
655.0
83"x53" Ellipt. Pipe Outlet, 83.7 Lt.
Sta. 146+08.7, Fl. El. 652.52, H.W. No. 3 (Mod.)
OLD CFN 180900276
new CFN 1876444
SLM 2.76, 83"x53"
HEL, MM 158.57
SEE SHEET 49
652.6
662.34
146+00
656.2
654.7
652.7
662.39
145+81
655.7
654.5
old CFN 180900276
new CFN 1876444
SLM 2.76, 83"x53"
HEL, MM 158.57
SEE SHEET 49
83"x53" Ellipt. Pipe Inlet, 83.7' Rt.
Sta. 145+54.3, Fl. El. 653.22, Std. HW-3 Hdw (Mod.)
652.8
662.58
145+00
656.4
653.3
4:1
Sta. 144+00
Sta. 144+00
STA. 145+00 TO STA. 150+00