


CUY-90-2.80
 QUANTITIES CALC. JcHo 3MAY'73
 QUANTITIES CK'D. LVB 5-8-73

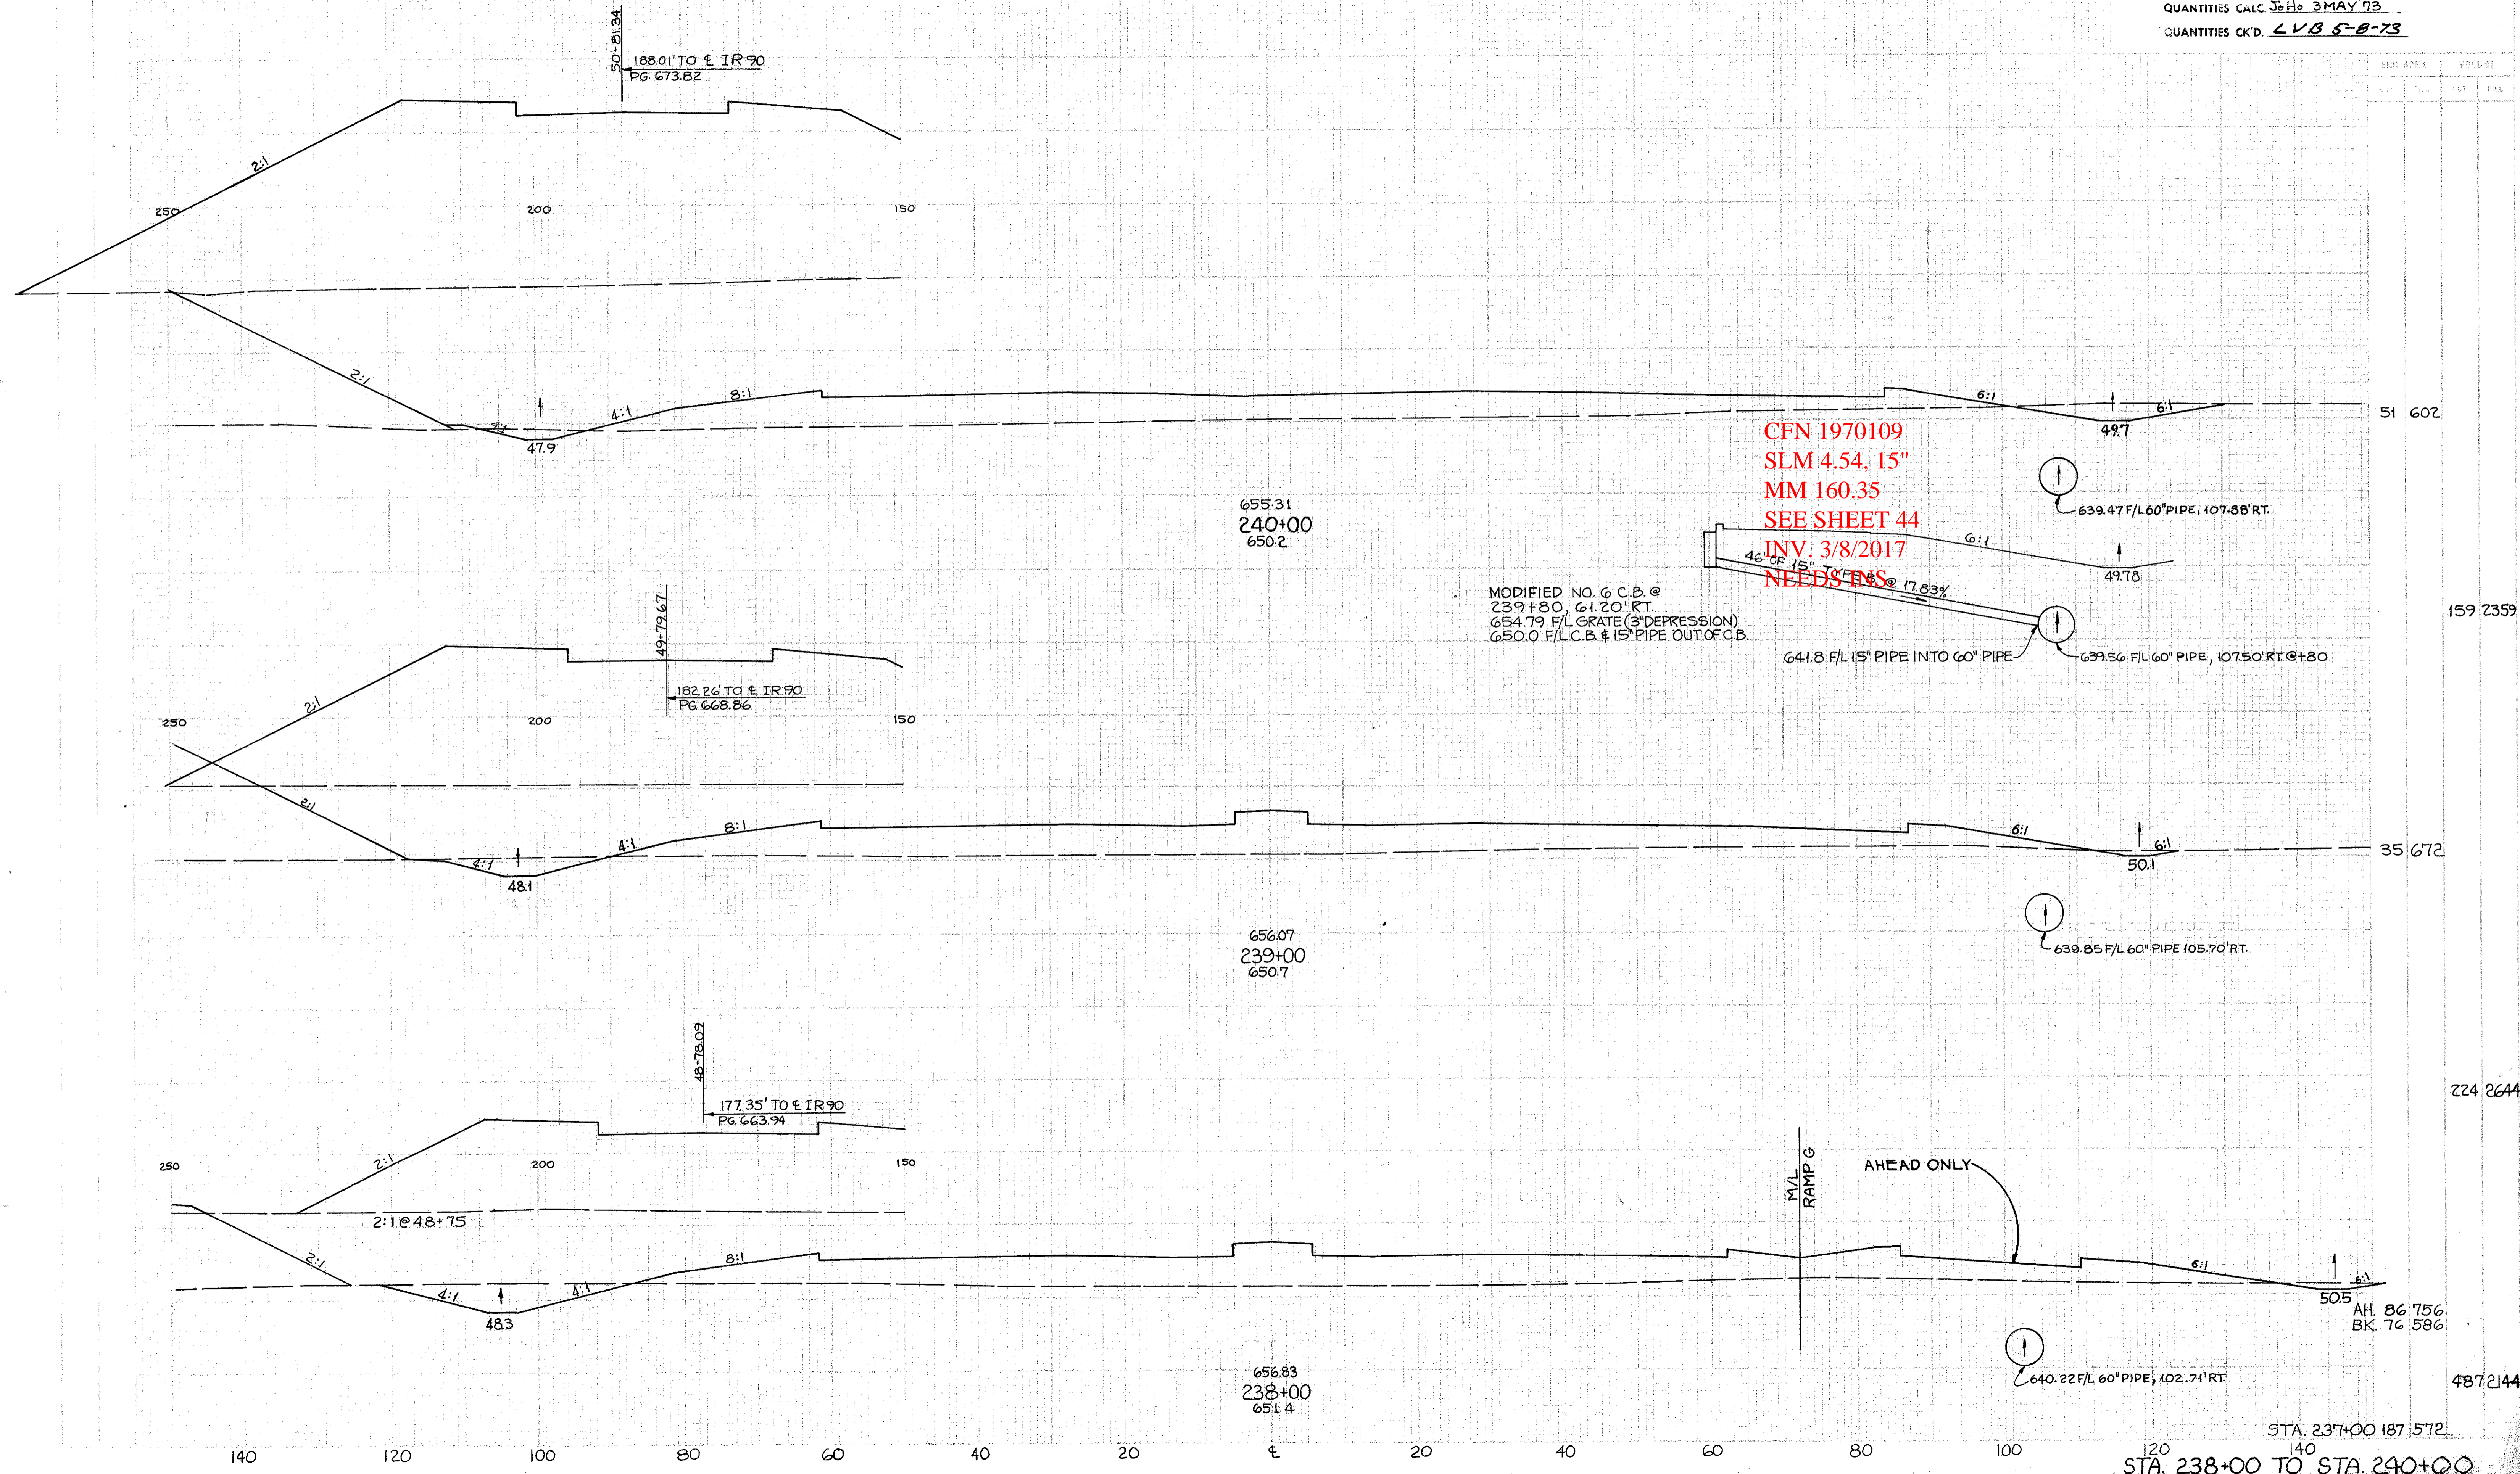

STATION	SECTION AREA		VOLUME	
	FT.	IN.	CUB. FT.	CU. YD.
240+00	51	602		
239+00	159	2359		
239+00	35	672		
238+00	224	2644		
238+00	487	2144		