FED. RD. DIVISION	STATE	PROJECT	
2	OHIO		

CUY-90-2.80
QUANTITIES CALC. JoHo 3 MAY 1973
QUANTITIES CK'D. LVB 5-8-73

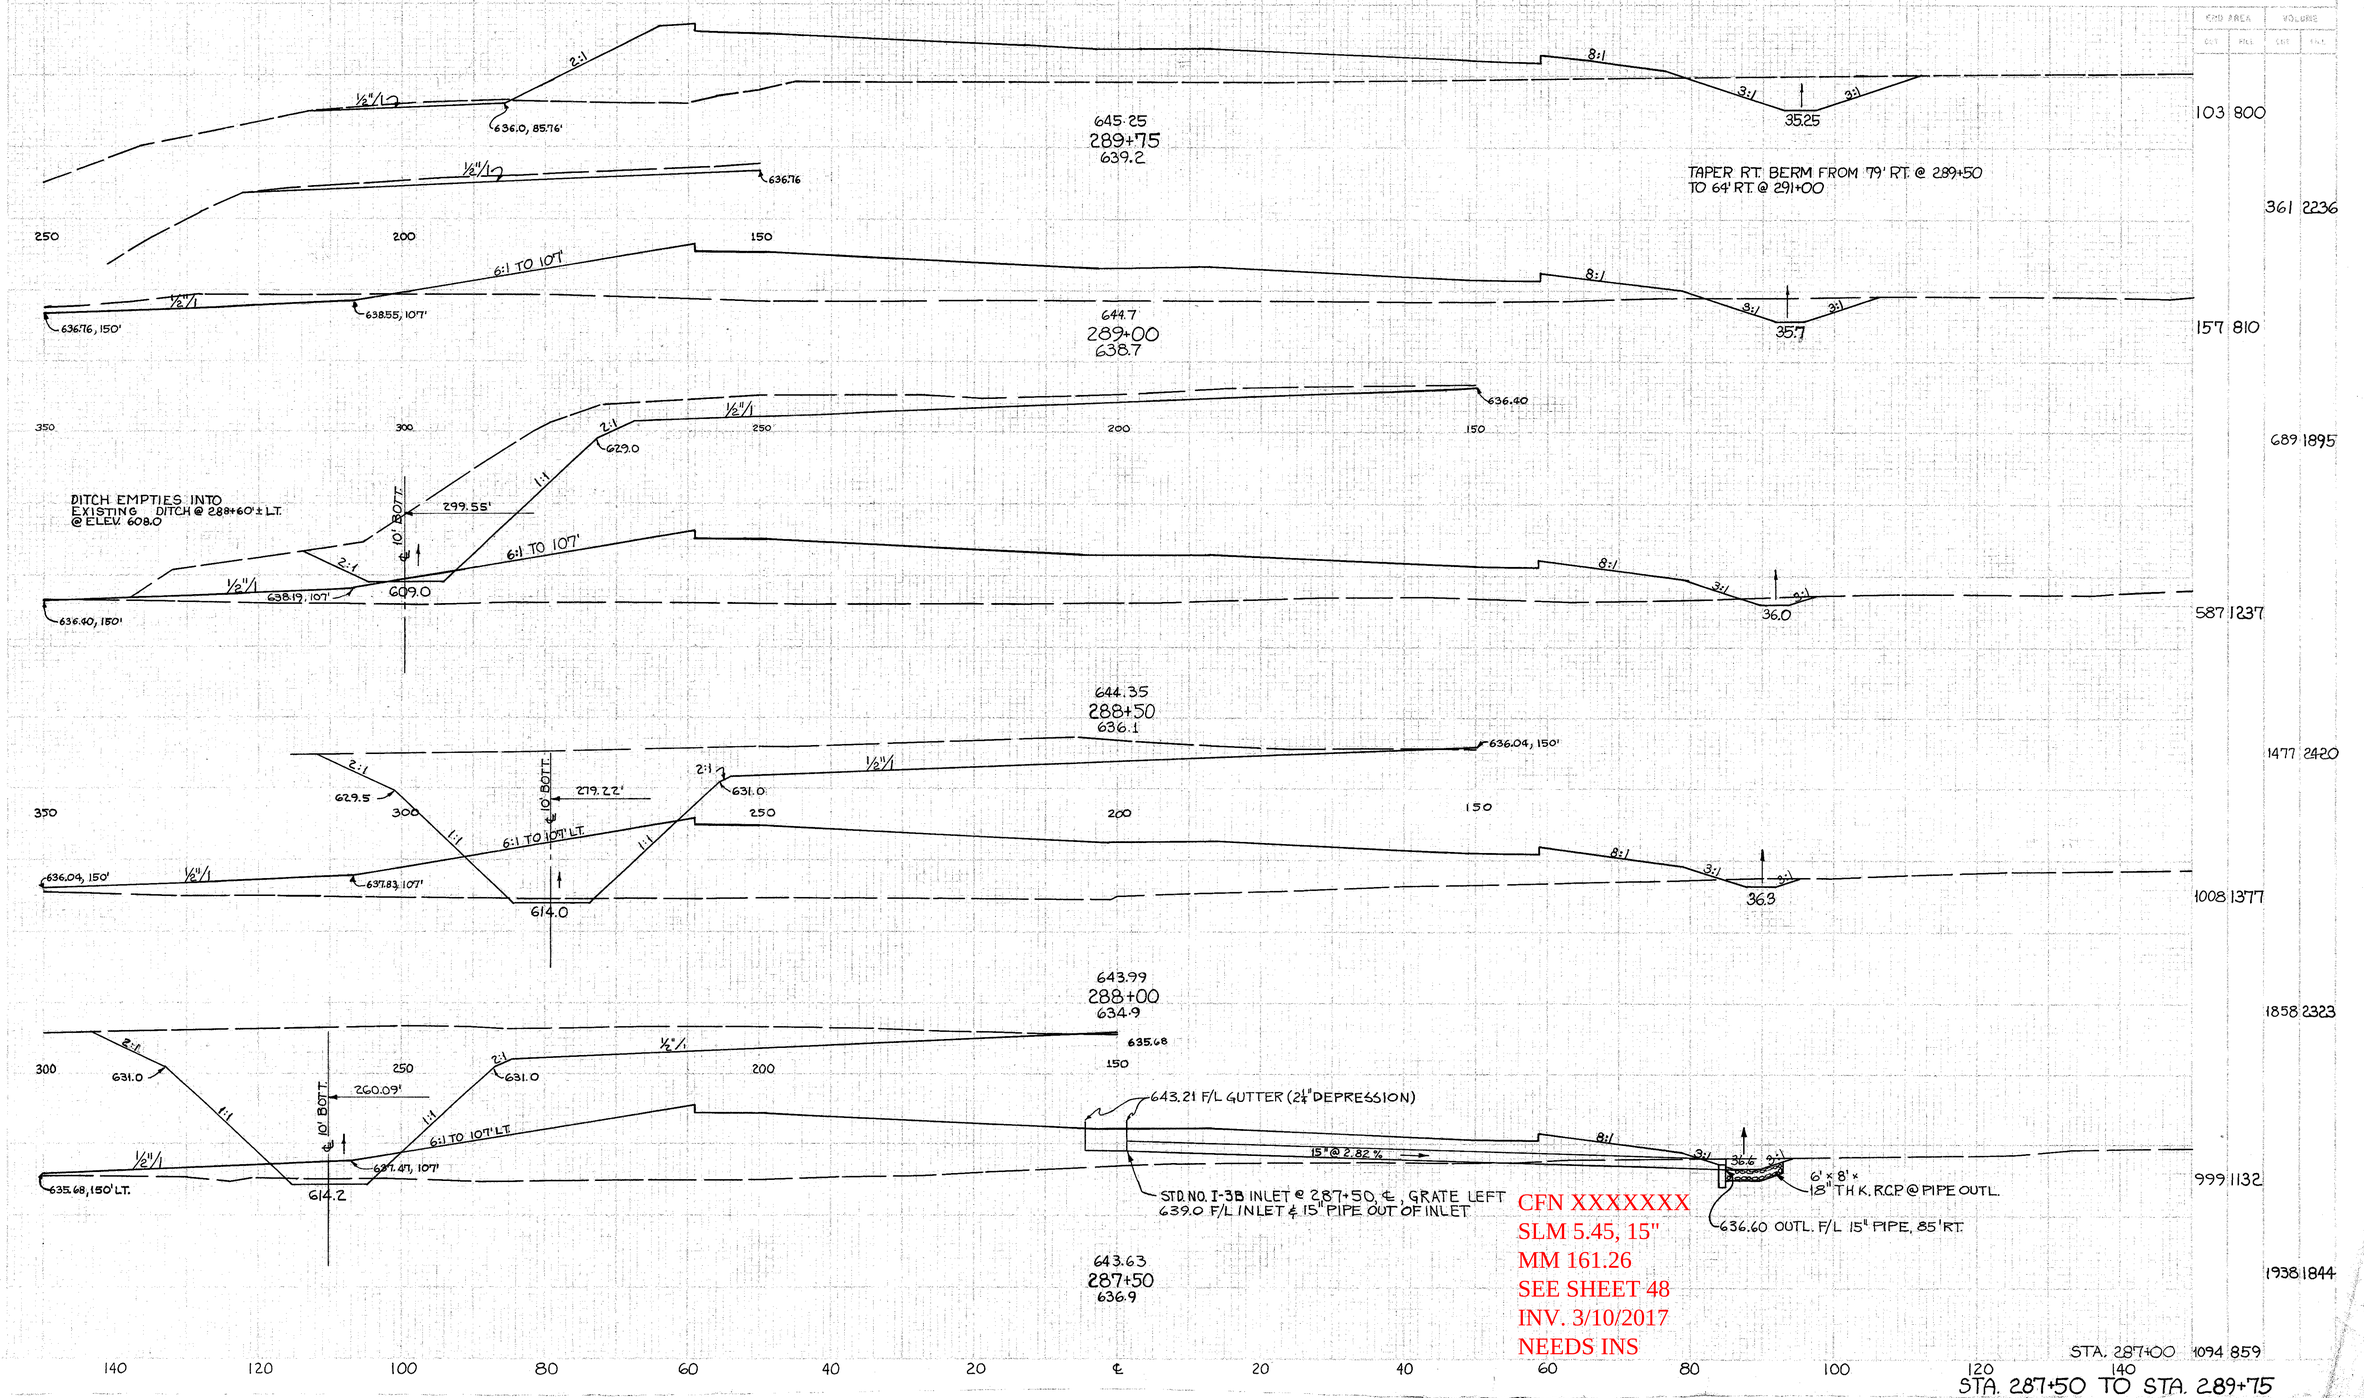

END AREA CUT	END AREA FILL	VOLUME CUT	VOLUME FILL
103	800		
		361	2236
157	810		
		689	1895
587	1237		
		1477	2420
1008	1377		
		1858	2323
999	1132		
		1938	1844
1094	859		

CFN XXXXXXX
SLM 5.45, 15"
MM 161.26
SEE SHEET 48
INV. 3/10/2017
NEEDS INS