

BENCHMARK: CHISELED "□" ON ϕ OF HEADWALL
 STA. 145+52± 86'± RT.
 ELEV.= 658.99


BENCHMARK: CHISELED "□" ON EAST SIDE OF HEADWALL STA. 154+77±
 90'± RT. ELEV.= 654.55

old CFN 180900276
 new CFN 1876444
 SLM 2.76, 83"x53"
 HEL, MM 158.57

CFN 1968526
 SLM 2.79, 15"
 MMM 158.60

CFN 1968523
 SLM XX, 18"
 SEE SHEET 282
 INV. 3/7/2017
 NEEDS INS

SEE SHEETS 547 TO 581 FOR NOISE BARRIER PROFILES

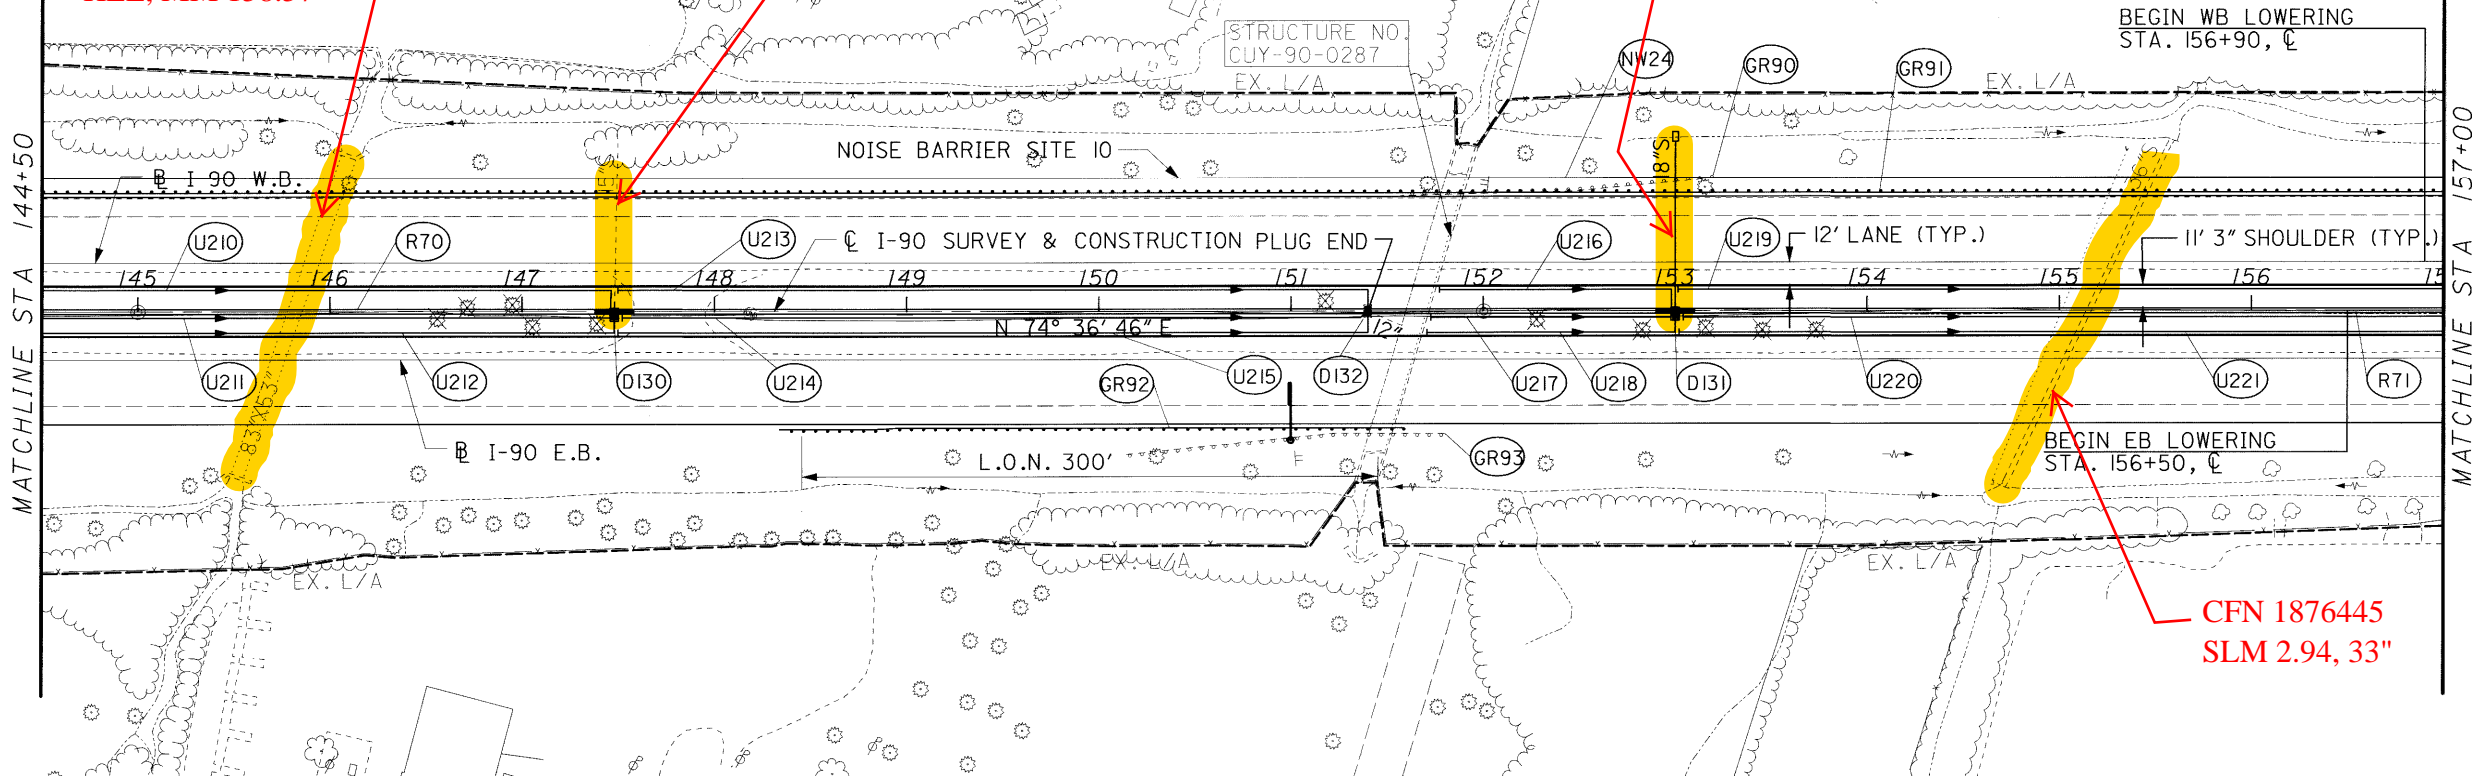



Grate Elevations and Inverts:

- I-3B50 STA. 147+48, 3' RT. GRATE EL 661.77, 15" INV. N 656.06
- REMOVE CB-4 STA. 147+48, 1.7' RT. GRATE EL 659.10, 15" INV. N 656.06
- ABANDON CB-4 STA. 151+40, ϕ GRATE EL 658.83, 12" INV. E 656.35
- I-3B50 STA. 153+00, 3' RT. GRATE EL 660.86, 18" INV. N 655.92
- EX. 36" CULVERT STA. 155+14

PLAN AND PROFILE
 STA 144+50 TO STA 157+00
 CUY-90-0.00
 160
 582