


Seeding
End
Width Sq. Ft.

CUYAHOGA & LAKE COUNTIES
CUY-I-15.91
LAK-I-0.00

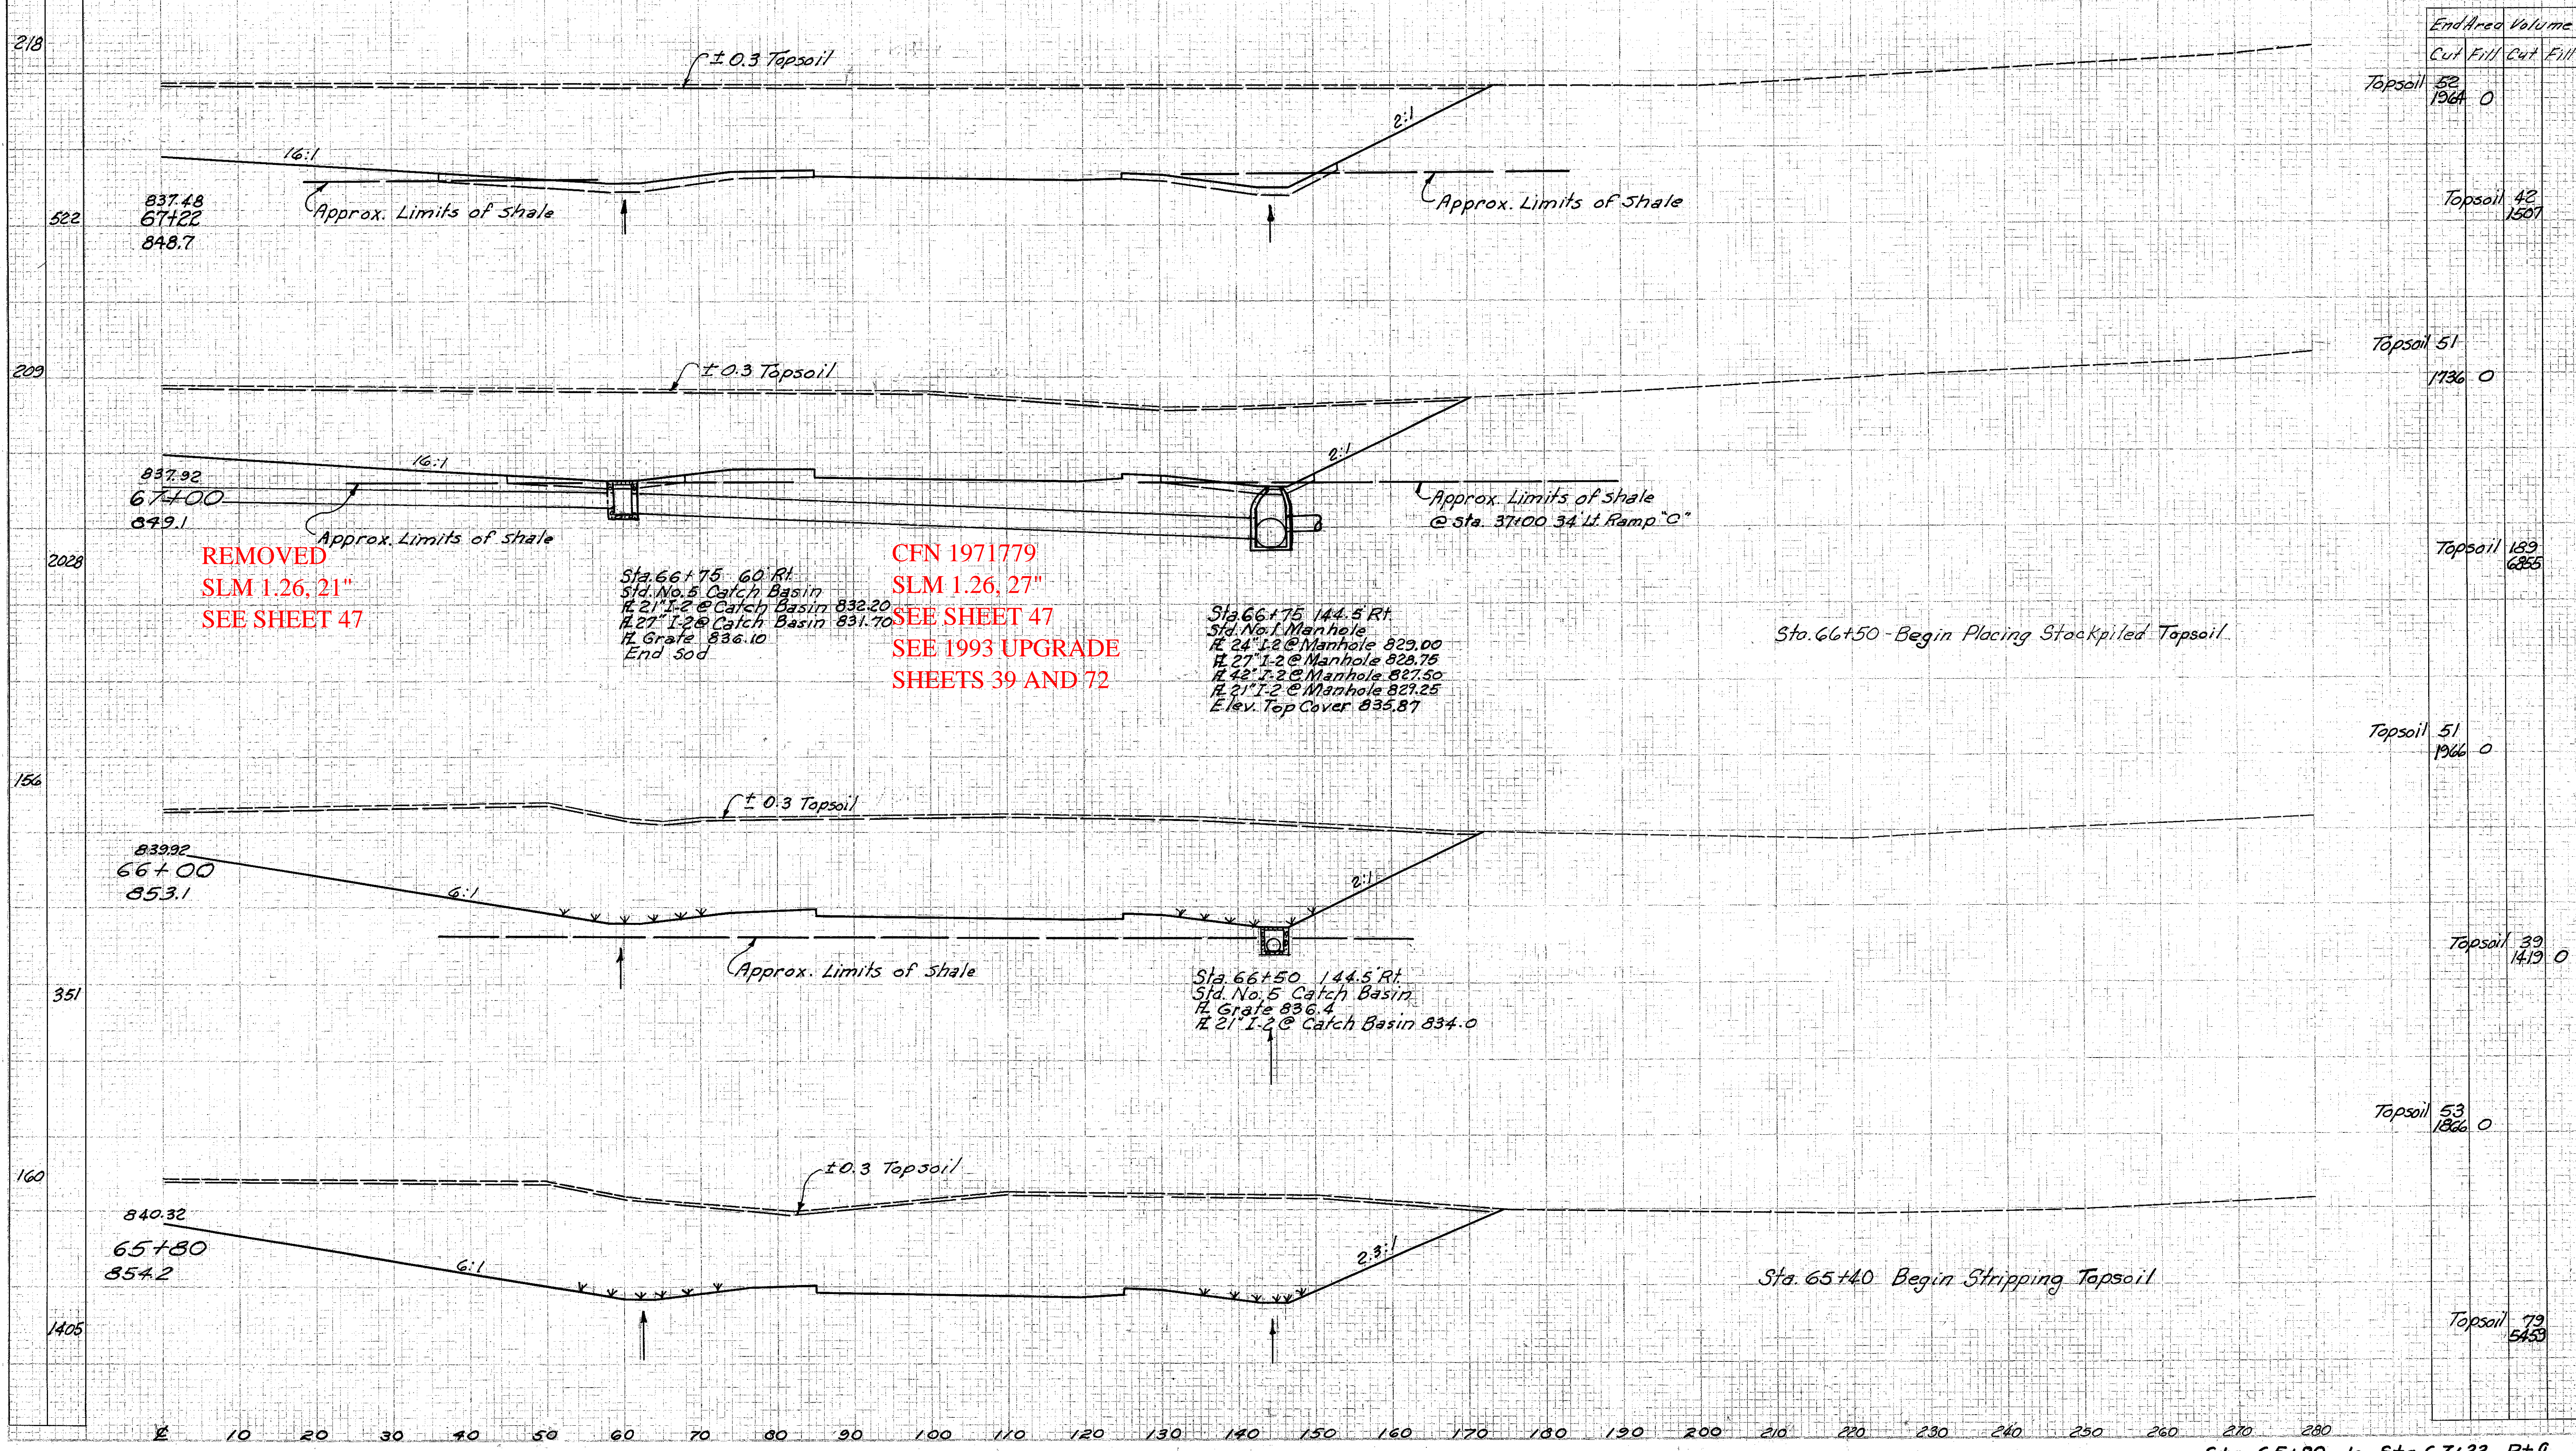

Station	End Area Volume	Cut	Fill	Cut	Fill	Topsoil
218	52	1964	0			
522	48	1507				
209	51	1136	0			
2028	139	6855				
186	51	1966	0			
351	39	1419	0			
160	53	1866	0			
1405	79	5453				

REMOVED
SLM 1.26, 21"
SEE SHEET 47

Sta. 66+75 60' Rt.
Std. No. 5 Catch Basin
R 21" I-2 @ Catch Basin 832.20
R 27" I-2 @ Catch Basin 831.70
R Grate 836.10
End Sod

CFN 1971779
SLM 1.26, 27"
SEE SHEET 47
SEE 1993 UPGRADE
SHEETS 39 AND 72

Sta. 66+75 144.5' Rt.
Std. No. 1 Manhole
R 24" I-2 @ Manhole 829.00
R 27" I-2 @ Manhole 828.75
R 42" I-2 @ Manhole 827.50
R 21" I-2 @ Manhole 827.25
Elev. Top Cover 835.87

Sta. 66+50 - Begin Placing Stockpiled Topsoil.

Sta. 65+40 - Begin Stripping Topsoil

Sta. 65+80 to Sta. 67+22 Rt. 2