SLM 16.65 BK=
SLM 0.00 AH

WHITE ROAD
SLM 0.02 = MM 38.49

SEE 1993 CUY/LAK-271/90/271X/90X-14.85/2.76/0.00/2.76
PLANS FOR MODIFICATIONS TO STORM SEWERS

CFN 1971756
SLM 0.17, 24"
SEE SHEET 121

FED. RD. DIVISION	STATE	PROJECT	
2	OHIO	I-1102 (6)	

41
458

CUYAHOGA & LAKE COUNTIES
CUY-I-15.91
LAK-I-0.00

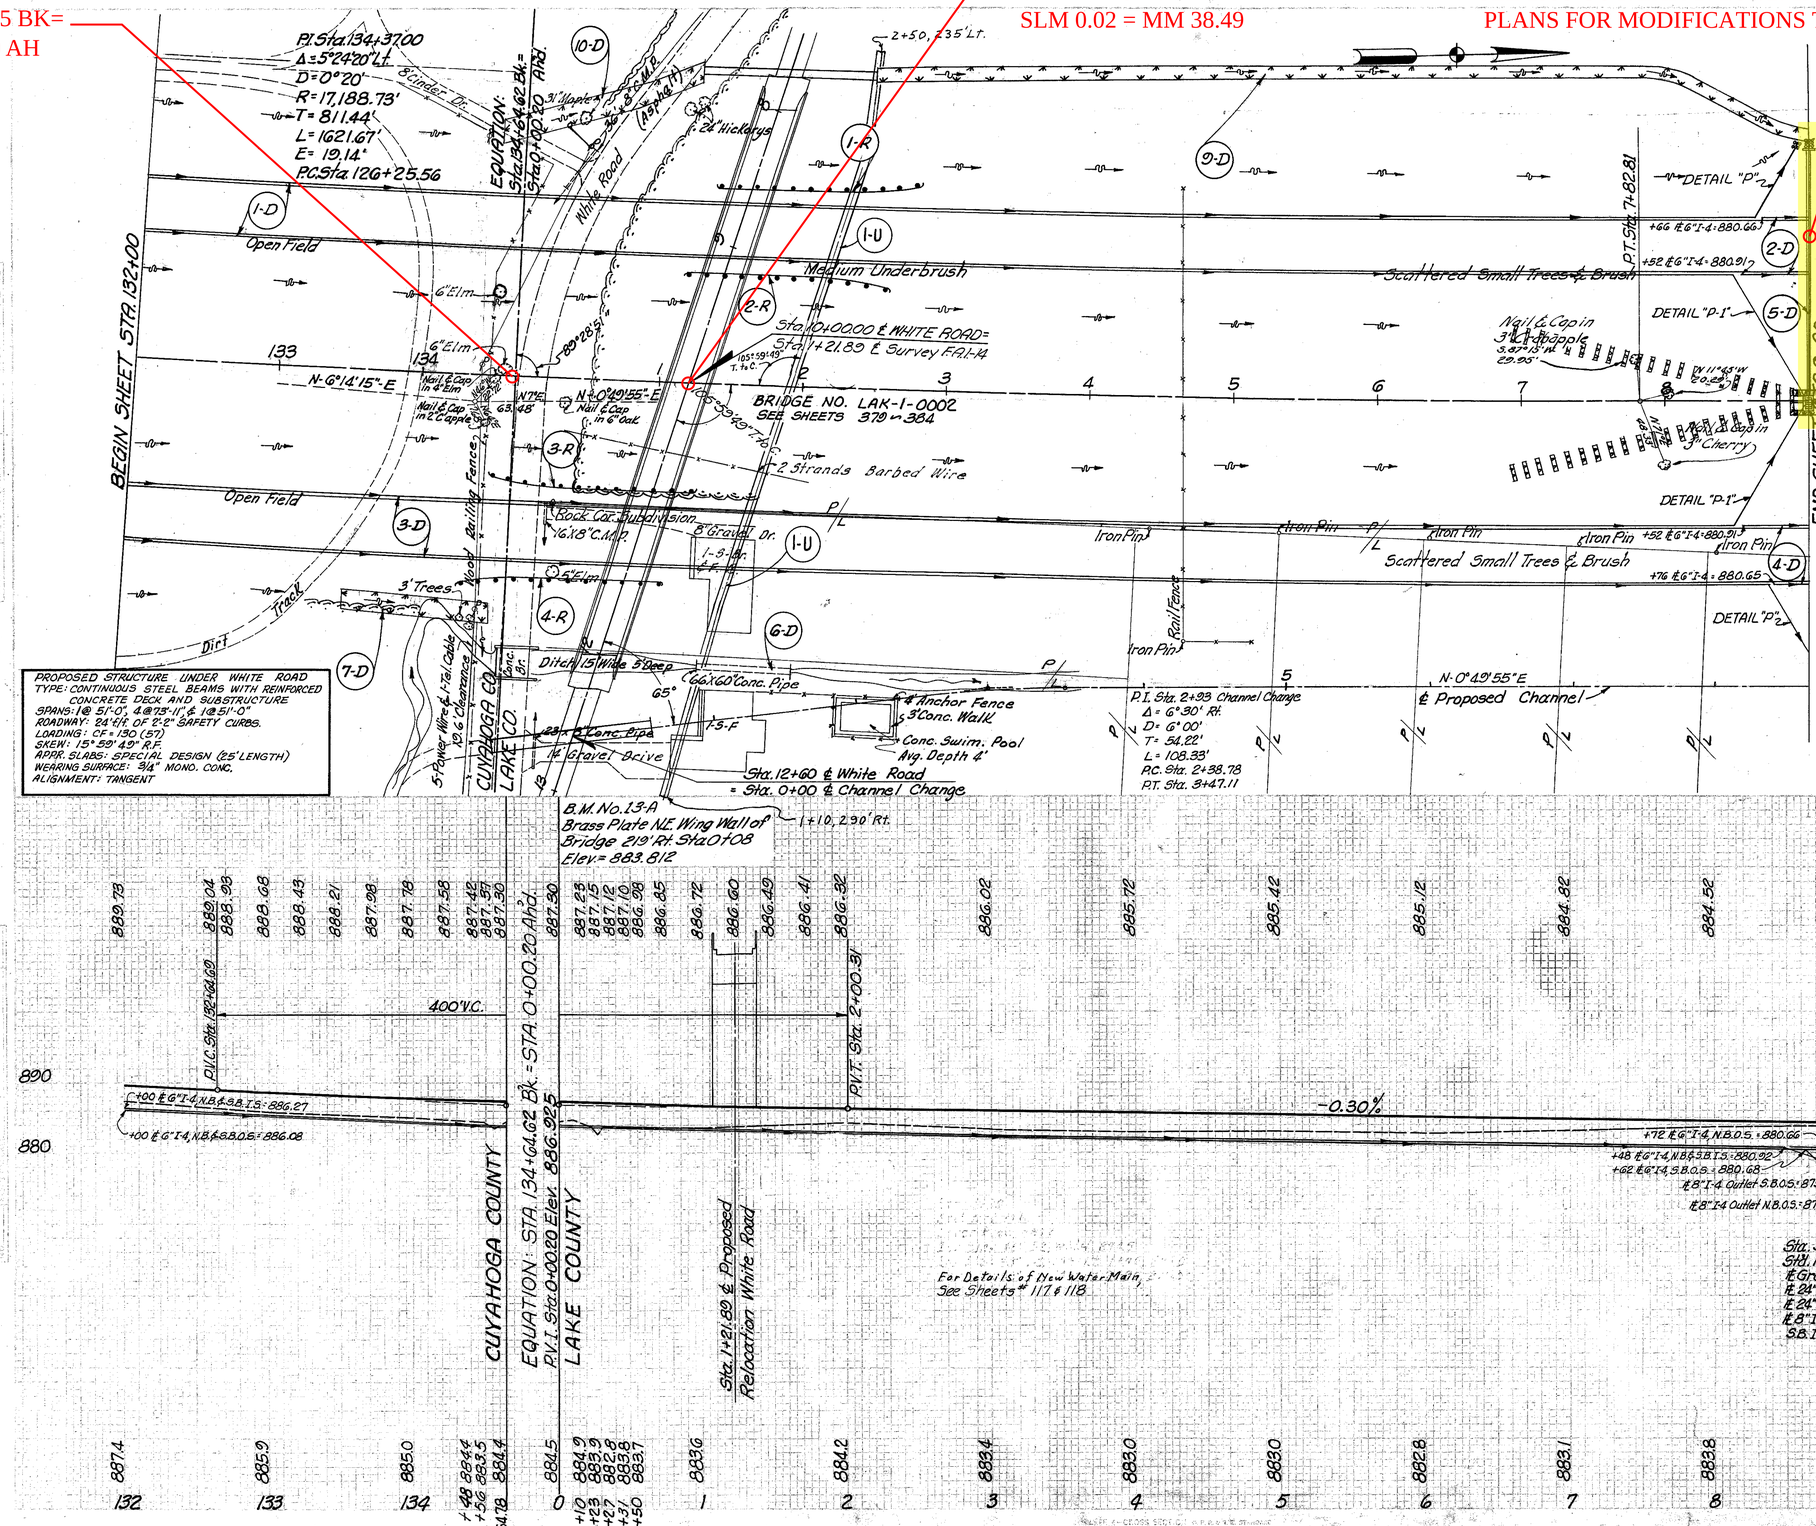

ROADWAY

Ref. No.	Side ℄	Station From	Station To	I-124.03 New 12" Water Main in Cast Iron, Lined, ASA Cl. 25 L.F.	New 12" Water Main in Extra Strong Wrought Iron Pipe, Galv. L.F.	I-15 Guard Rail Dwg. No. EA Lin. Ft.	I-124.03 12" Plugs Cl. 250 Cast Iron Each	12" Special Connections as per plan Each
1R	Lt.	1+38.60	2+77.25			137.50		
2-R	Lt.	1+18.25	2+56.32			137.50 *		
3-R	Rt.	134+53.02	1+25.53			137.50 *		
4-R	Rt.	134+33.23	1+05.18			137.50		
1-U	Rt. & Lt.	1+10	2+50	421 *	116 *		2 *	4 *
		Total		421	116	550.00	2	4

* No Federal Participation

DRAINAGE

See Sheet No.	Ref. No.	Station From	Station To	Side ℄	E-12 Excavation for Structures Cu. Yds.	E-12 Pipe Armored Over 18" L.F.	I-2 Class "A" Sidewalk under Pavement or Approaches Sec. M-6.01 & M-6.01 L.F.	I-2 Underdrain Shallow Ft.	I-4 Pipe Outlet for Underdrains Sec. M-6.4 (a)	I-5 Pipe Special for Underdrains Gal'vnd	I-8 Catch Basin Standard No. 4 Each	I-10 Dumped Rock Channel Protection Cu. Yds.	I-14 Paved Gutter Type 1 Modified 4'-6" L.F.	L-10 Sodding Sq. Yds.	S-1 Concrete for Structures Class "C" Cu. Yds.	S-4 Reinforcing Steel Lbs.	S-29 Drainage of Structures No. 2 Aggregate Cu. Yds.
345	1-D	132+00.00	9+00	Lt.					8"	6"		0.30					
	2-D	87+52	9+00	Lt.					20	2		0.30					
345	3-D	132+00.00	9+00	Rt.					20	2							
	4-D	87+52	9+00	Rt.					20	2							
121	5-D	9+00	11+50	Lt.			168	2370							5.4	2.18	
	6-D	1+50	1+84.50	Rt.		66		82			1	2		98			10.04
	7-D	1+37.50	Eliminated	Rt.				2374						133			
	8-D	1+34.50	11+25	Lt.				72						278			
	9-D	2+42	9+00	Lt.										585			
	10-D																
Totals:					6	66	168	4888	40	4	1	2		1004	5.4	2.18	0.60

MICHAEL BAKER, JR., CONSULTING ENGINEERS
ROCHESTER, PENNSYLVANIA

STATE OF OHIO
DEPARTMENT OF HIGHWAYS
STATE HIGHWAY NO. I
C- 41
PLAN AND PROFILE
STA. 132+00 TO STA. 9+00

Designed	Drawn	Traced	Checked	Reviewed Date	Revised
B.P.	H.G.	K.G.	L.I.		11-24-61 11-15-60 REC

REVISIONS:
3-31-60 Grade Raise for 16'-4" Br. Cl.

PLAN & PROFILE STA. 132+00 TO STA. 9+00