SEEDING	
END WIDTH	SQ. YDS.

280 260 240 220 200 180 160 140 120 100 80 60 40 20 ℄

FED. ROAD DESIGNATION	STATE	NUMBER	
2	OHIO		

128
306

LAKE COUNTY
LAK-I-10.38

END AREA		CU. YDS.	
Cut	Fill	Cut	Fill

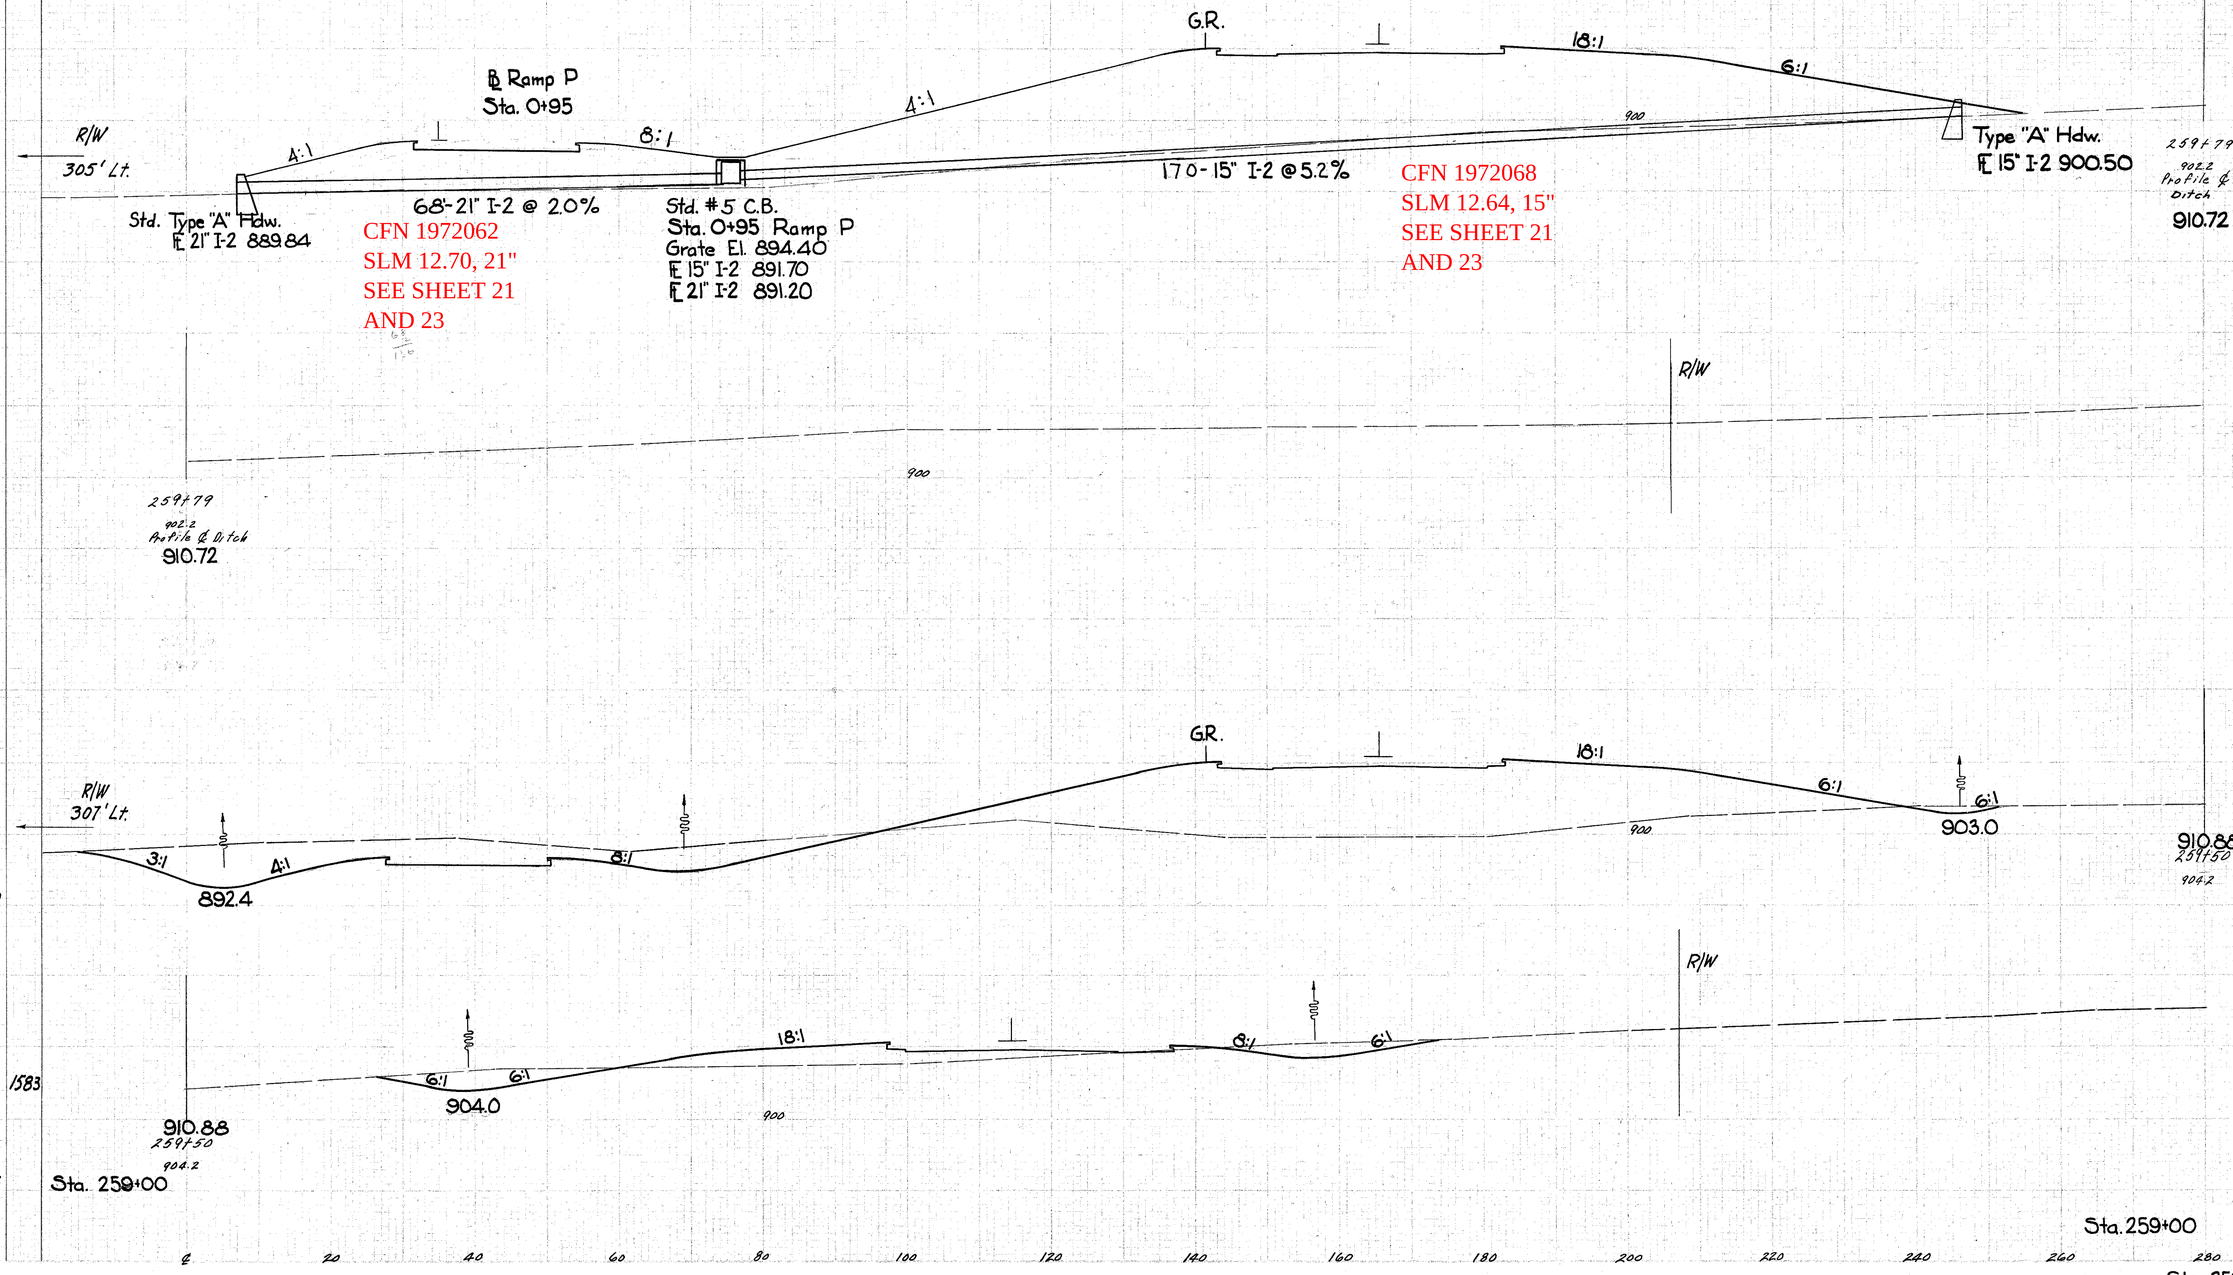

℄ 20 40 60 80 100 120 140 160 180 200 220 240 260 280

Sta. 259+50 to 259+79